

— SITE PLAN —
FOR

DENNIS STOCKEY

BEING SUBLOT 57 IN THE SIERRA
SUBDIVISION, RECORDED IN PLAT VOL. 1
PAGE 4, OF THE LAKE COUNTY RECORD
OF PLATS, LAKE COUNTY, STATE OF OHIO.


SCALE: 1" = 20'

EXIST
FOR
EAST

Grading Plan Approved
as shown and/or noted
by THOMAS P. GILLES, P.E.
Lake County Engineer
Date 4-11-89

BRIDLE PATH DRIVE

60'

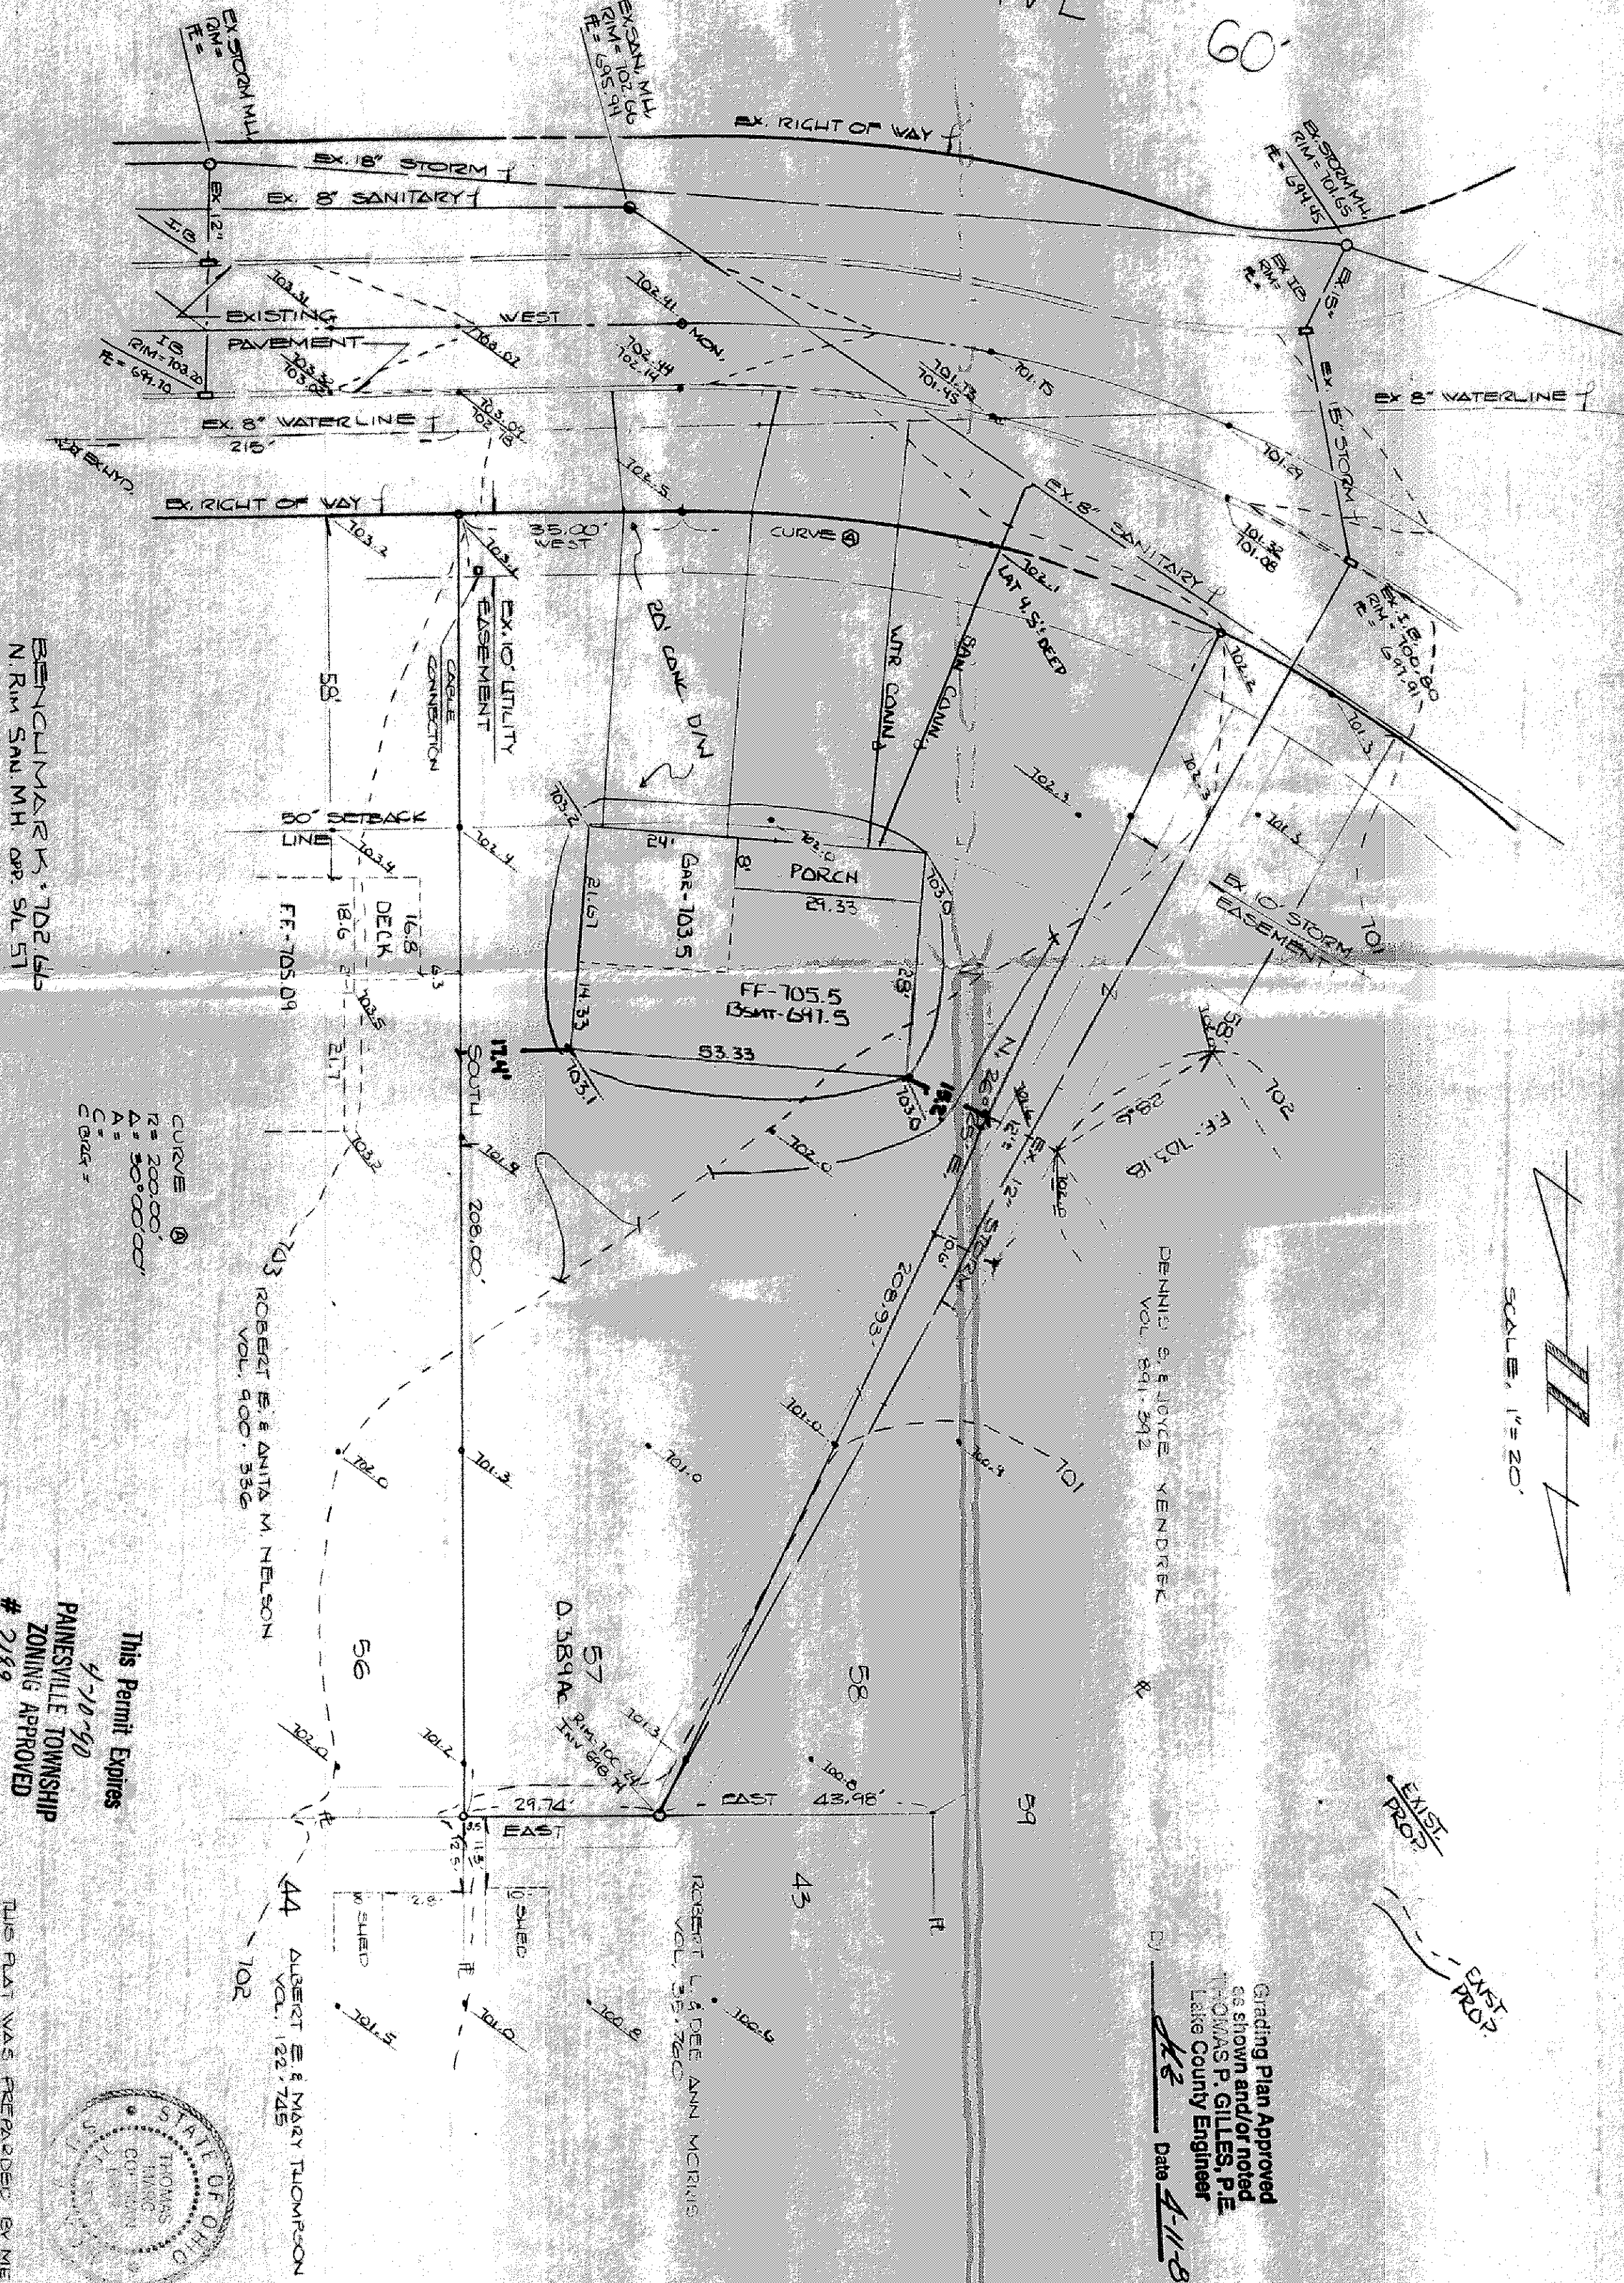

BENCHMARK 102.65
N. RIM SAN. M.H. DR. S.W. 51

CURVE
R = 200.00'
L = 200.00'
A = 90.00000°
C = 100.00000'

This Permit Expires
4-10-90
PAINESVILLE TOWNSHIP
ZONING APPROVED
2189
Lester E. McManus
Zoning Inspector 4/11/89

THIS PLAT WAS PREPARED BY ME AND
IS CORRECT TO THE BEST OF MY
KNOWLEDGE AND BELIEF
Thomas M. Coffey, P.E.
Professional Engineer

