


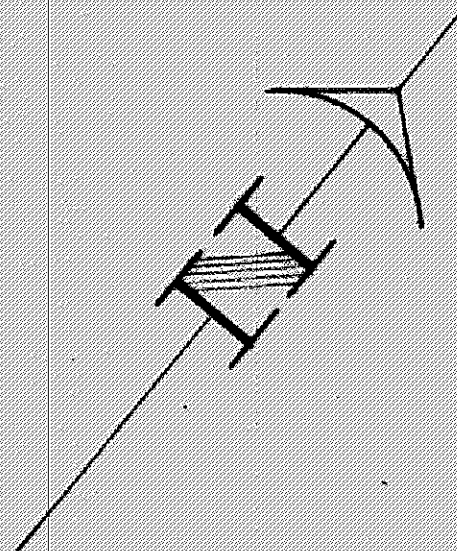

SITE PLAN FOR:

MANUEL GOODSON
428 ABELS AVE.
PAINESVILLE TWP., OHIO

BEING SUBLLOT 13 & HALF OF SUBLLOT 14 & SUBLLOT 15 AND THE REMAINING HALF OF SUBLLOT 14 IN BLOCK No. 121 IN G.E. MEIGS RESURVEY OF PART OF ORIGINAL PAINESVILLE TWP. LOTS No. 19, 20 & 21, TRACT 4 AND PART OF ORIGINAL TOWN OF RICHMOND IN LOTS No. 21 & 22 AS SHOWN BY THE RECORDED PLAT OF SAID RESURVEY IN VOLUME "A", PAGE 37 OF LAKE COUNTY RECORDS.

PREPARED BY:

WM. R. GRAY ASSOC. INC.
7547 MENTOR AVE.
MENTOR, OHIO

DATE: JUNE 17, 1976 SCALE: 1"=20'

CERTIFICATION:

I HEREBY CERTIFY THAT THIS PLAT IS
CORRECT TO THE BEST OF MY KNOWLEDGE

By: Wm. R. Gray

WM. R. GRAY R. S. # 2752

PAINESVILLE TOWNSHIP
ZONING APPROVED
#3906 & 3907

W. A. Henderson
Zoning Inspector

SAN. M.H. (J.B.M.)
ASSUMED RM: 100.00' INV: 81.25

CATCH BASIN
RM: 98.02 INV: 96.02

Grading Plan Approved
as shown and/or
THOMAS B. CLARK
Lake County Engr.

By: JWK 6-21-76

