

SCALE 1"=20'

SITE PLAN
FOR
DICK REED


KNOWN AS BEING SUBJECT NO. 6 IN THE
HEATHERSTONE VILLAGE SUBDIVISION, AS
RECORDED IN PLAT VOL. 836 PAGE 372, IN
PAINESVILLE TOWNSHIP LAKE COUNTY, OHIO.

P.F.N.G. 11A-018-C-00-006-0

BENCHMARK - 124.87
N RIM SAN MH @
S E CORNER S/L 6

EXISTING ELEVATION
PROPOSED ELEVATION

Grading Plan Approved
as shown and/or noted
THOMAS P. GILLES, P.E.
Lake County Engineer
By *TPG* Date *4-2-89*

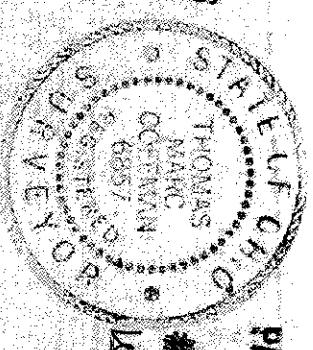

This Permit Expires
4-24-90
PAINESVILLE TOWNSHIP
ZONING APPROVED
7200
William E. McNamee
Zoning Inspector 4/24/89

VILLAGE SURVEYING CO.
202 THIRD ST. FAIRPORT HBR. OHIO 44017
(216) 357-1359

THIS PLAT WAS PREPARED BY ME AND
IS ACCURATE TO THE BEST OF MY
KNOWLEDGE AND BELIEF.

Thomas M. Gilles, P.E.