



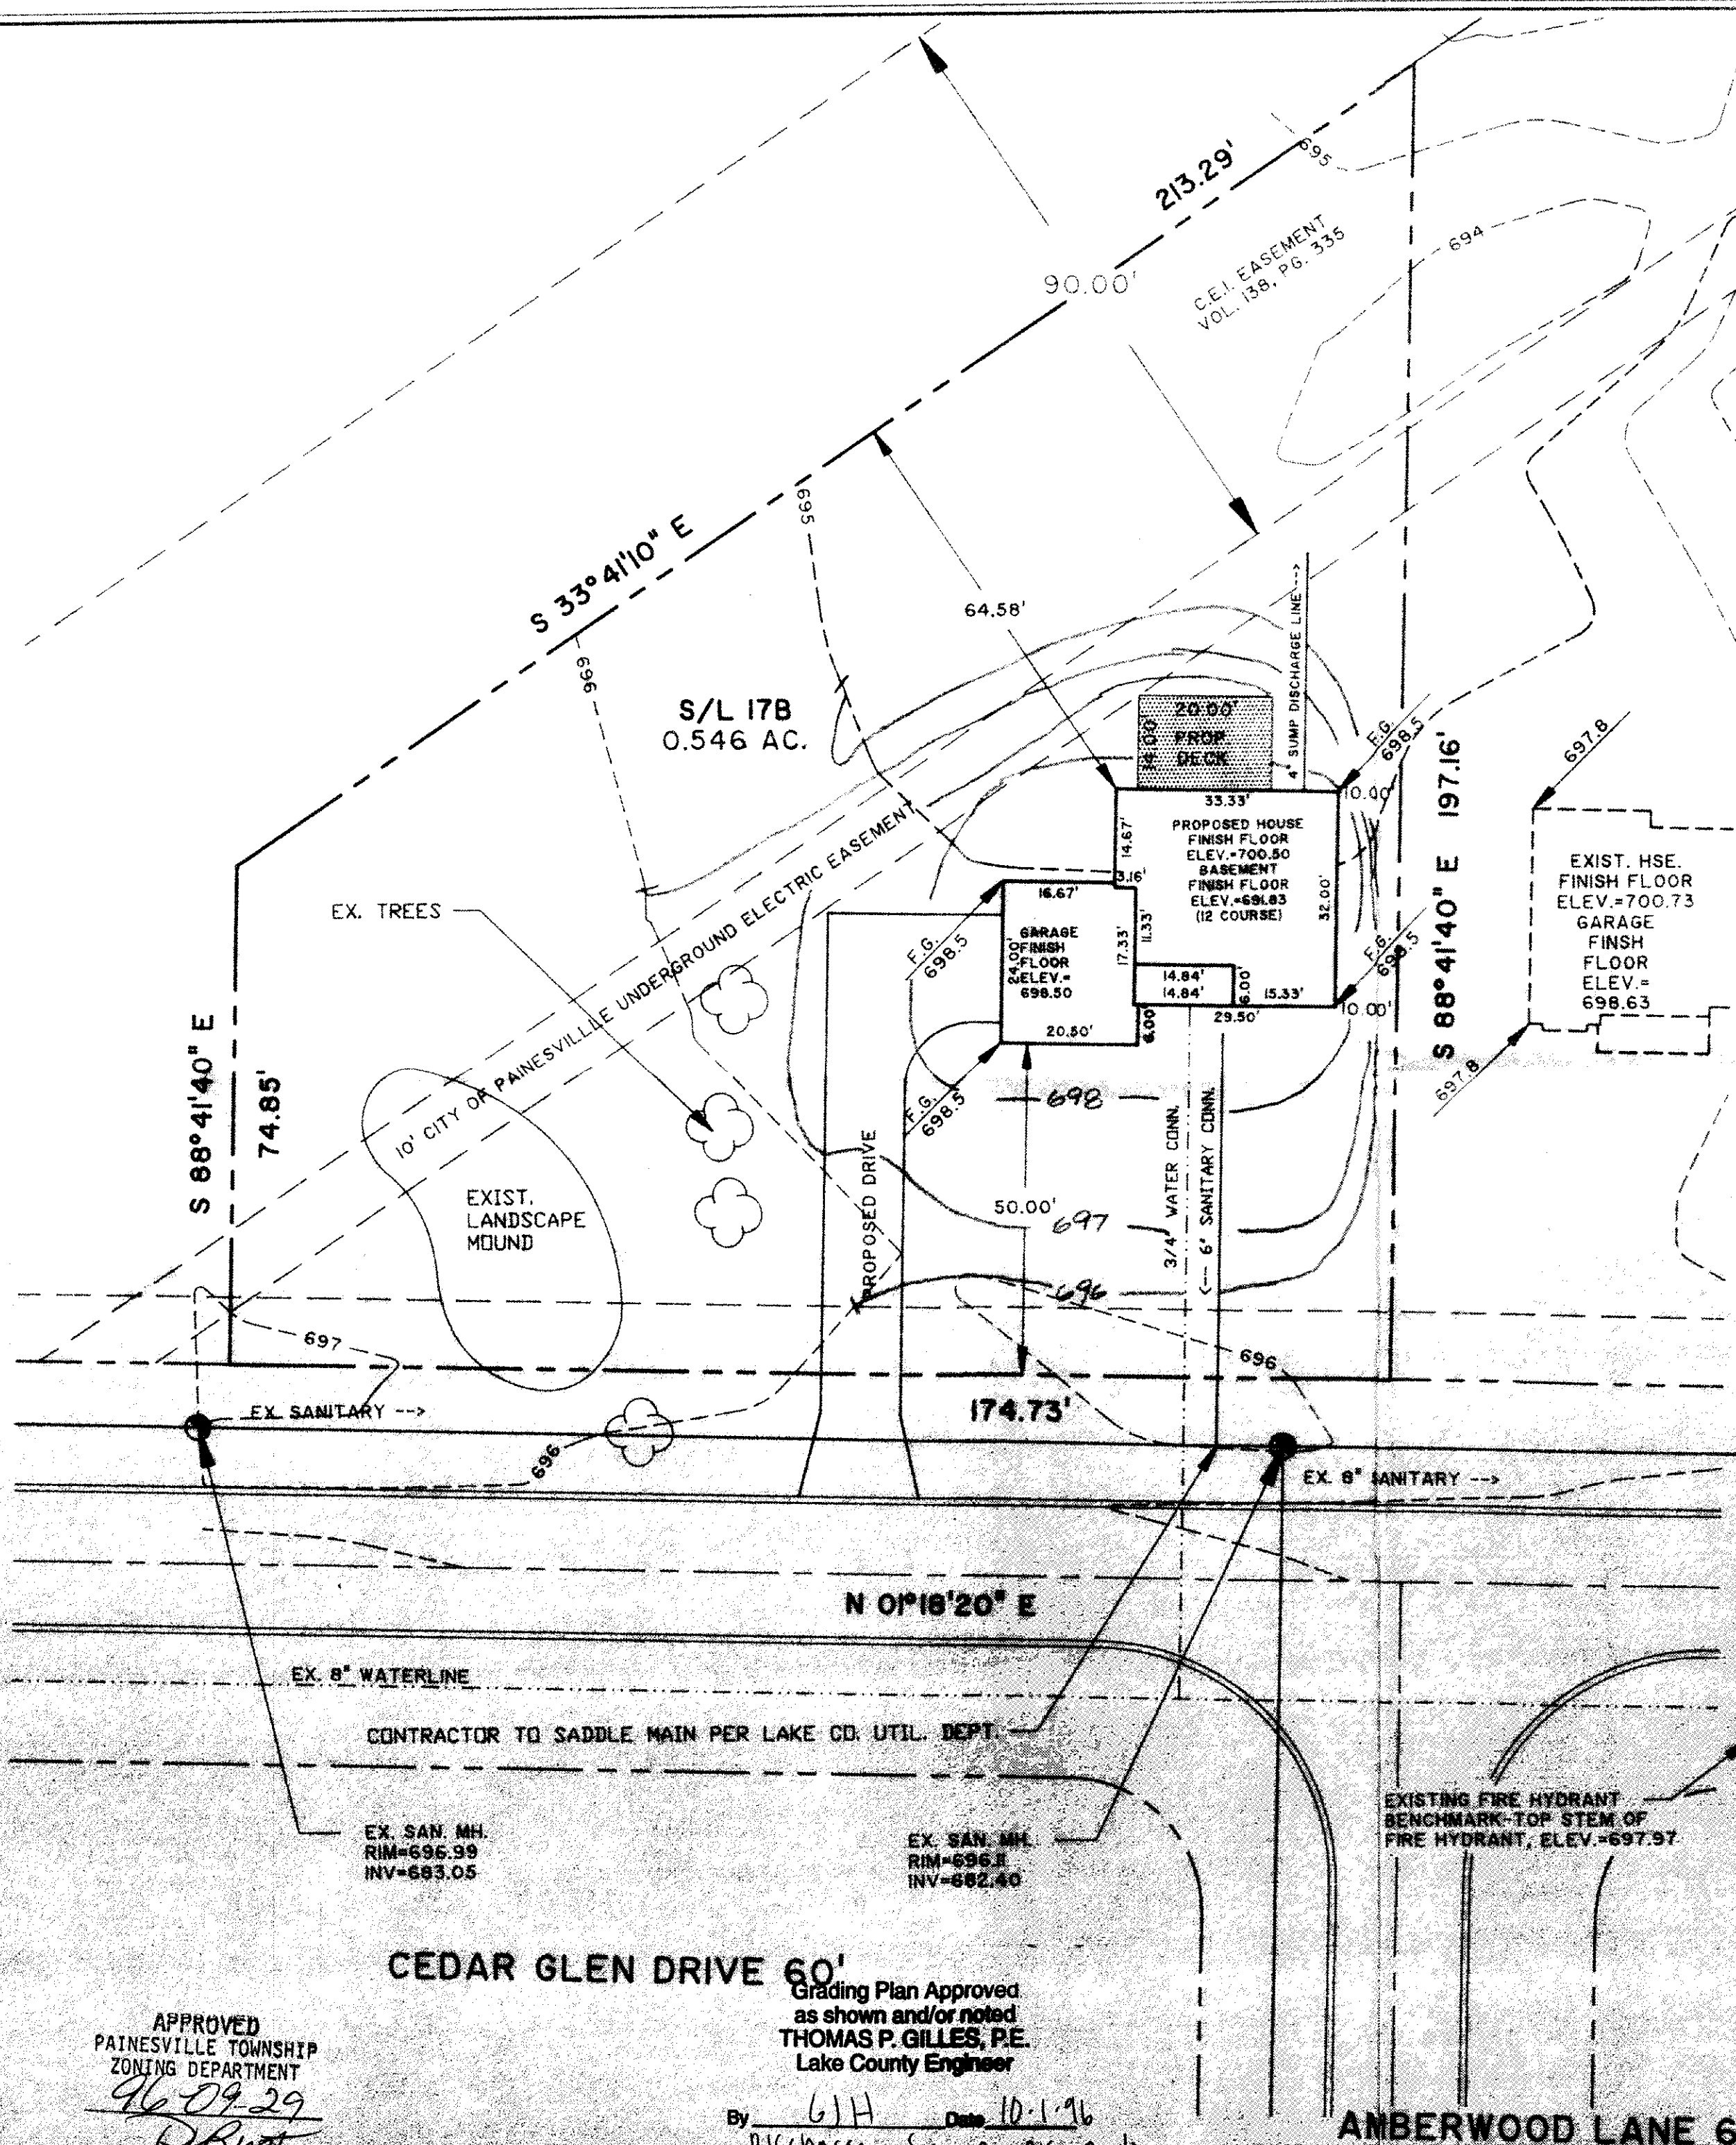

GRAPHIC SCALE

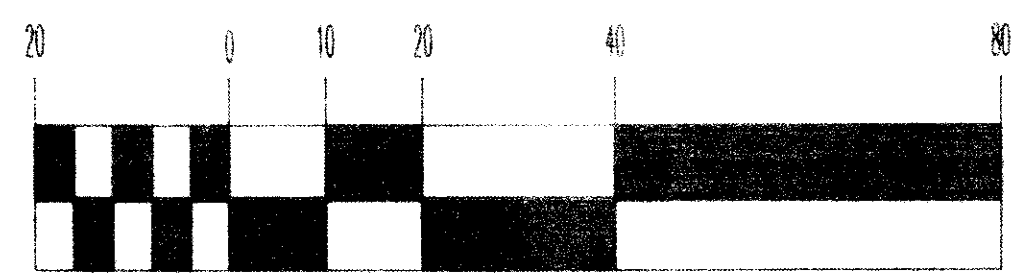

(IN FEET)

1 inch = 20 ft.

S/L 17A

GENERAL NOTES:

- 1. DRIVEWAY APRON TO BE 6" THICK
- 2. BENCHMARK - TOP STEM OF FIRE HYDRANT LOCATED IN FRONT OF SUBLOT No. 31, ELEV.= 697.97

LEGEND

- EXISTING CONTOUR
- PROPOSED CONTOUR
- EXISTING ELEVATION
- PROPOSED ELEVATION



CERTIFICATION

"I THE UNDERSIGNED HEREBY CERTIFY THAT THIS TOPOGRAPHY INDICATED BY 'I' CONTOURS AND ELEVATIONS SHOWN HEREON REPRESENTS AN ACTUAL SURVEY MADE BY ME ON THE 8th DAY OF AUG. , 1996 AND THE ELEVATIONS WERE TAKEN AT APPROPRIATE INTERVALS AND AS OF THAT DAY THEY EXISTED AS INDICATED HEREON.

"I HEREBY CERTIFY THAT THIS PLAN WAS PREPARED BY ME AND IS CORRECT TO THE BEST OF MY KNOWLEDGE"

DAVID W. NOVAK, P.S. No. 7507

PREPARED BY:

Himebaugh and Novak
Surveyors and Site Consultants
8663 Tyler Boulevard
Mentor, Ohio 44060-4346
(216) 974-7670, (216) 255-5900 FAX.

SITE PLAN: SUBLOT No. 17B, CEDAR GLEN DRIVE 60', PAINSVILLE TWP. CEDAR GLEN SUBDIVISION No. 2, VOL. 16, PG. 38, L.C.R.P.
PREPARED FOR: LITTLE MOUNTAIN HOMES, INC.
SCALE: 1" = 20'
DATE: AUGUST 14, 1996
DRAWN BY: DAVID W. NOVAK

APPROVED
PAINSVILLE TOWNSHIP
ZONING DEPARTMENT
960929
DRW

Grading Plan Approved
as shown and/or noted
THOMAS P. GILLES, P.E.
Lake County Engineer

By GJH Date 10-1-96
Discharge Sump pump to
Stm. Sewer or defined channel

AMBERWOOD LANE 60'

96003-17B

REF 4 94012