OFFICE: 354-4100 RES.: 354-8908

JOSEPH D. HADDEN

Registered Surveyor

130 E. JACKSON STREET
PAINESVILLE, OHIO 44077

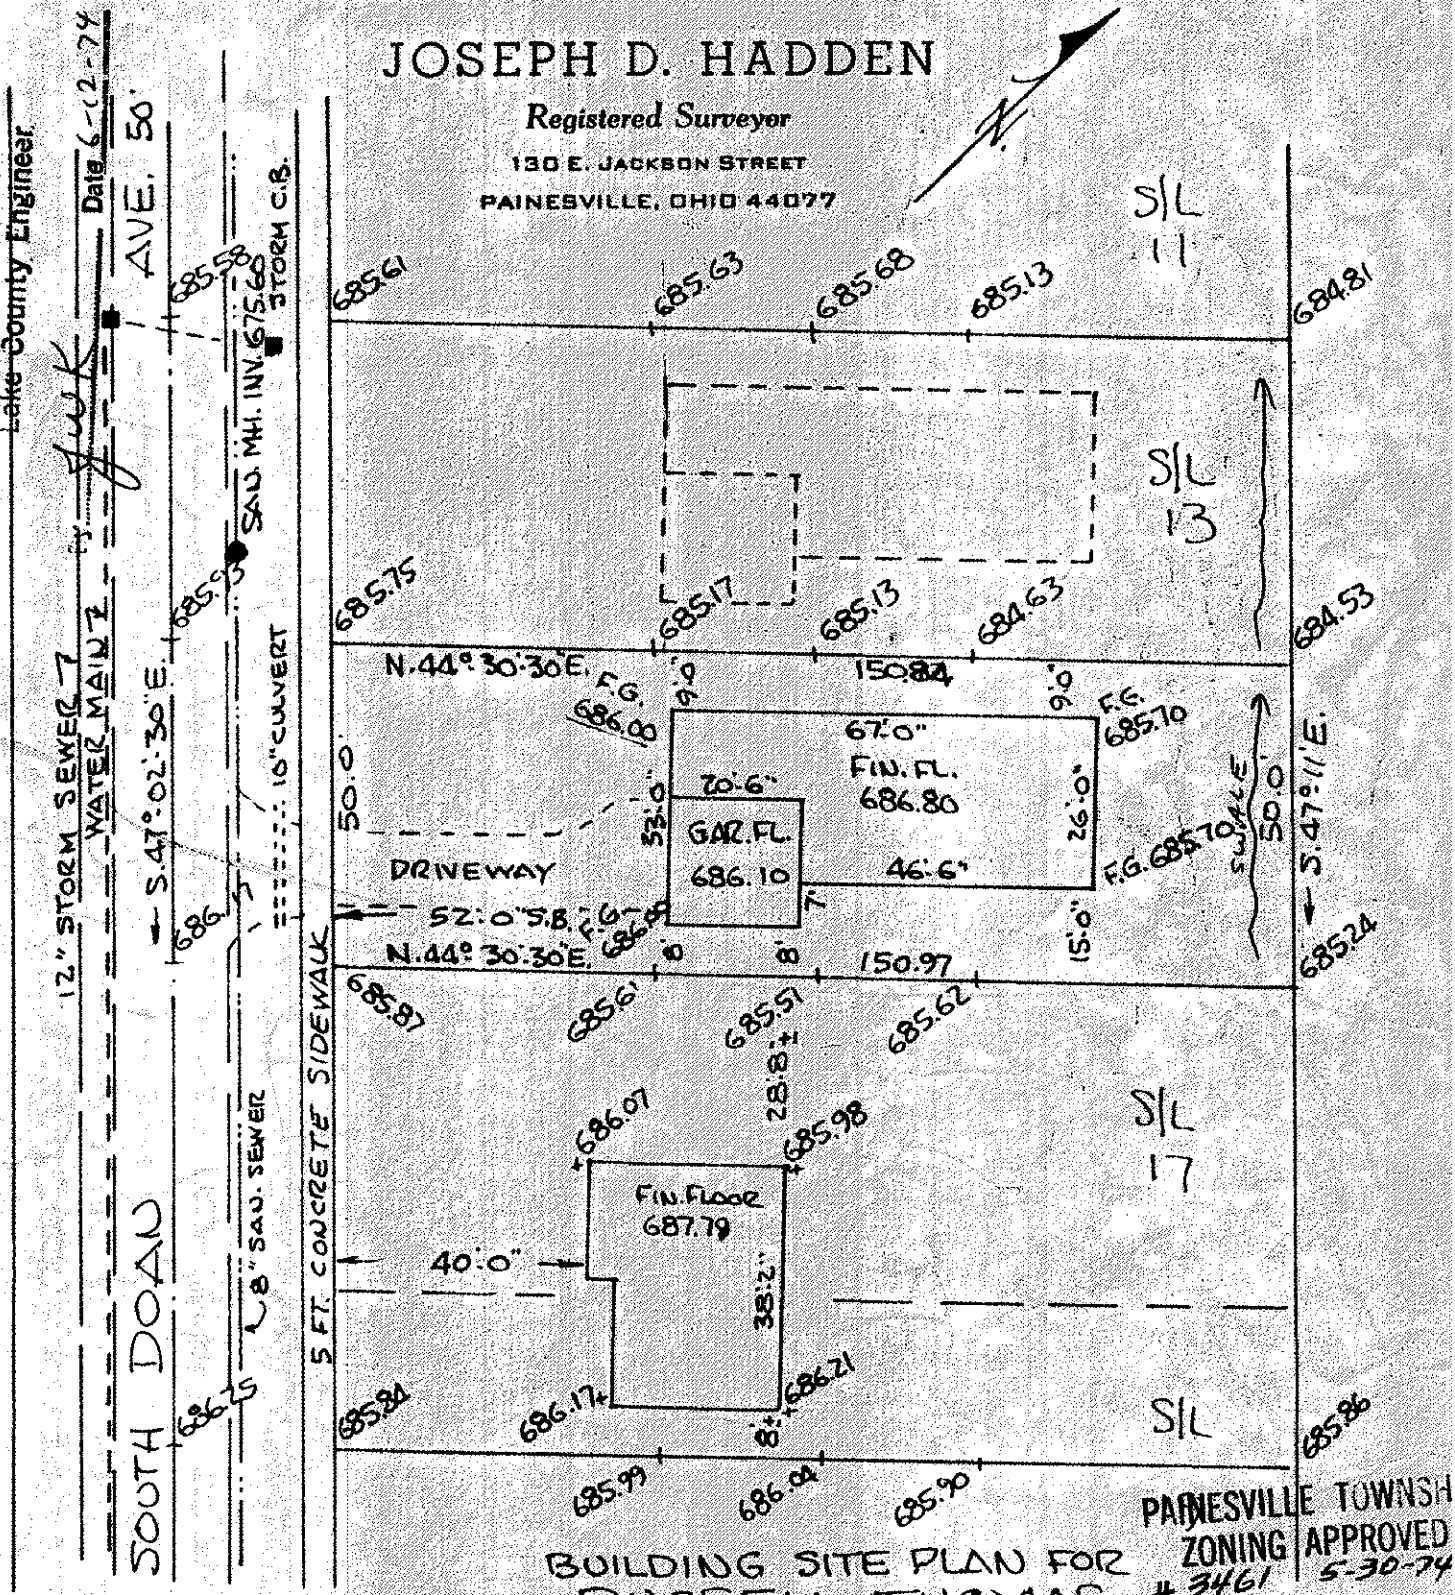

PAINESVILLE TOWNSHIP
ZONING APPROVED
5-30-74
#3461
Zoning Inspector

BUILDING SITE PLAN FOR
RUSSELL THOMAS
SUBLOT No. 15 - STANLEY ROAD ALLOT.
PAINESVILLE TOWNSHIP - LAKE COUNTY
Scale 1" = 30'
May 29. 1974
Joseph D. Hadden - Reg. Surveyor

STATE OF OHIO
JOSEPH D. HADDEN
4394
REGISTERED SURVEYOR