



SCALE: 1" = 20'

BEARINGS SHOWN HEREON ARE TO AN ASSUMED MERIDIAN AND ARE USED TO DEFINE ANGLES ONLY

EXISTING
PROPOSED

BENCHMARK-708.89
SANITARY MANHOLE RIM

WESTFIELD
CIRCLE 60'

DARTMOUTH DRIVE 60'

SITE PLAN

— FOR —

SANDY PAPPALARDO

KNOWN AS BEING SUBLOT NO. 142 IN THE HEATHERSTONE VILLAGE SUBDIVISION NO. 1, BEING A PART OF ORIGINAL LOT NOS. 21, 28, AND 29 IN TRACT NO. 1, SITUATED IN THE TOWNSHIP OF FAIRBANKS, COUNTY OF LAKE AND STATE OF OHIO.

* TRENCH DEPTH TO BE CONNECTED TO 33" STORM CHECK VALVE TO BE PROVIDED

EXISTING GRADE

PROFILE

SCALE: 1" = 2' VERT.
1" = 20' HORIZ.

Grading Plan Approved
as shown and/or noted
THOMAS P. GILLES, P.E.
Lake County Engineer

By: *THP* Date: 12/1/88

2P# 6925


CONNECTION TO BE
CONCRETE COLLARED

EL. 702.74

55

4.26'

NOTE:
PUMP TO BE CONNECTED
TO STORM

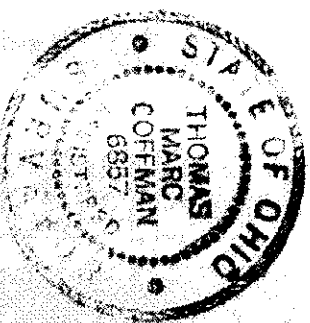

THIS PLAN WAS PREPARED BY ME AND IS TRUE AND ACCURATE TO THE BEST OF MY KNOWLEDGE AND BELIEF.

