TOPOGRAPHIC SURVEY AND LOT IMPROVEMENT PLAN

PREPARED FOR

STEVE BIDDELL

TOWNSHIP ____ OF PAINESVILLE
COUNTY OF LAKE, OHIO
BEING S/L 19 OF DOAN AVE ALLOTMENT
DEED: VOLUME F PAGE 72

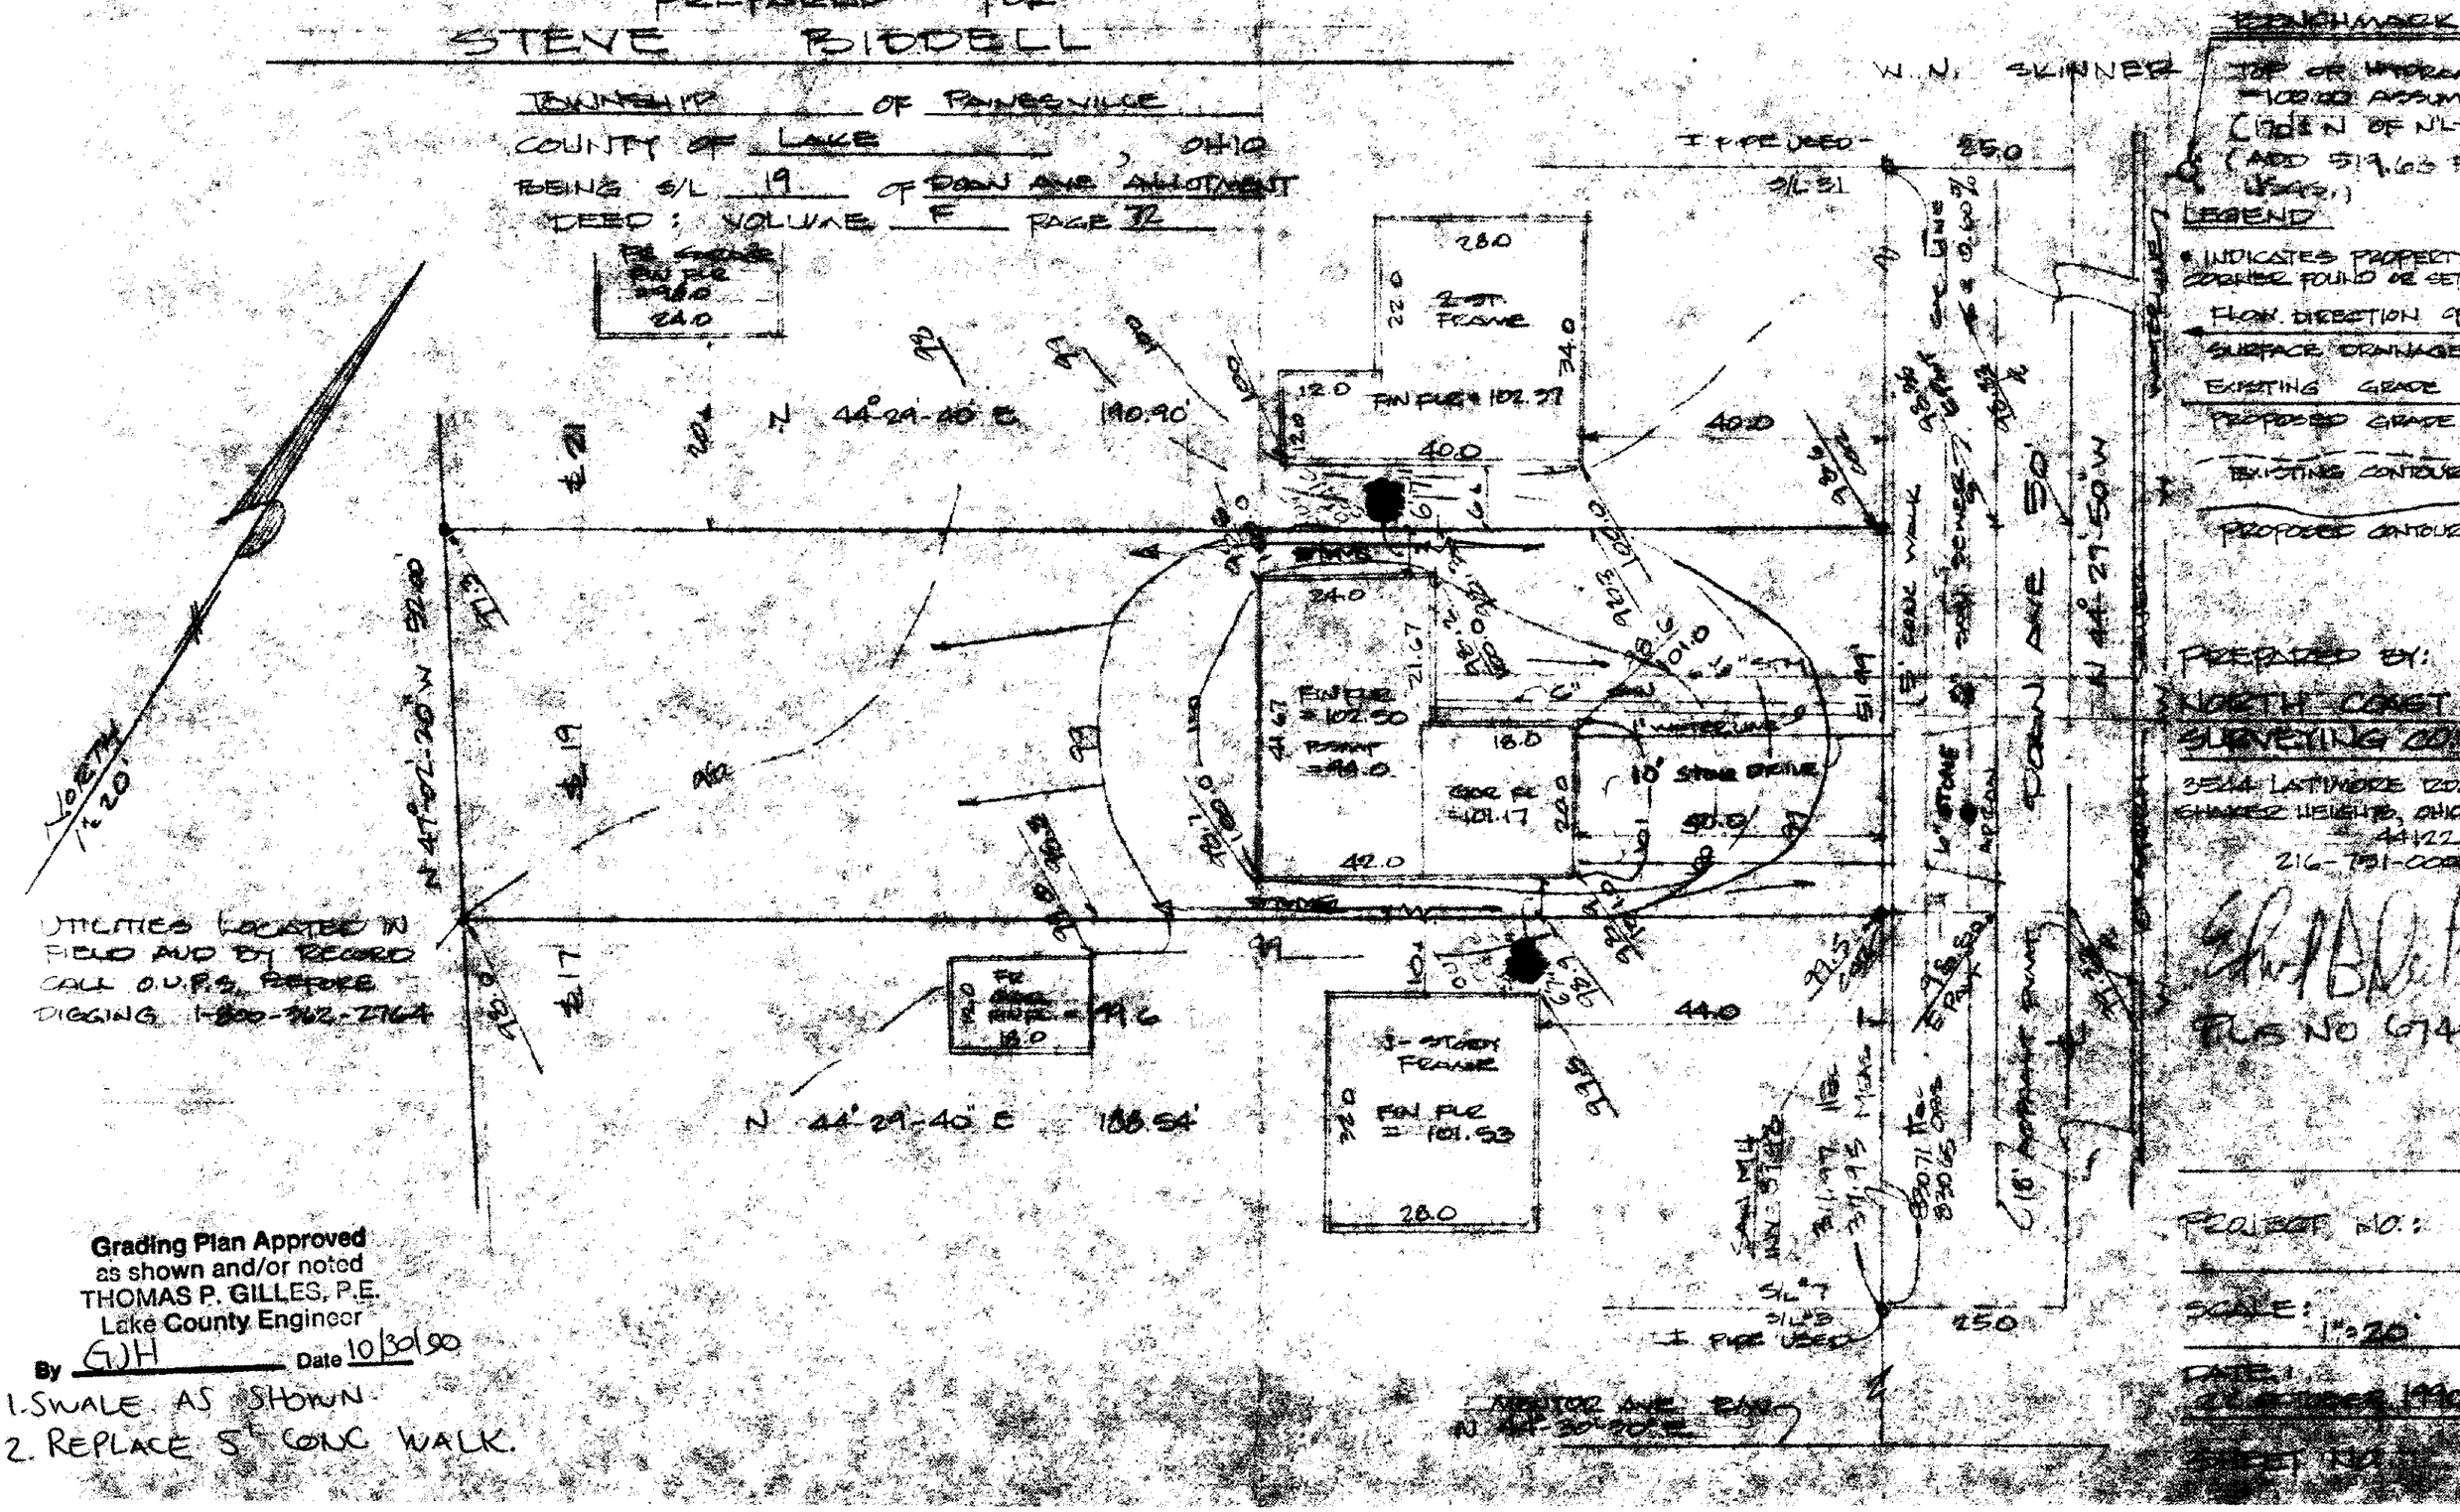

Grading Plan Approved
as shown and/or noted
THOMAS P. GILLES, P.E.
Lake County Engineer
By GJH Date 10/30/90

1. SWALE AS SHOWN
2. REPLACE 5' CONC WALK.