


FAIRGROUNDS ROAD 60'

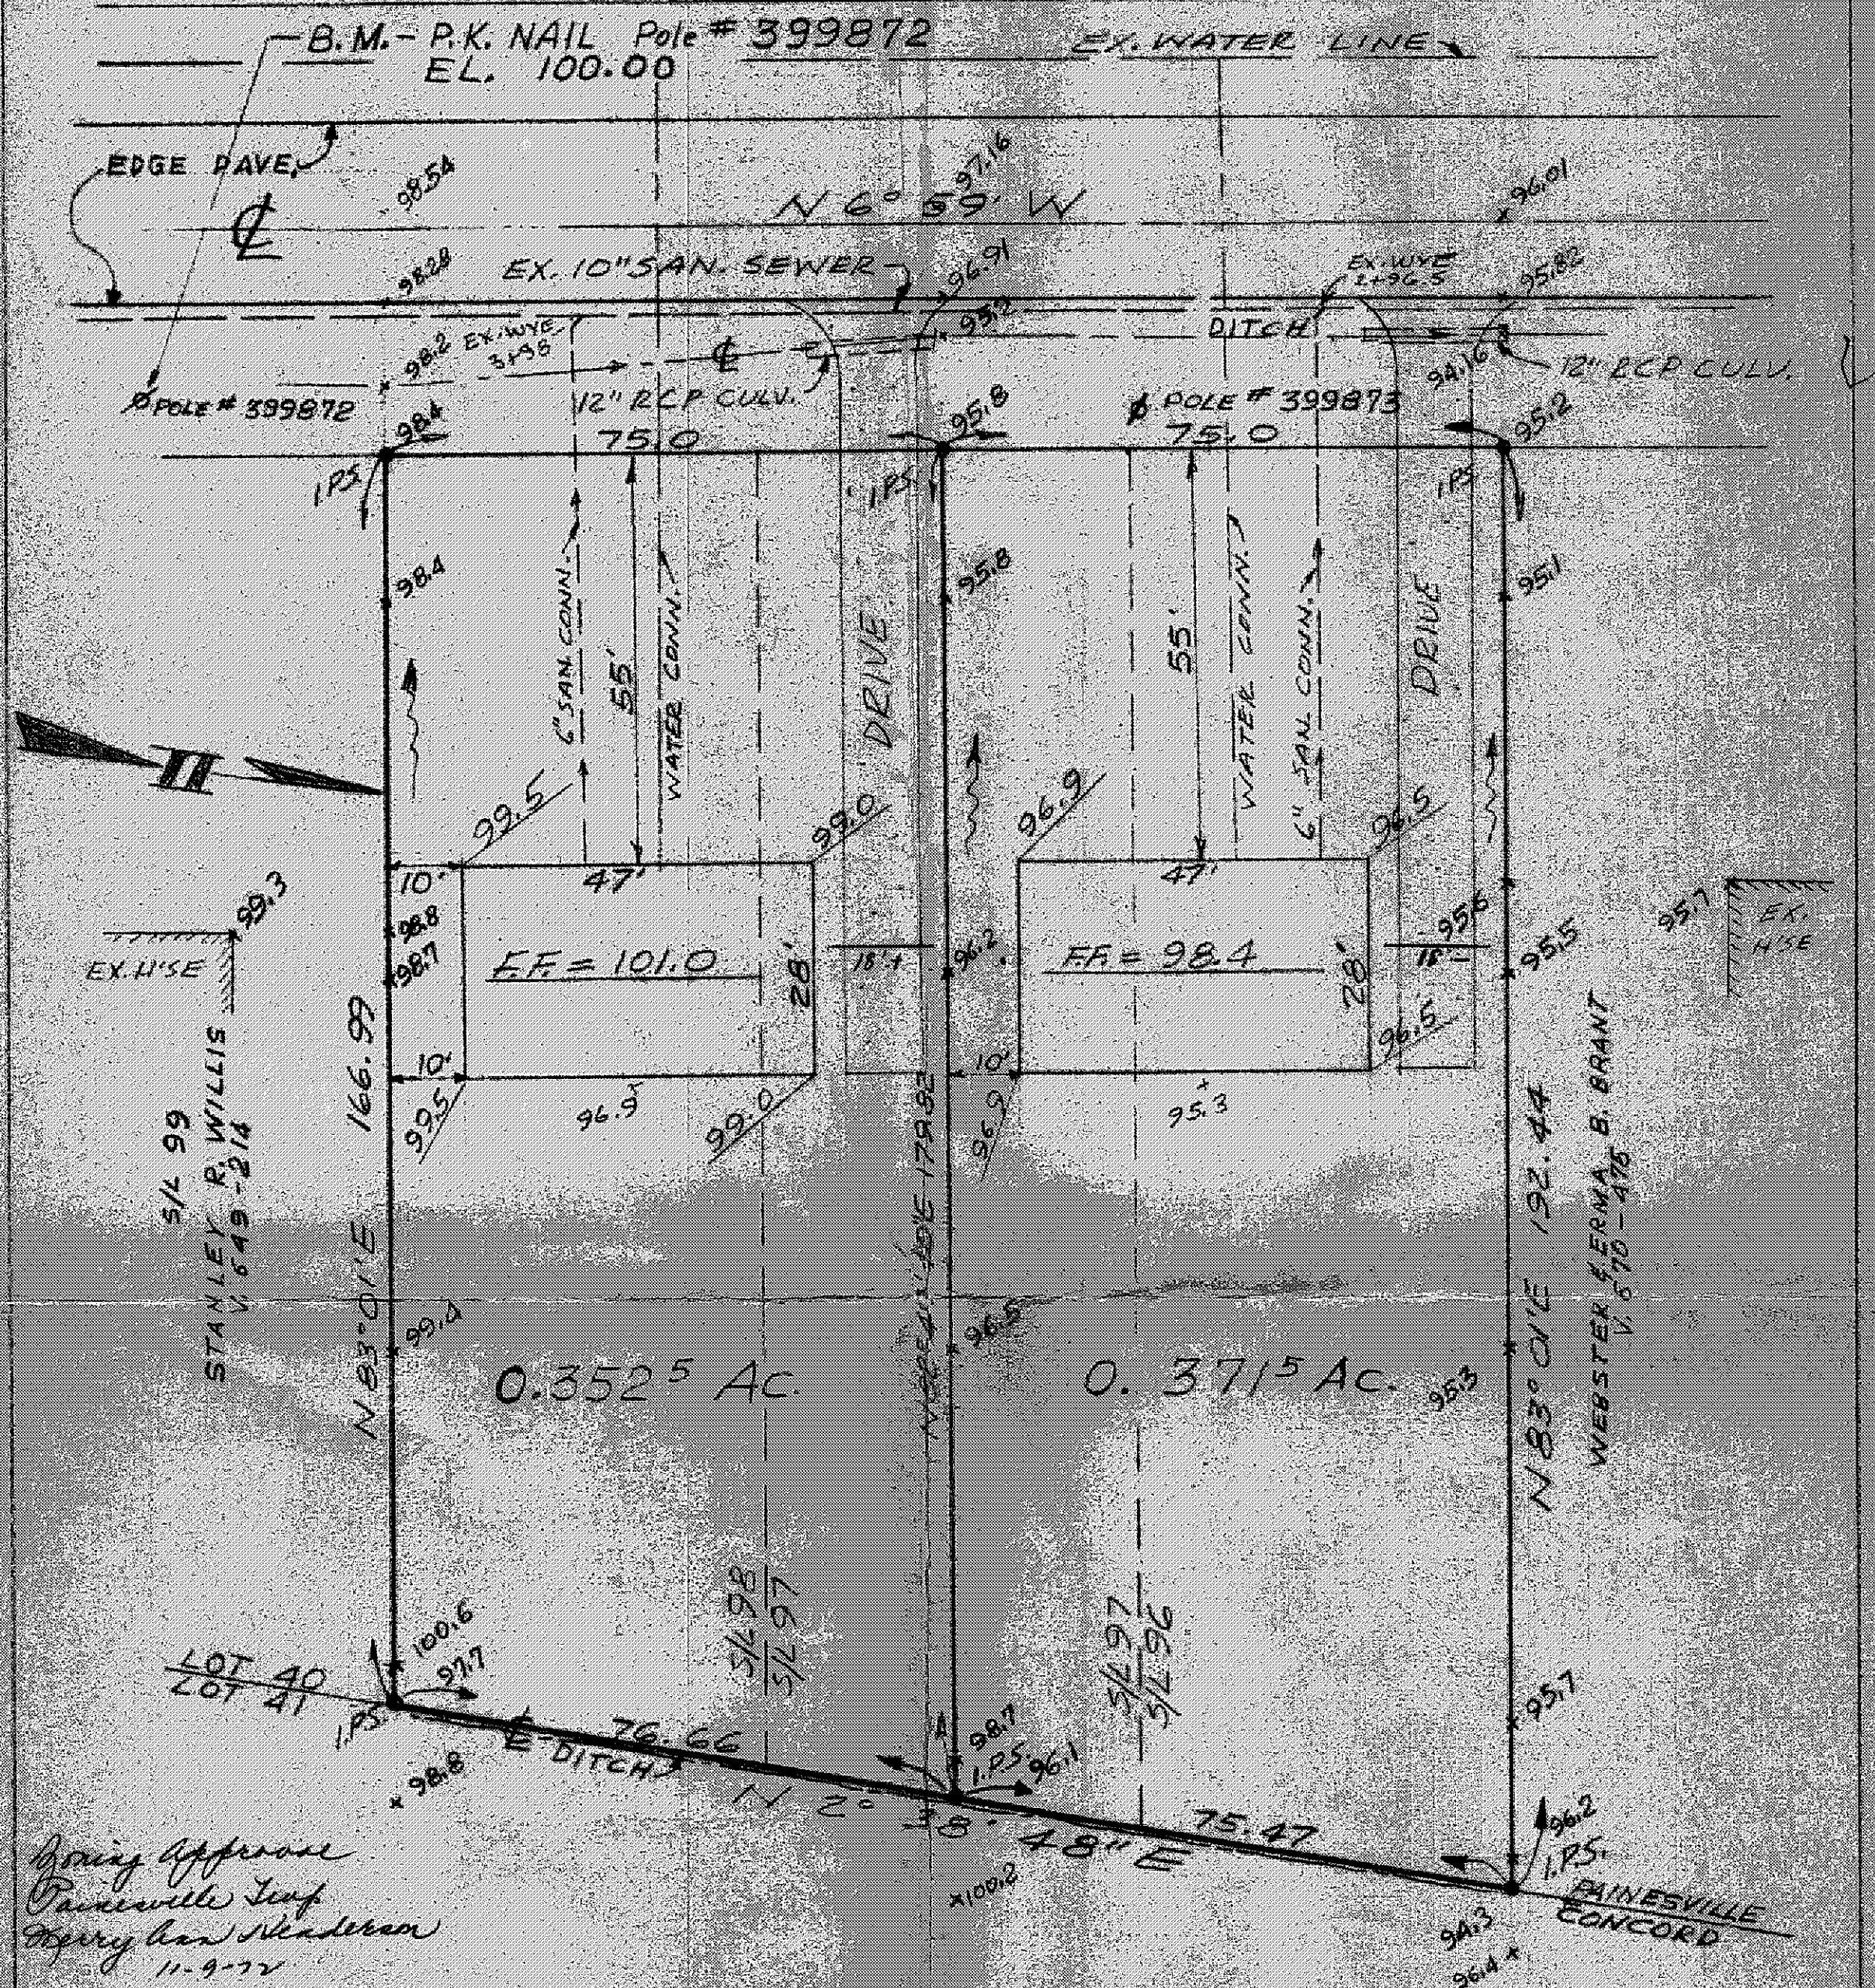

Grading Approved
Painesville Twp
By: [Signature]
11-9-72

Grading Plan Approved
as shown and/or noted
THOMAS P. GILLES, P.E.
Lake County Engineer

GRADING PLAN FOR TERRA REALTY, Co.

By: JWK Date: 9/10/72
98-97-96 RIDGEWOOD SUB. PAINESVILLE TWP
PAINESVILLE TWP, LAKE COUNTY, OHIO
SCALE: 1" = 20' NOV. 1972

NOTE: UNDERLINED EL. ARE PROPOSED
FINISH GRADES.

FULLERTON - KERR & ASSOCIATES
REGISTERED ENGINEERS & SURVEYORS
PAINESVILLE - OHIO