


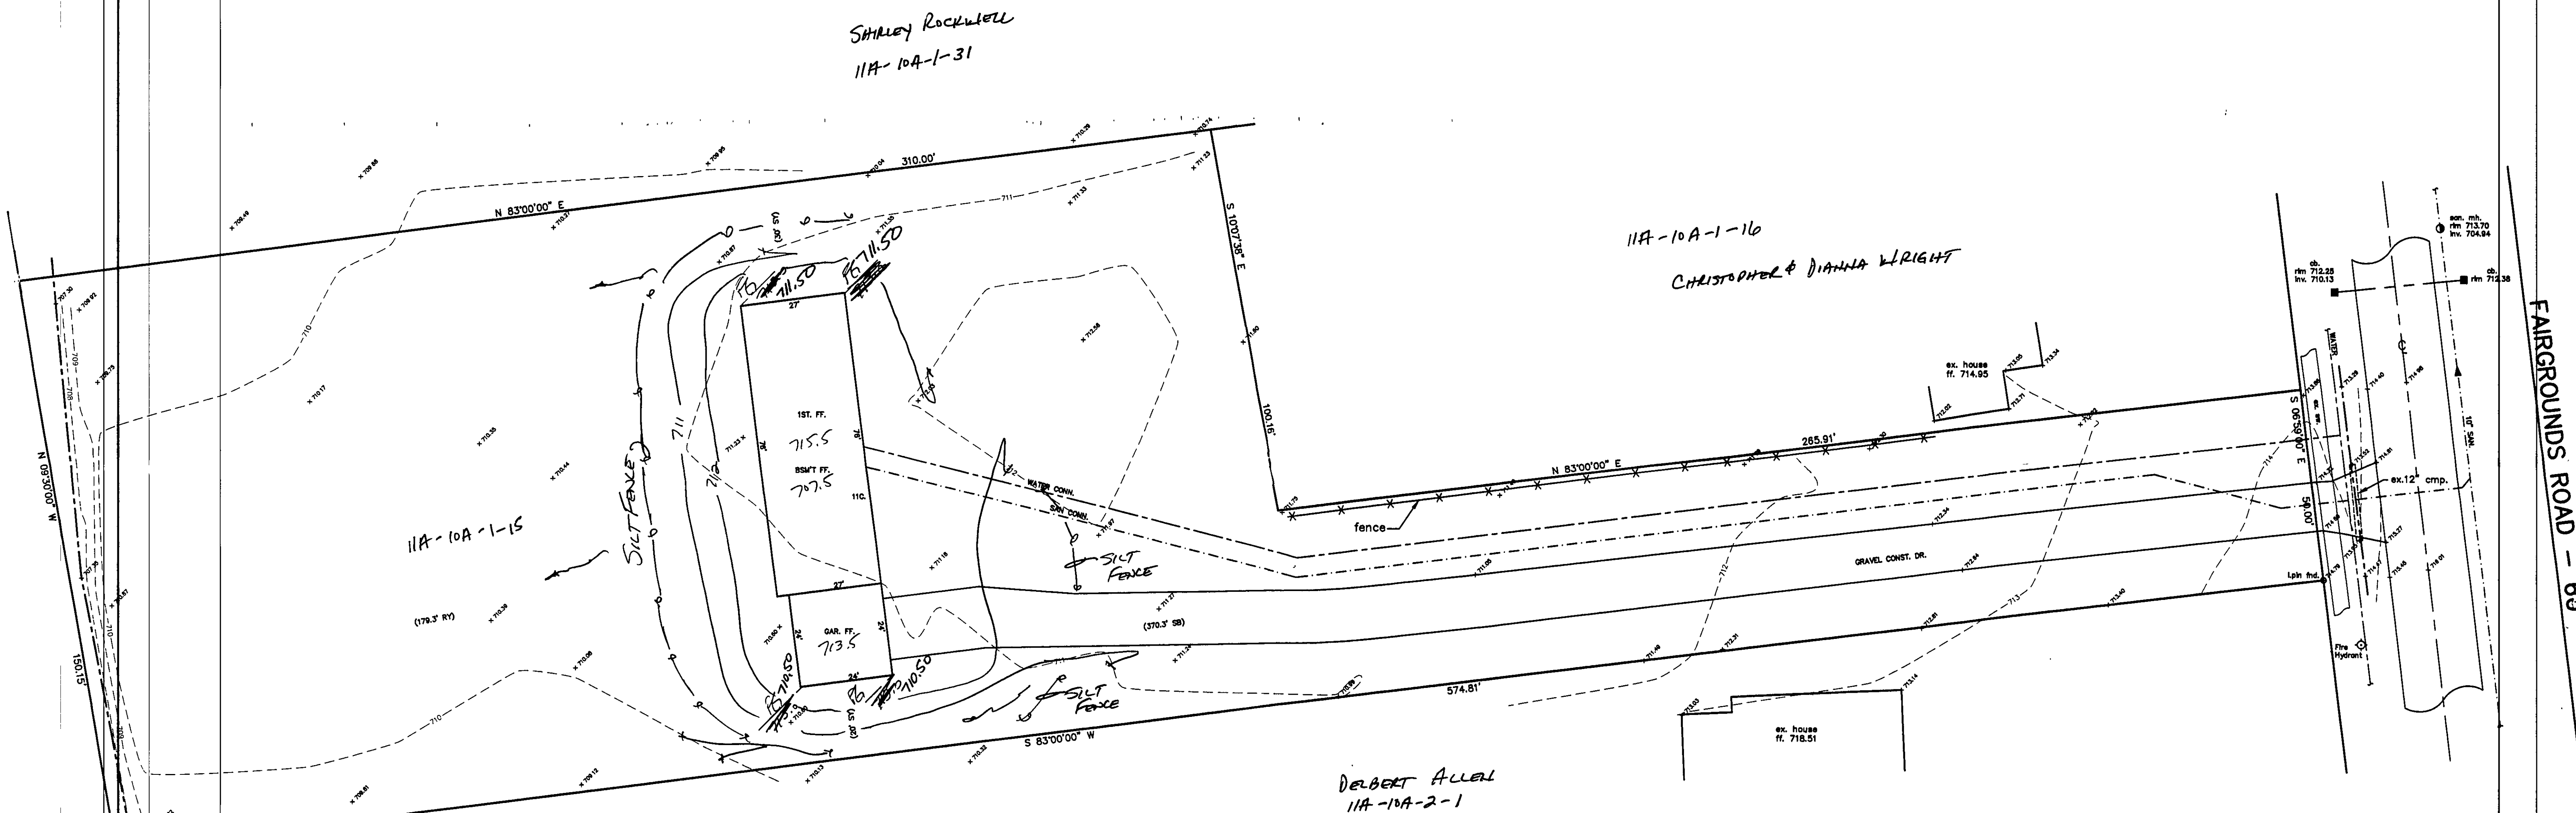

NOTE: TEMPORARY SEEDING REQUIRED
IN DISTURBED AREAS.

APPROVED
PAINESVILLE TOWNSHIP
ZONING DEPARTMENT
2000292
DKR

Grading Plan Approved
as shown and/or noted
THOMAS P. GILLES, P.E.
Lake County Engineer
By TAM Date 8/23/00
1. Lower FG. AS SHOWN
2. A permit will be required from L.C.E.
for utility work within R/W.
3. ROOF DRAINS
SHALL DISCHARGE
TO SPLASH BLOCKS.

BM-SANITARY MH.
RIM=713.70

REV NO.	DESCRIPTION	DATE	BY	CHK'D

bj BABCOCK, JONES AND ASSOCIATES, INC
CIVIL ENGINEERS - SURVEYORS - LAND PLANNERS
PAINESVILLE OHIO 44077

DATE	8/15/00	SITE PLAN FOR DELBERT ALLEN PAINESVILLE TOWNSHIP LAKE COUNTY
DESIGN BY	H.J.	
DRAWN BY	T.R.	
APPROVED BY	H.J.	