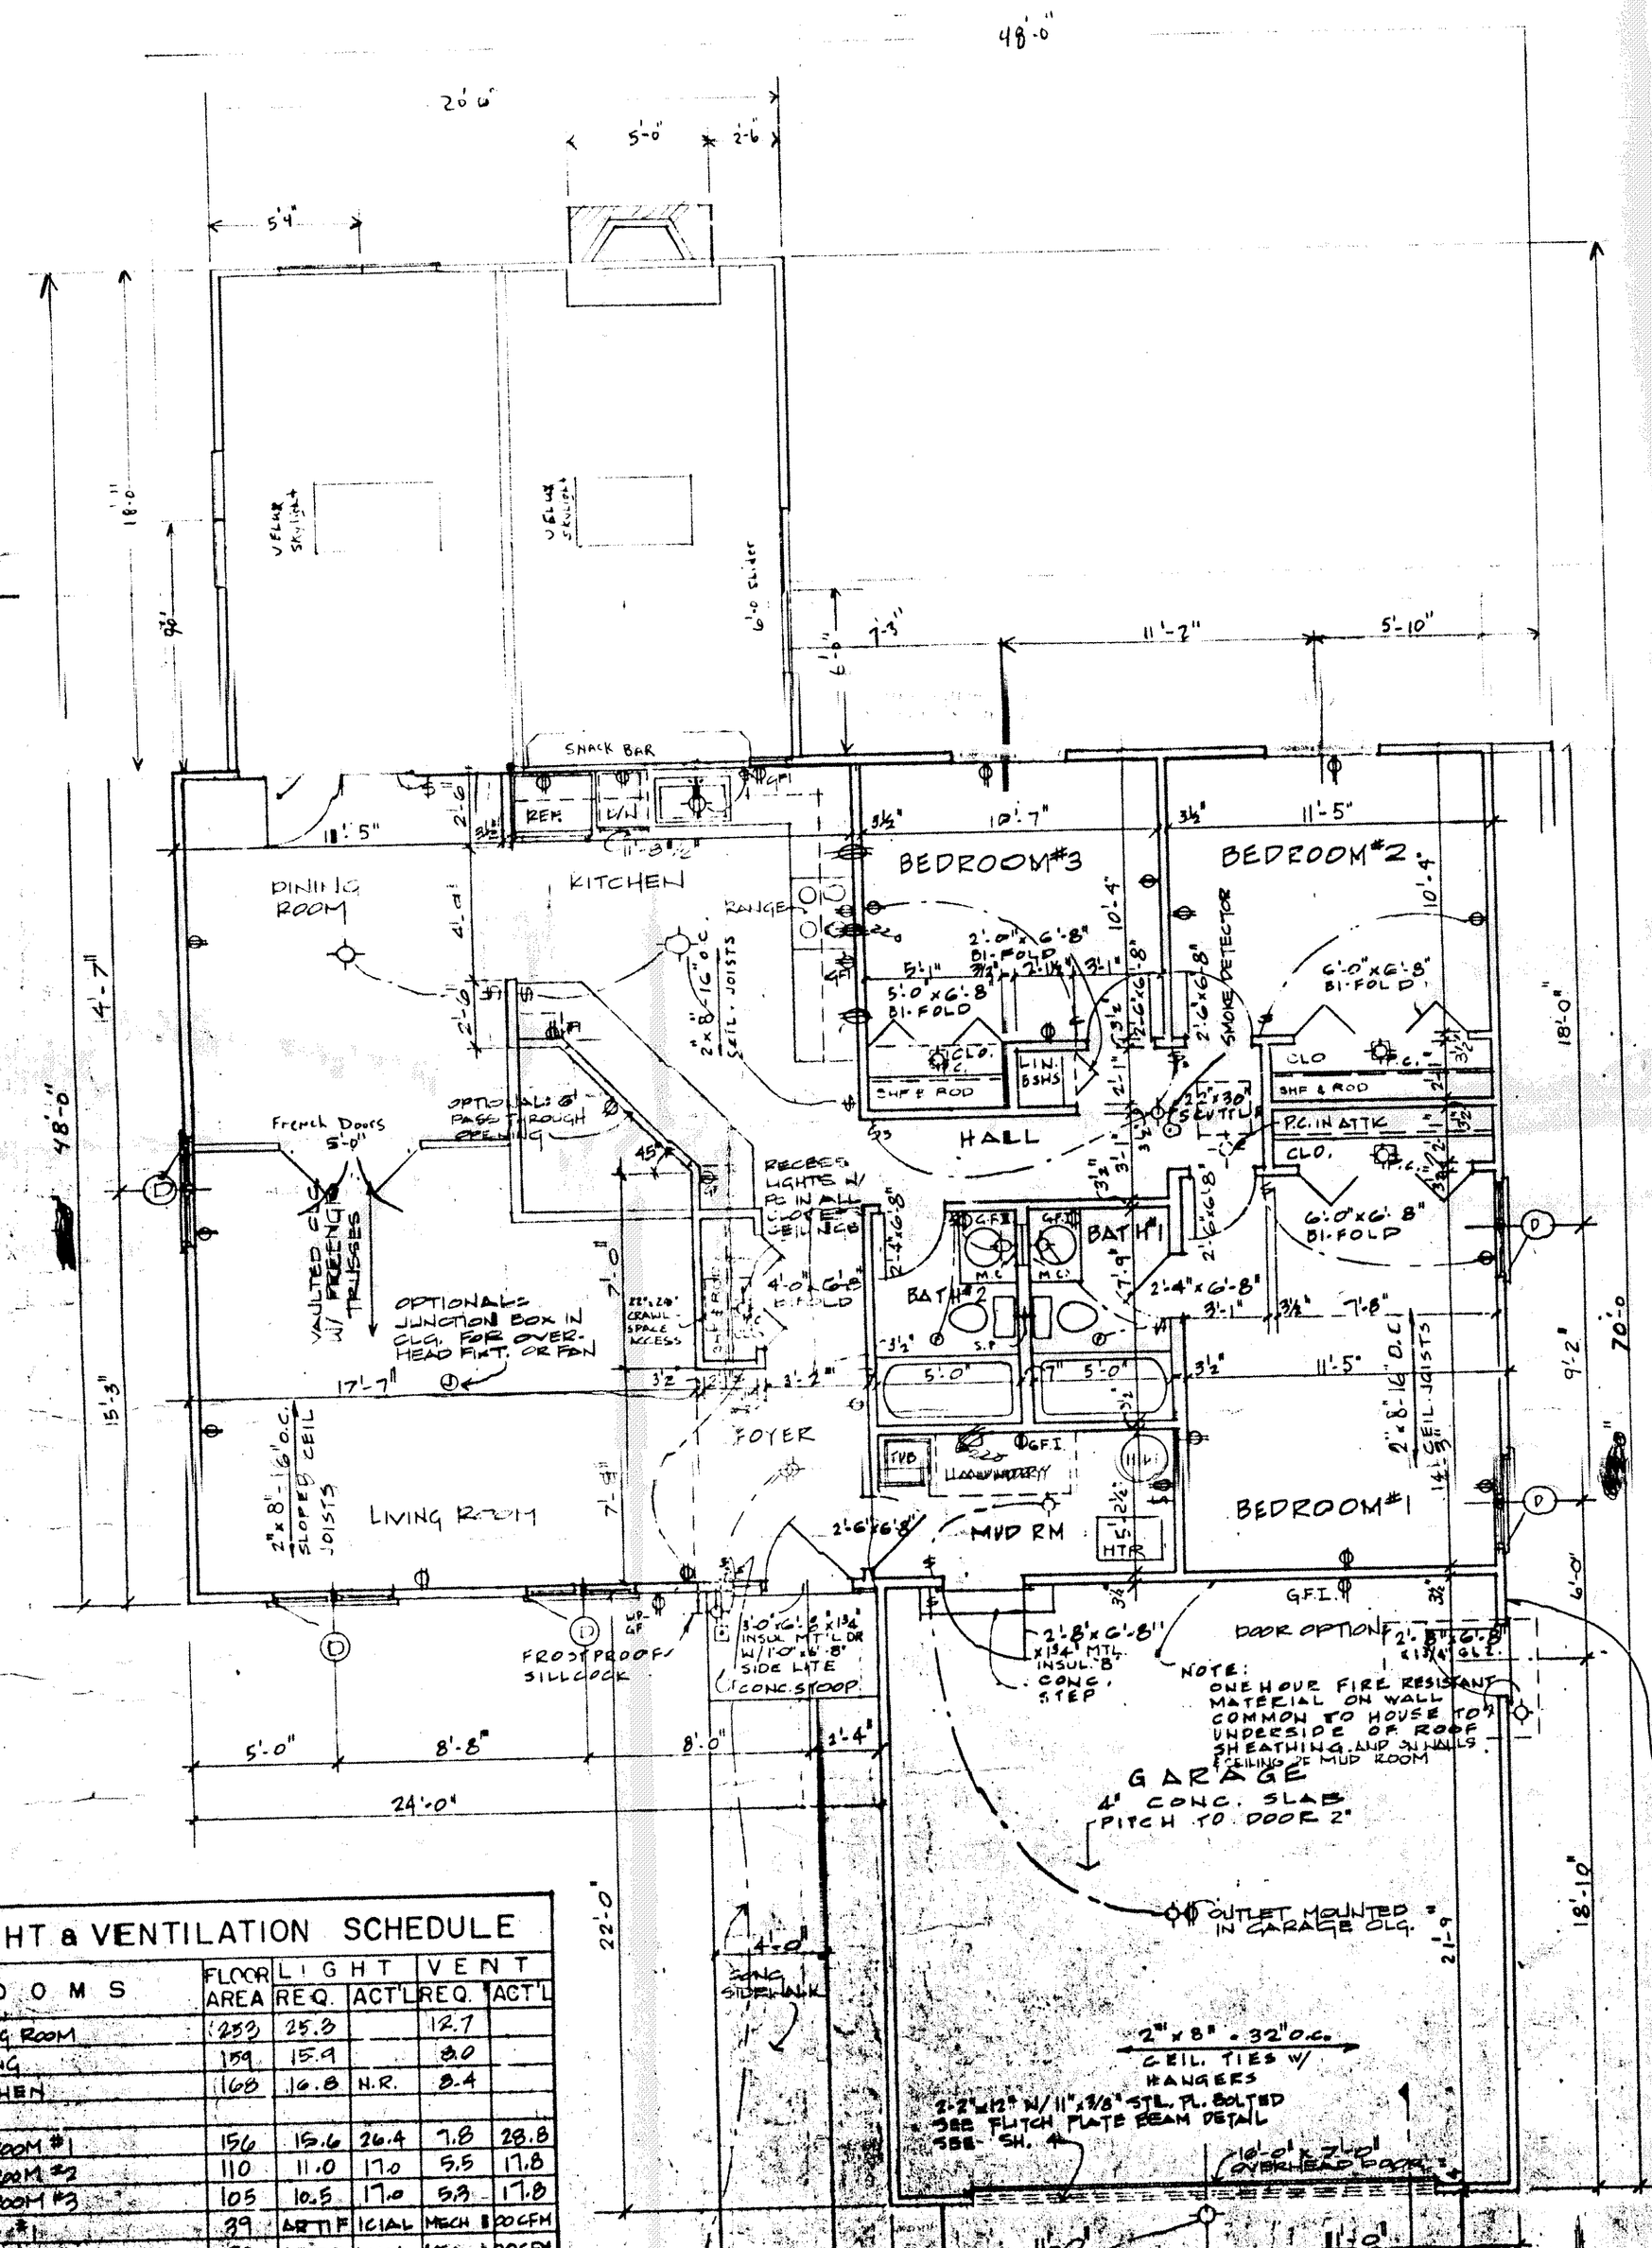

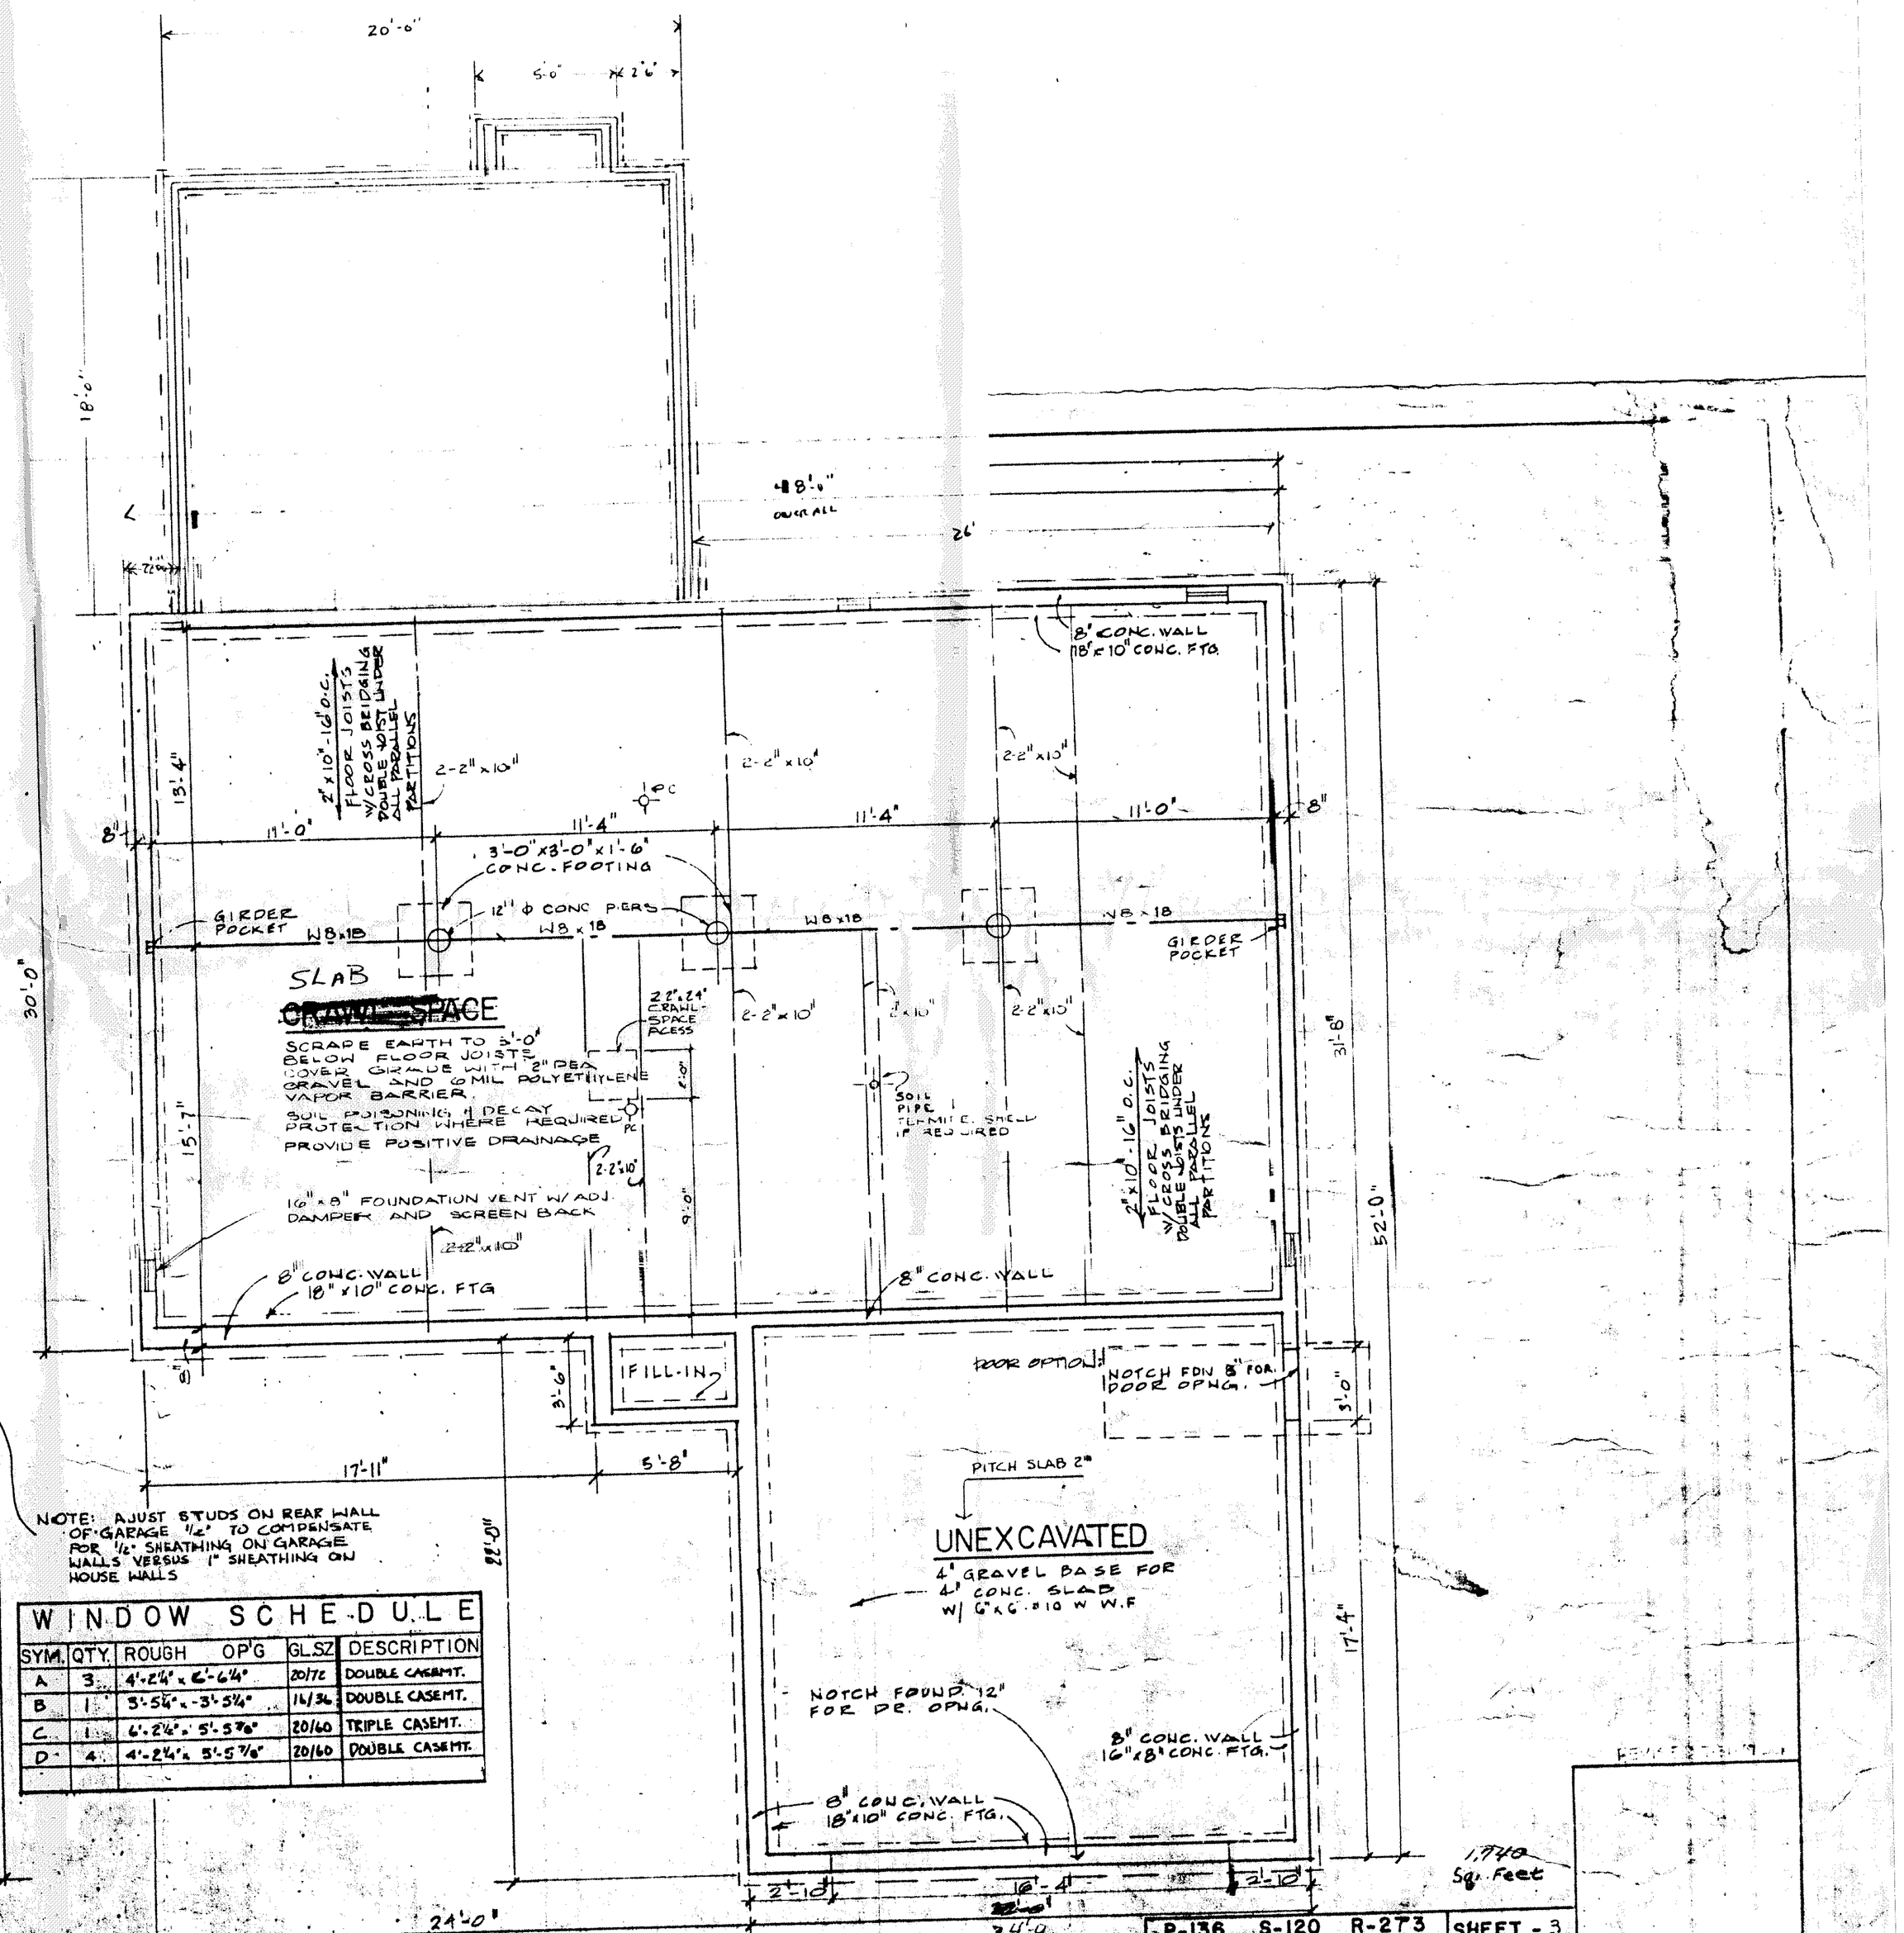

NOTE: ADJUST STUDS ON REAR WALL OF GARAGE 1/2" TO COMPENSATE FOR 1/2" SHEATHING ON GARAGE WALLS VERSUS 1" SHEATHING ON HOUSE WALLS

WINDOW SCHEDULE

SYM.	QTY.	ROUGH OP'G	GL.SZ	DESCRIPTION
A	3	4'-2¼" x 6'-6¼"	20/72	DOUBLE CASEMT.
B	1	3'-5¼" x 3'-5¼"	16/36	DOUBLE CASEMT.
C	1	6'-2¼" x 5'-5⅜"	20/60	TRIPLE CASEMT.
D	4	4'-2¼" x 5'-5⅜"	20/60	DOUBLE CASEMT.

LIGHT & VENTILATION SCHEDULE

ROOMS	FLOOR AREA	LIGHT REQ.	LIGHT ACT'L	VENT REQ.	VENT ACT'L
LIVING ROOM	253	25.3		12.7	
DINING	159	15.9		8.0	
KITCHEN	168	16.8	N.R.	8.4	
BEDROOM #1	156	15.6	26.4	7.8	28.8
BEDROOM #2	110	11.0	17.0	5.5	17.8
BEDROOM #3	105	10.5	17.0	5.3	17.8
BATH #1	39	ARTIFICIAL		MECH	20 CFM
BATH #2	39	ARTIFICIAL		MECH	100 CFM
MUD ROOM	153	ARTIFICIAL		NOT	REQ.

1,740 Sq. Feet

P-136 S-120 R-273
C-7401 S-399

SHEET - 3
TOTAL - 6