


EXIST
PROP

SCALE: 1"=20'

VILLAGE SURVEYING CO.
FAIRPORT HARBOR, OHIO 44077
(216) 357-1359

CURVE DATA 
R=65.00'
A=47.08'
C=46.06'
B=N 85°00'16" E

Grading Plan Approved
as shown and/or noted
THOMAS P. GILLES, P.E.
Lake County Engineer


By GJH Date 8.17.93
DISCHARGE Sump pump
TO STM. SEWER

ROOF DRAINS
SHALL DISCHARGE
TO SPLASH BLOCKS.

SITE PLAN FOR

R.C. REED CONST.
BEING S/L 6 IN HEATHERSTONE VILLAGE SUB'D
NO. 2 IN THE TOWNSHIP OF PAINESVILLE,
LAKE COUNTY, OHIO.

I, the undersigned hereby certify that
this topography, indicated by 1' contours,
and elevations shown hereon represent an
actual field survey made by me on MAY 14, 1993
and that the elevations were taken at
appropriate intervals and that as of that

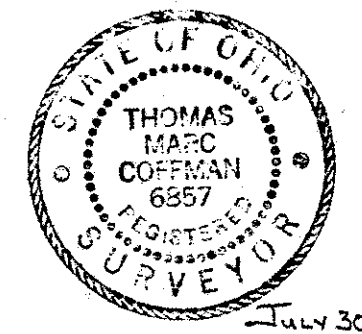

July 30, 1993

APPROVED
PAINESVILLE TOWNSHIP
ZONING DEPARTMENT
#18542 8/12/93
[Signature]

