


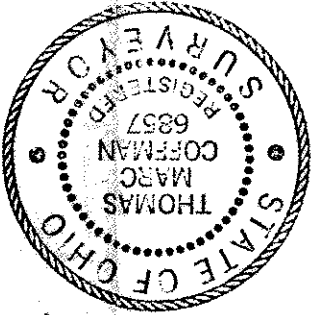

VILLAGE SURVEYING CO.
202 THIRD ST. FAIRPORT HARBOR, OH. 44077
(216) 357-1359

THIS PLAT WAS PREPARED BY ME AND IS ACCURATE
TO THE BEST OF MY KNOWLEDGE AND BELIEF.
Thomas M. Coffman
THOMAS M. COFFMAN P.S. No. 6857

① CURVE DATA
R = 716.20'
Arc. = 1125.00'
Ch. = 1012.86'
B = S 43° 00' W

S/L 130*
(VACANT)

EXIST. PROP.
EXIST. PROP.

SCALE
1" = 20'

PLAT OF SURVEY
FOR
R.C. REED

BEING S/L 127 OF HEATHERSTONE VILLAGE
SUBDIVISION #1, TOWNSHIP OF PAINESVILLE,
COUNTY OF LAKE, STATE OF OHIO.

ROBERT A. SHIELDS
V. 382-582

FF-714.25
Bsmt.-725.58

IAN TEMPLETON
V. 364-1146

FFGAR-710.94
F.F. Hse - 712.88

* BOTH LOTS:
Vol. 836-372

Reading Plan Approved
as shown and/or noted
THOMAS P. GILLES, P.E.
Lake County Engineer

Date 10/16/89
By 924

This Permit Expires
10-13-90
ZONING APPROVED
7370
PAINESVILLE TOWNSHIP

8" SAN.

8" SAN.

FANWOOD DRIVE

10' UTILITY EASE.

10' DRAINAGE EASE.

sump pump

16' CONC. D/W

GAR-712.5

WTR. CONC.

SAN. CONC.

Man. Box

709.14

709.15

712