
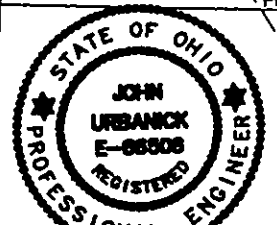


SCALE: 1" = 20'

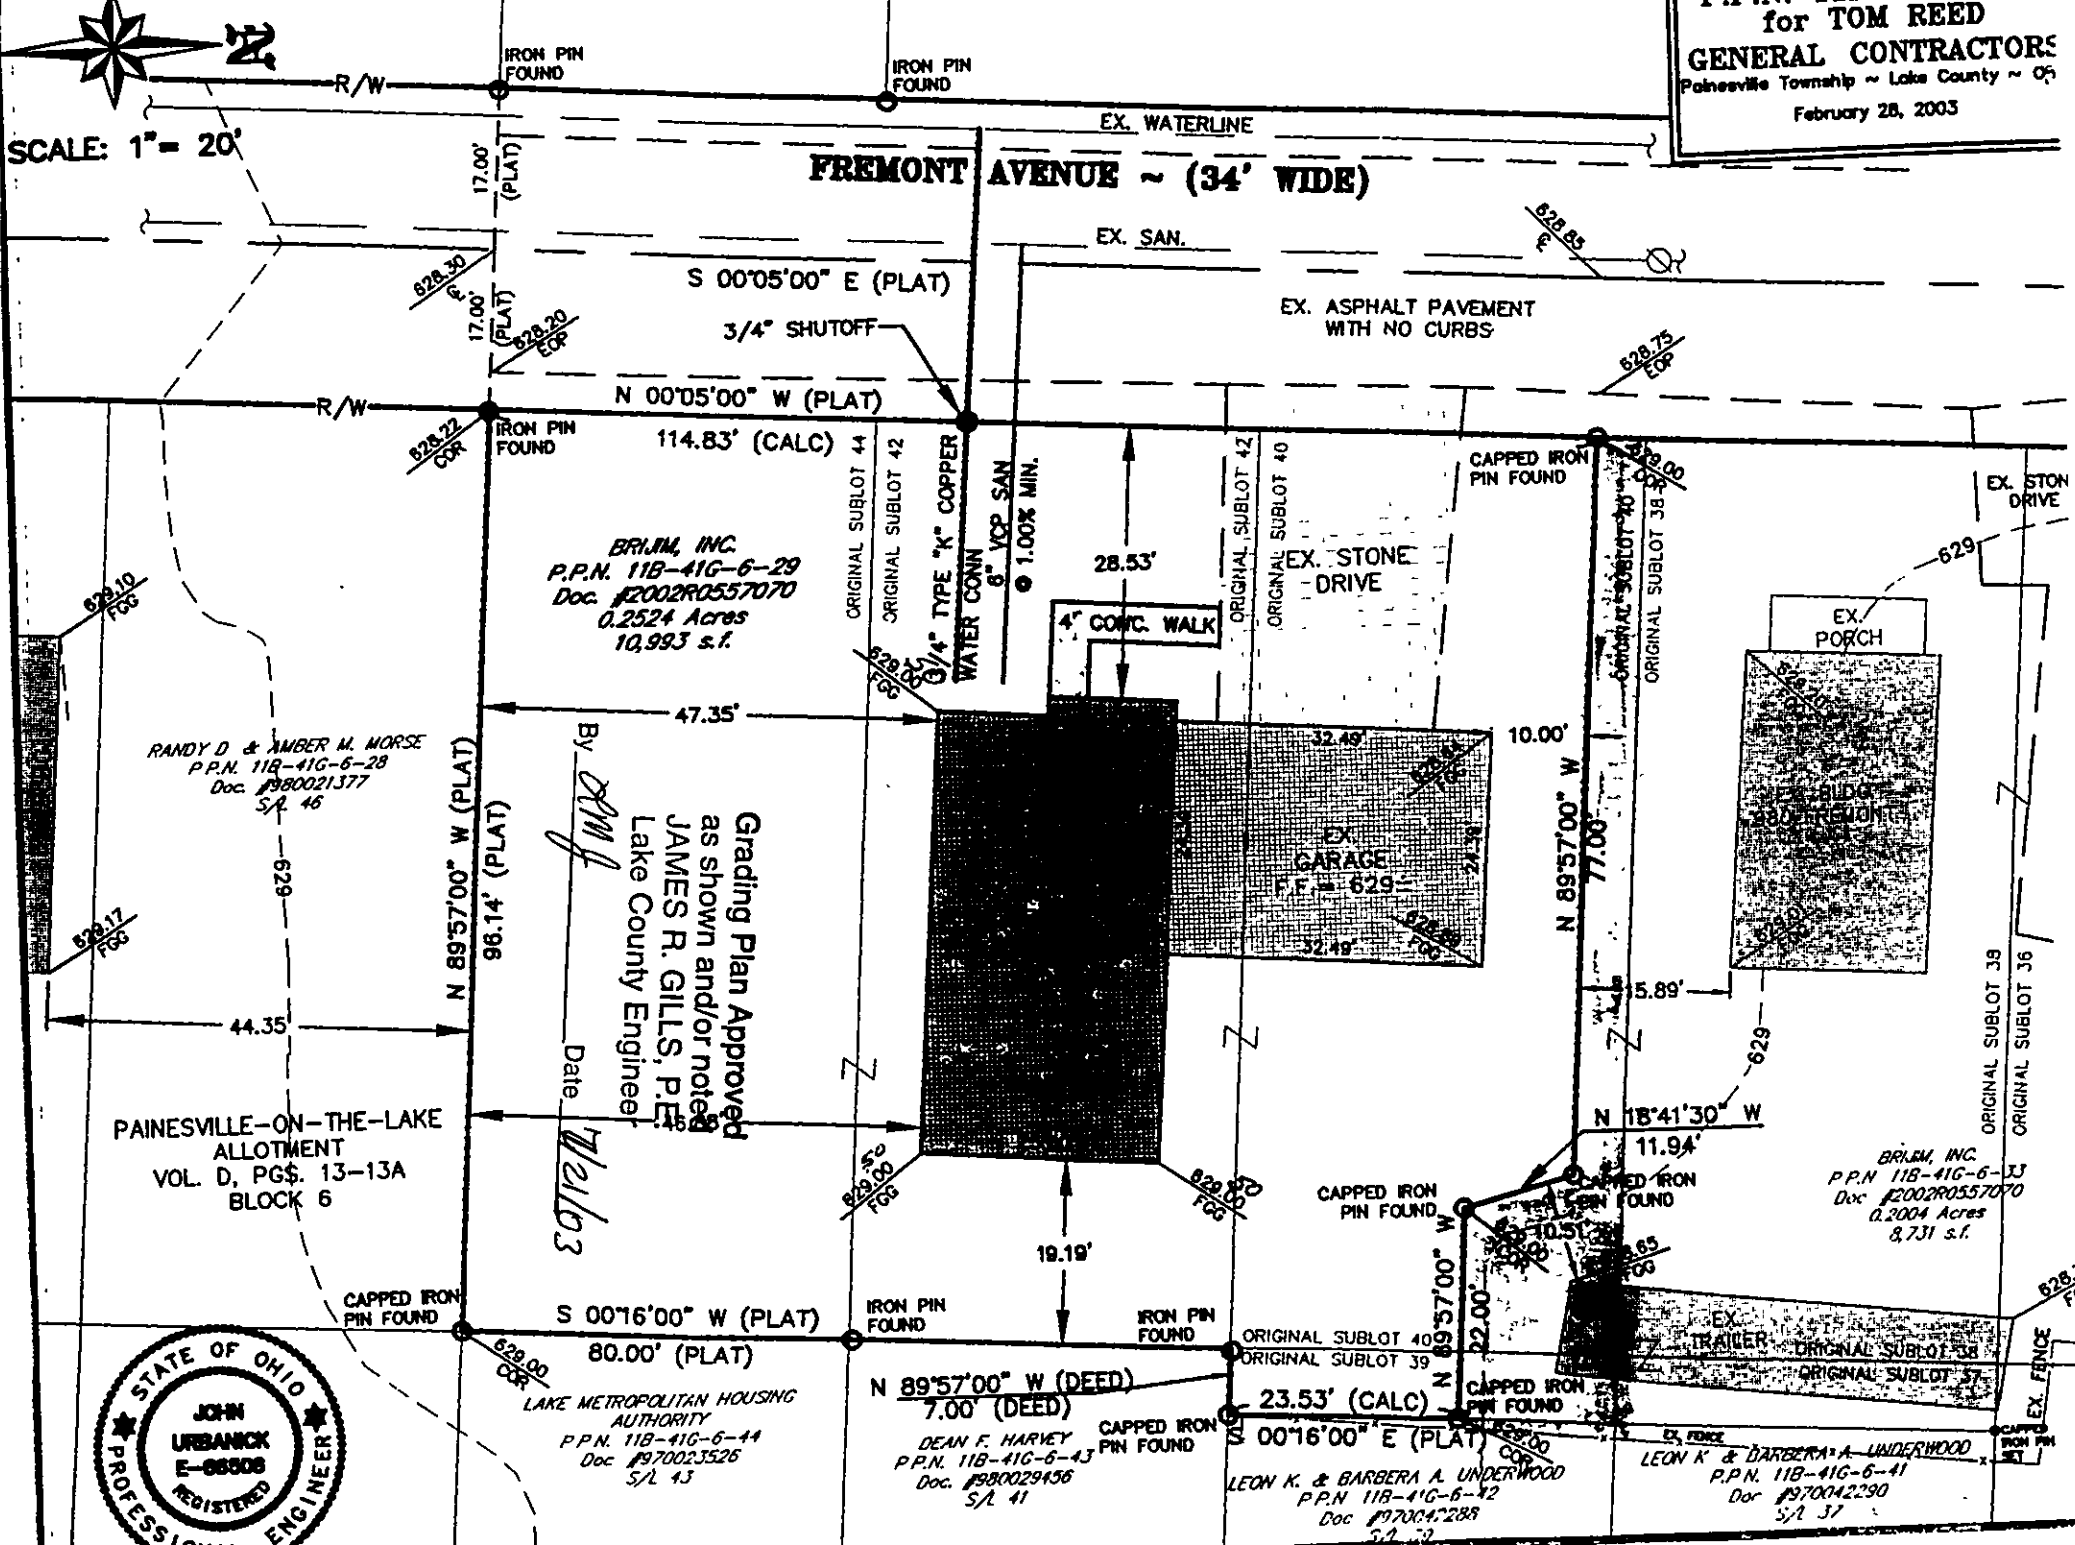

Grading Plan Approved
 as shown and/or noted
 JAMES R. GILLS, P.E.
 Lake County Engineer

By *JMG*
 Date *7/2/03*

RANDY D. & AMBER M. MORSE
 P.P.N. 11B-41G-6-28
 Doc. #980021377
 S/L 46

PAINESVILLE-ON-THE-LAKE
 ALLOTMENT
 VOL. D, PGS. 13-13A
 BLOCK 6

LAKE METROPOLITAN HOUSING
 AUTHORITY
 P.P.N. 11B-41G-6-44
 Doc. #970023526
 S/L 43

DEAN F. HARVEY
 P.P.N. 11B-41G-6-43
 Doc. #980029456
 S/L 41

LEON K. & BARBARA A. UNDERWOOD
 P.P.N. 11B-41G-6-42
 Doc. #970042288
 S/L 39

LEON K. & BARBARA A. UNDERWOOD
 P.P.N. 11B-41G-6-41
 Doc. #970042290
 S/L 37

BRIEM, INC.
 P.P.N. 11B-41G-6-33
 Doc. #2002R0557070
 0.2004 Acres
 8,731 s.f.

BRIEM, INC.
 P.P.N. 11B-41G-6-29
 Doc. #2002R0557070
 0.2524 Acres
 10,993 s.f.