

FOR

R.C. REED CONST.
BEING SUBLOT No. 131, IN THE
HEATHERSTONE SUBD No. 1,
HAINESVILLE TWP., LAKE COUNTY, OHIO


This Permit Expires

PAINESVILLE TOWNSHIP ZONING APPROVED

Zone Inspector

7494 #

EXIST
PROP.

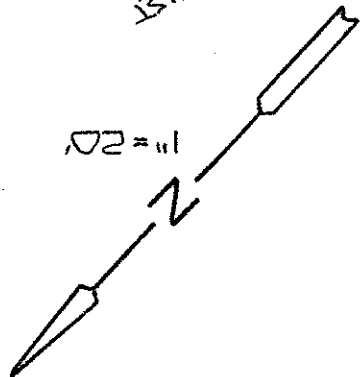 $\nabla^2 = 11$ 

ALL PARCELS -
HEATHERSTADT DEV. CORP.
6/9.94

23

S/L 130 - VACANT

5/17/13

$N 36^{\circ} 35' 47'' W$

80L


2

Grading Plan Approved
as shown and/or noted
THOMAS P. GILLES, P.E.
Lake County Engineer

By (g) H Date 5/3/90

1. CONNECT Sump pump TO

2. DOWN SPOTS TO SPLASH BLOCKS

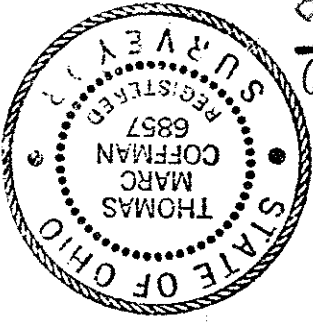

I, the undersigned hereby certify that this topography, indicated by 1' contours, and elevations shown hereon represent an actual field survey made by me on 27-4-20-90 and that the elevations were taken at appropriate intervals and that as of that date they existed as indicated hereon.

1. M. Cottman P.S. No 6857

BENCHMARK-708.24
N.R.M. STM MH: INV 700.32

