


GRAPHIC SCALE

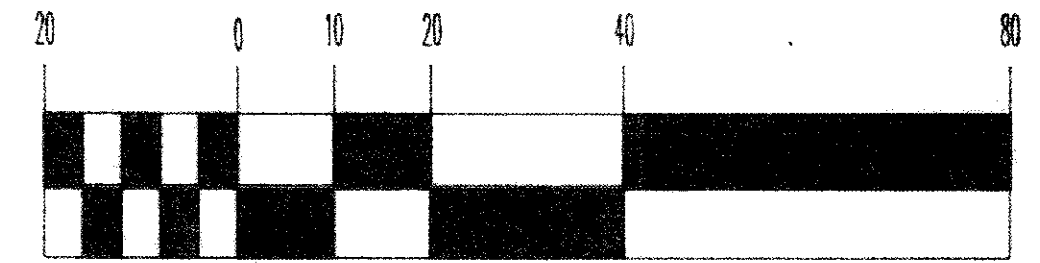

(IN FEET)

1 inch = 20 ft.



EXIST. FIRE HDY., BENCHMARK
TOP STEM, ELEV.=631.90

GENERAL NOTES:

1. DRIVEWAY APRON TO BE 6" THICK
2. BENCHMARK - TOP STEM OF FIRE HYDRANT LOCATED ARCOSS FROM SUBLT No. 257, ELEV.=631.90

LEGEND

- EXISTING CONTOUR
- PROPOSED CONTOUR
- EXISTING ELEVATION
- PROPOSED ELEVATION

CERTIFICATION

"I THE UNDERSIGNED HEREBY CERTIFY THAT THIS TOPOGRAPHY INDICATED BY 'I' CONTOURS AND ELEVATIONS SHOWN HEREON REPRESENTS AN ACTUAL SURVEY MADE BY ME ON THE 13th DAY OF AUGUST, 1997 AND THE ELEVATIONS WERE TAKEN AT APPROPRIATE INTERVALS AND AS OF THAT DAY THEY EXISTED AS INDICATED HEREON.

"I HEREBY CERTIFY THAT THIS PLAN WAS PREPARED BY ME AND IS CORRECT TO THE BEST OF MY KNOWLEDGE"

David W. Novak
DAVID W. NOVAK, P.S. No. 7507

PREPARED BY:

Himebaugh and Novak
Surveyors and Site Consultants
8663 Tyler Boulevard
Mentor, Ohio 44060-4346
(216) 974-7670, (216) 255-5900 FAX.

Grading Plan Approved
as shown and/or noted
THOMAS P. GILLES, P.E.
Lake County Engineer

6/14/97

Lower F.G. to 629.0

SITE PLAN: SUBLT No. 258 INDIANOLA AVENUE PAINESVILLE TWP.
HARDY POINT ALLOTTMENT, VOL. C, PG. 57

PREPARED FOR: JACK BALL MOBILE HOME SALES

SCALE: 1" = 20'

DATE: AUGUST 15, 1997

DRAWN BY: DAVID W. NOVAK

APPROVED
PAINESVILLE TOWNSHIP
ZONING DEPARTMENT

19970211

DR

97083