


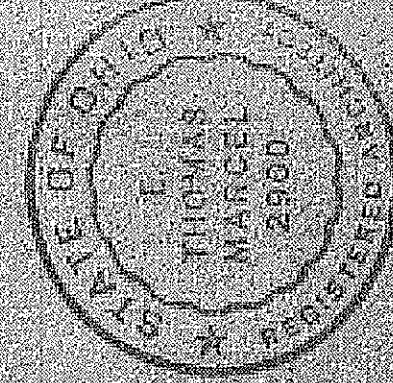


PROPOSED BUILDING FOR
A.P. PRODUCTS
JACKSON STREET PAINESVILLE TOWNSHIP
5 MAY 1976

E. THOMAS MARCEL & ASSOCIATES
ARCHITECTS
THE CORNING-WHITE HOUSE
8355 MENTOR AVENUE MENTOR, OHIO 44060
255-8314

CONST. PERM. ISSUED
10 MAY 1976

SWALE TO EXIST. DITCH

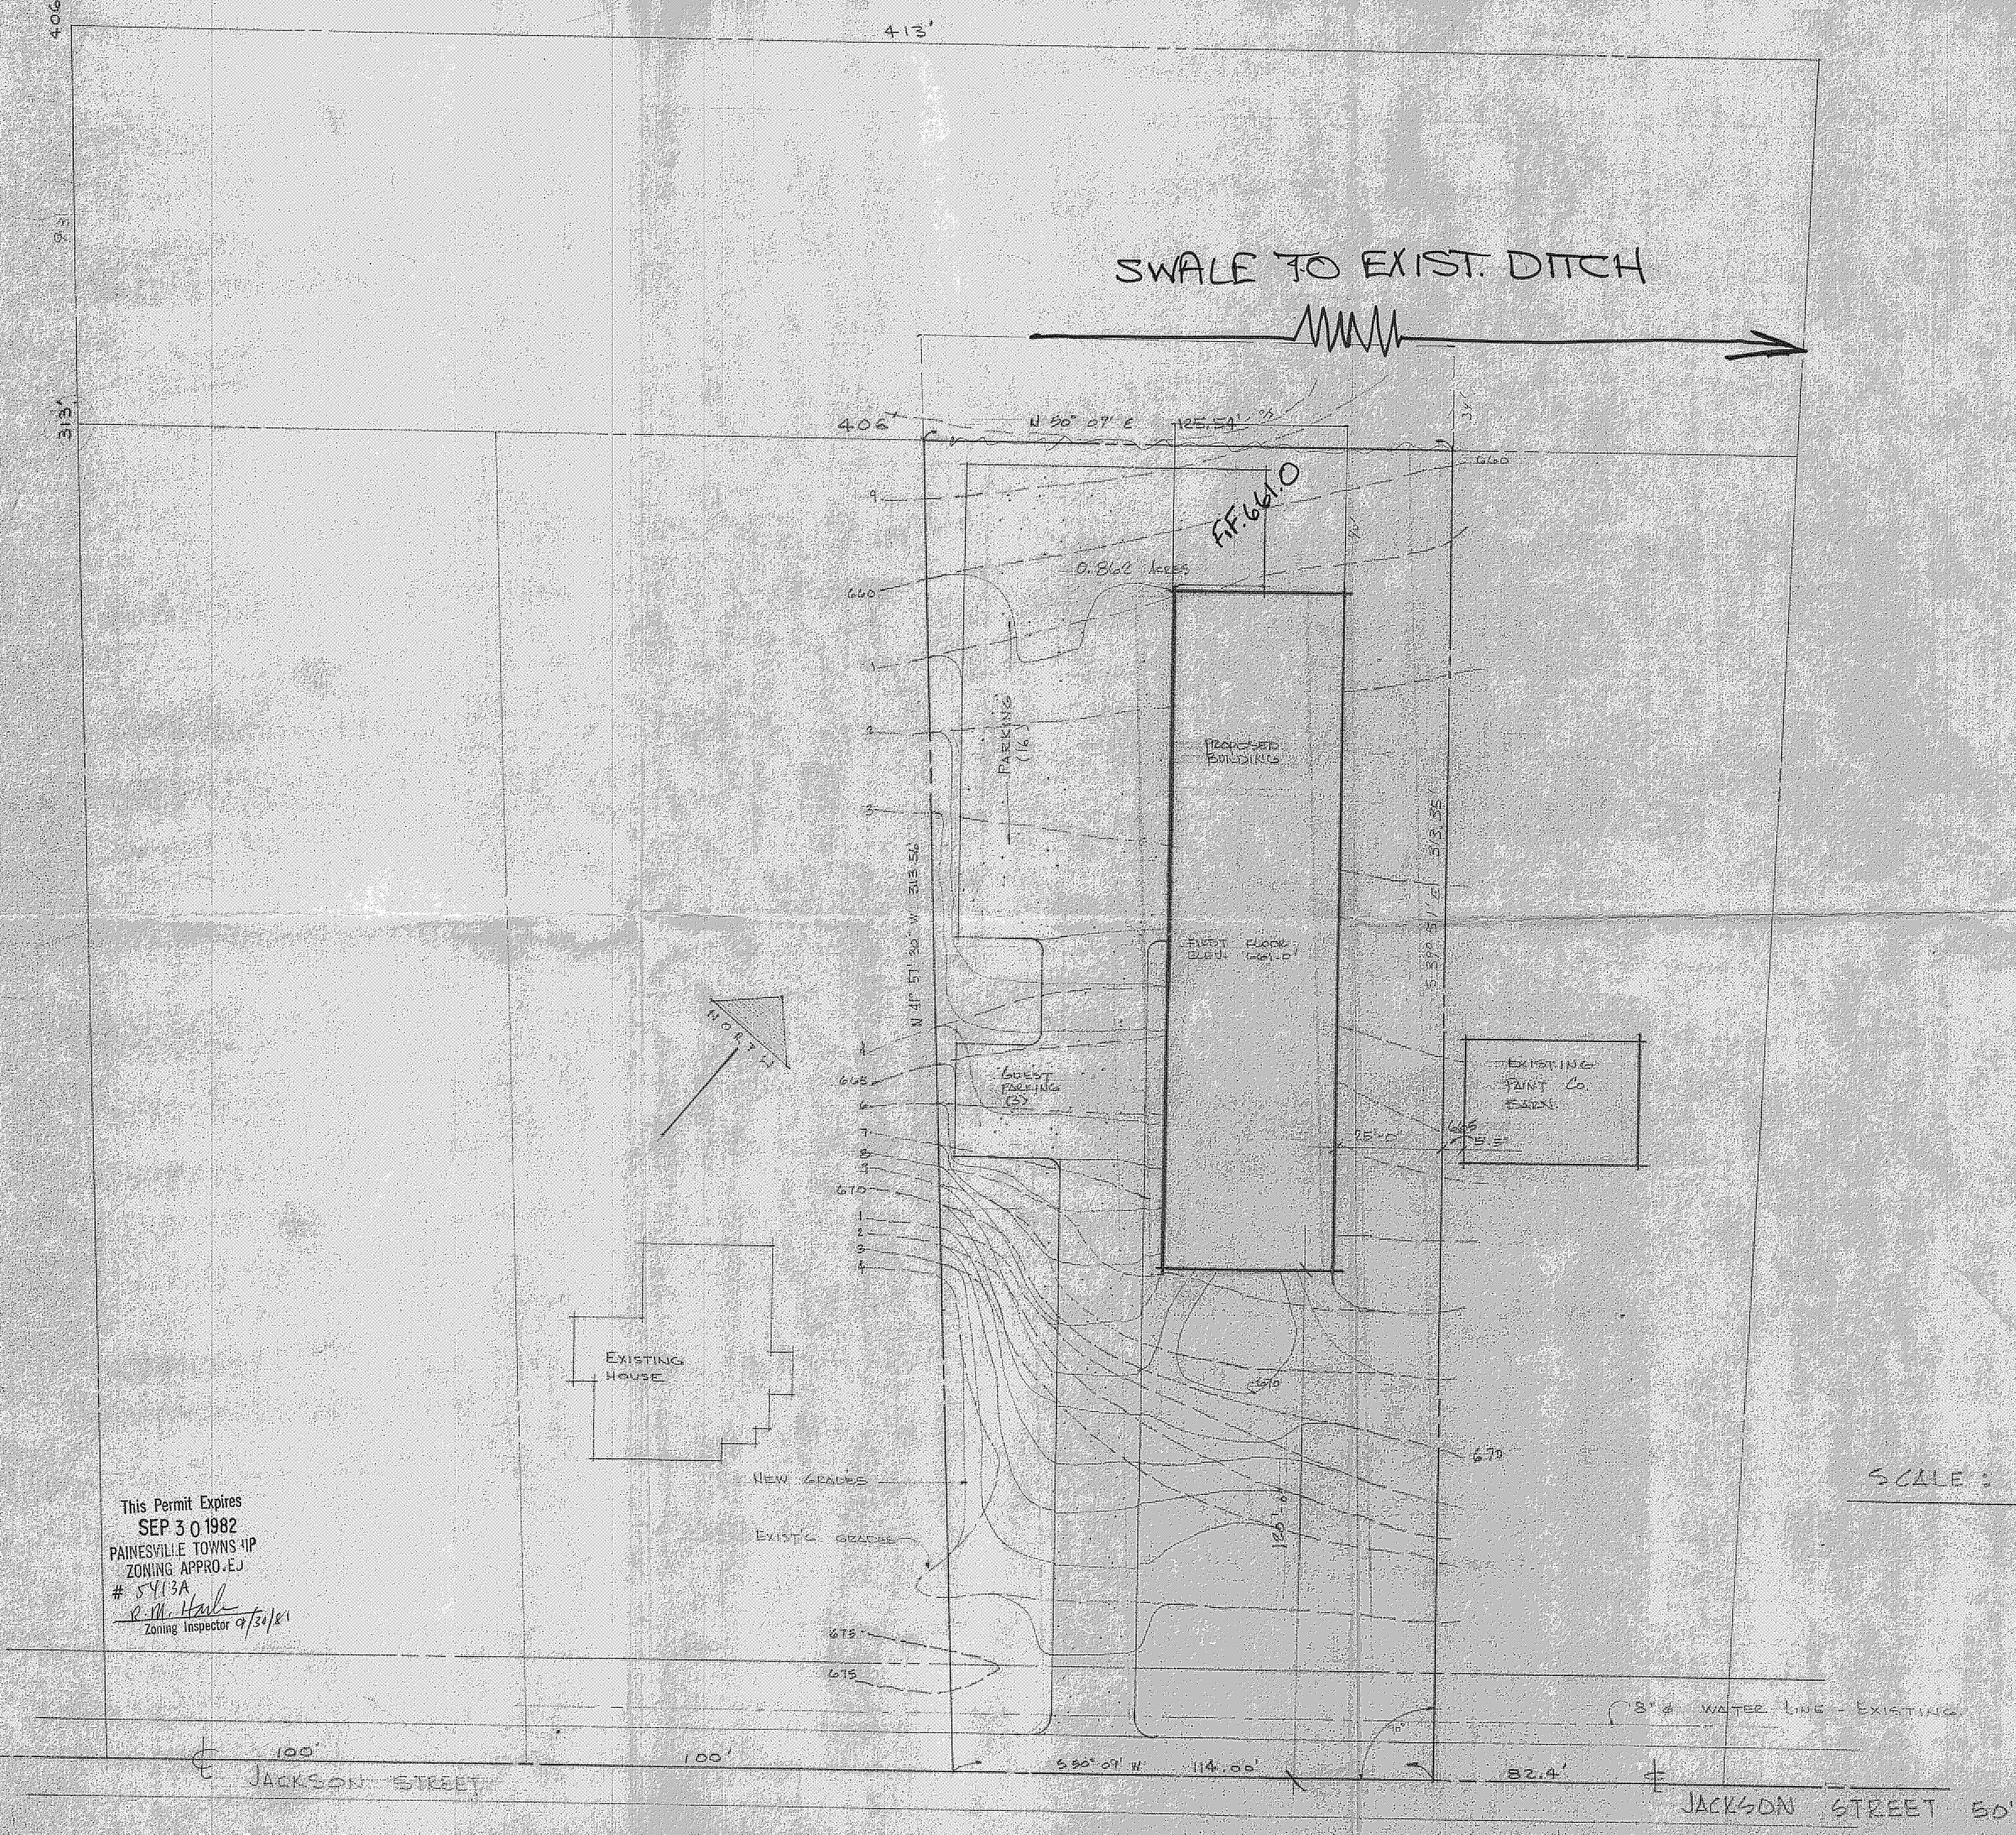

SCALE: 1" = 20'

This Permit Expires
SEP 30 1982
PAINESVILLE TOWNSHIP
ZONING APPROVED
5413A
R.M. Haul
Zoning Inspector 9/30/81