


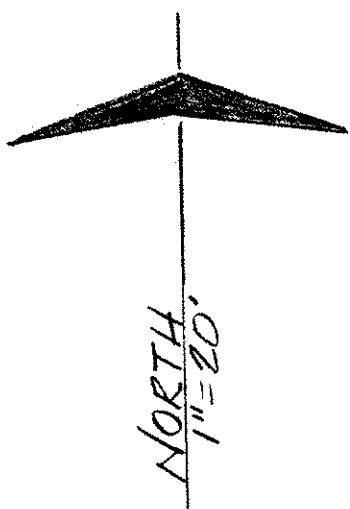

B.M. TOP FIRE HYD.
EL. = 633.37

KENILWORTH

AVE. 50'

AVE.

117'

EX. 8" SAN. SEWER

EX. 8" WATER LINE

ASPH. PAVEMENT

12' x 2' DRIVE

10' GAS LINE EASEMENT

PAINESVILLE ON-THE-LAKE ALLOT. VOL. D-13

SHED

GAR.

20' CAR. 632.50

ONE STY HOUSE
F.F. = 633.00
48'

S/L 12
0.206 AC.

DWELL.

20' CAR. F.F. 632.67

S/L 11
0.222 AC.

S/L 10
630

Grading Plan Approved
as shown and/or noted
THOMAS P. GILLES, P.E.
Lake County Engineer

By THP Date 4-4-88

DRILLEX INC. VOL. 63-315

This Permit Expires

11-13-88


PAINESVILLE TOWNSHIP

ZONING APPROVED

6830

Willis E. Messinger

Inspector

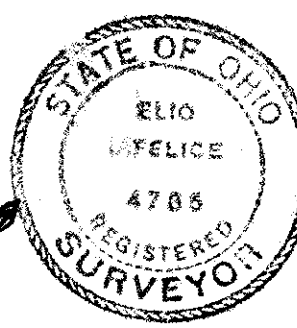

SITE PLAN OF S/L 12 OF
SHOREWOOD SUBD. PHASE I
FOR
JEFF OROSZ
PAINESVILLE TOWNSHIP
LAKE COUNTY, OHIO
SCALE: 1"=20' MARCH, 1988

NOTES: UNDERLINED ELEVATIONS
ARE PROPOSED GRADES-
PROP. CONTOUR LINE ————
EXIST. CONTOUR LINE - - - - -

PREPARED BY:
ELIO IAFELICE
REG. SURVEYOR #4785