


CENTERLINE CURVE DATA

CURVE	RADIUS	LENGTH	TANGENT	CHORD	BEARING	DELTA
CL1	300.00'	81.16'	40.83'	80.91'	S82°17'05" E	15°30'00"
CL2	400.00'	298.37'	156.51'	291.50'	N84°05'46" E	42°44'17"
CL3	400.00'	64.69'	32.41'	64.62'	S79°10'03" E	08°15'58"
CL4	400.00'	37.65'	18.84'	37.64'	S86°28'50" E	05°23'37"
CL5	400.00'	2317.25'	100.02'	194.07'	N76°46'00" E	331°55'16"

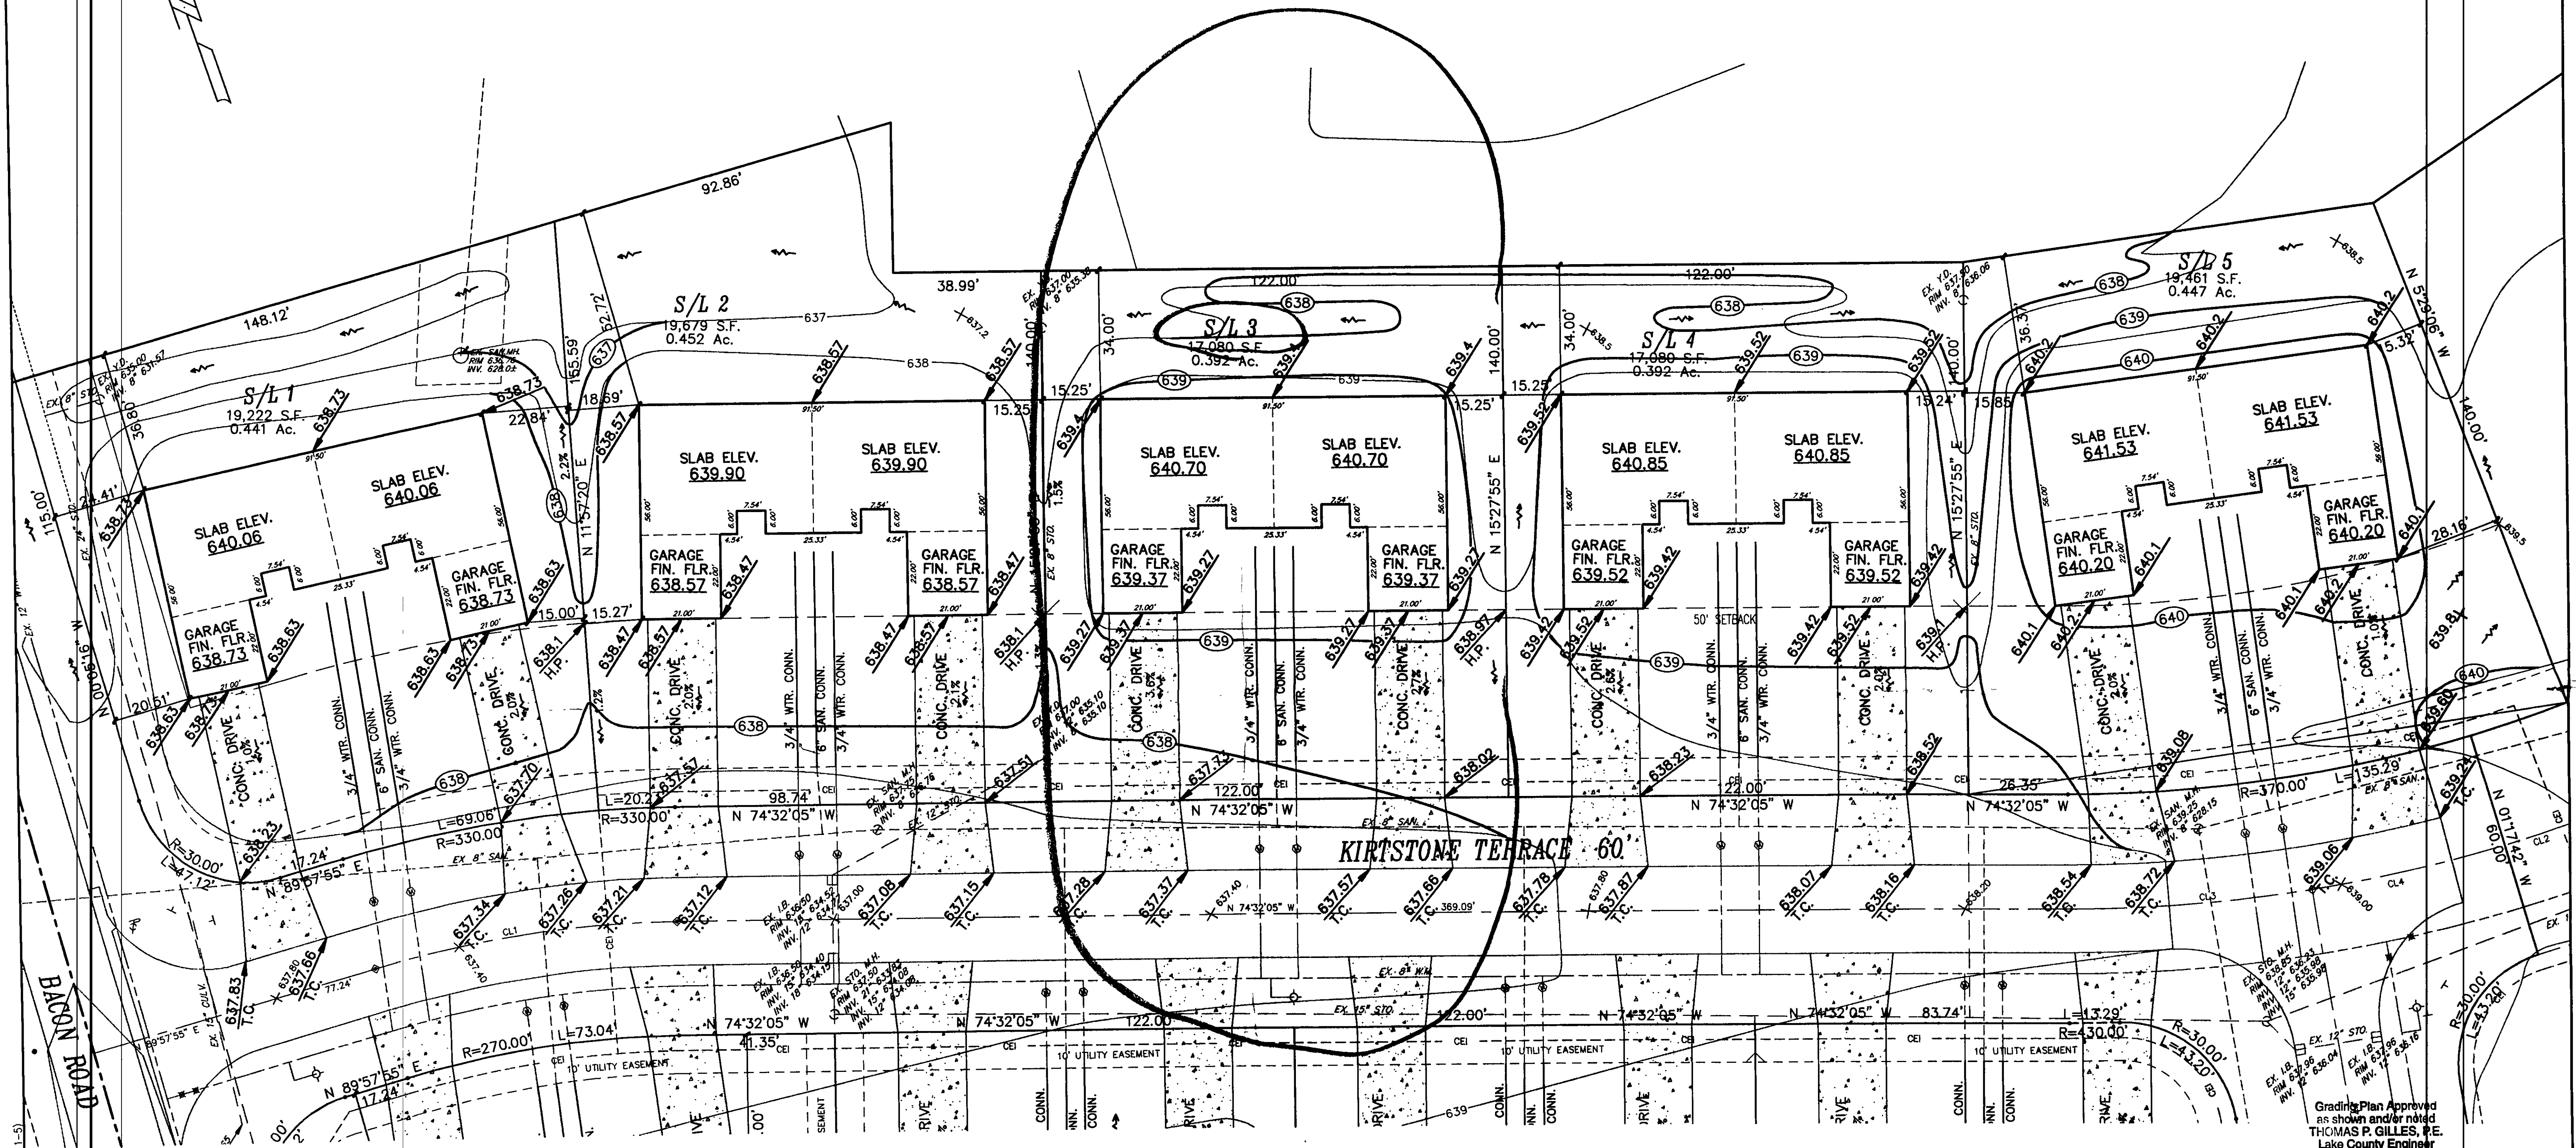


LEGEND

- ✕ 639.8 EXISTING GRADE
- ▲ 639.80 PROPOSED GRADE
- 637 — EXISTING CONTOUR
- 637 — PROPOSED CONTOUR

CERTIFICATION

I HEREBY CERTIFY THAT THIS PLAT WAS PREPARED BY ME AND IS CORRECT TO THE BEST OF MY KNOWLEDGE AND BELIEF.

BY: *Michael W. Colpetzer*
MICHAEL W. COLPETZER, P.E. 59277

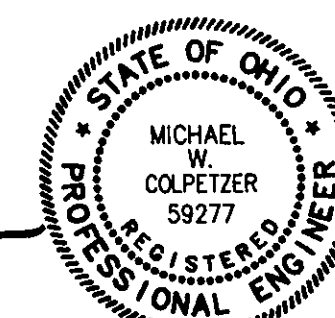

BENCHMARK:

TOP OF HYDRANT - EAST SIDE OF BACON ROAD ACROSS FROM HOUSE #789, ELEVATION 643.46

APPROVED
PAINESVILLE TOWNSHIP
PLANNING DEPARTMENT
19980147
DRUGA

By: *WH* Date: 5.29.98


PRINTED

MAY 15 1998

CT CONSULTANTS, INC.

SITE PLAN for
EDWARD H. TRESGER, INC.
BEING S/L NO. 1 THRU 5 IN THE PINES SUBDIVISION PHASE IV
IN PAINESVILLE TOWNSHIP, OHIO

DATE: APRIL, 1997
DRAWN BY: B.R.S.
CHECKED BY: M.W.C.
APPROVED BY: M.W.C.
F.B. No. PG.

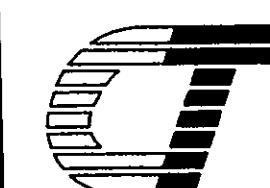

CT Consultants, Inc.
Engineers • Architects • Planners
Willoughby • Mentor • Columbus • Lorain • North Canton • Youngstown

SCALE:
1"=20'
CONTRACT NO.
94290
SHEET NO. OF
1 1