


OPRIGHT CT CONSULTANTS, INC. DATE: 04/24/97 16:55. H:\CT\94290\SDSK\KIRTSP.DWG (VIEW 1-5)

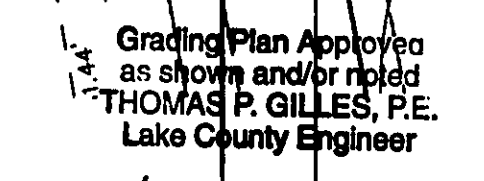

By 624 Date 5.29.98

11

--	--

CT Consultants, Inc.
Engineers • Architects • Planners
Willoughby • Mentor • Columbus • Lorain • North Canton • Youngstown