


CENTERLINE CURVE DATA

CURVE	RADIUS	LENGTH	TANGENT	CHORD	BEARING	DELTA
CL1	300.00	81.16	40.83	80.91	S82°17'05" E	15°30'00"
CL2	400.00	298.37	156.51	291.50	N84°05'48" E	42°44'17"
CL3	400.00	64.69	32.41	64.62	S78°10'03" E	09°15'56"
CL4	400.00	37.63	18.84	37.64	S88°29'50" E	05°23'37"
CL5	400.00	237.25	100.02	194.07	N76°46'00" E	33°55'16"

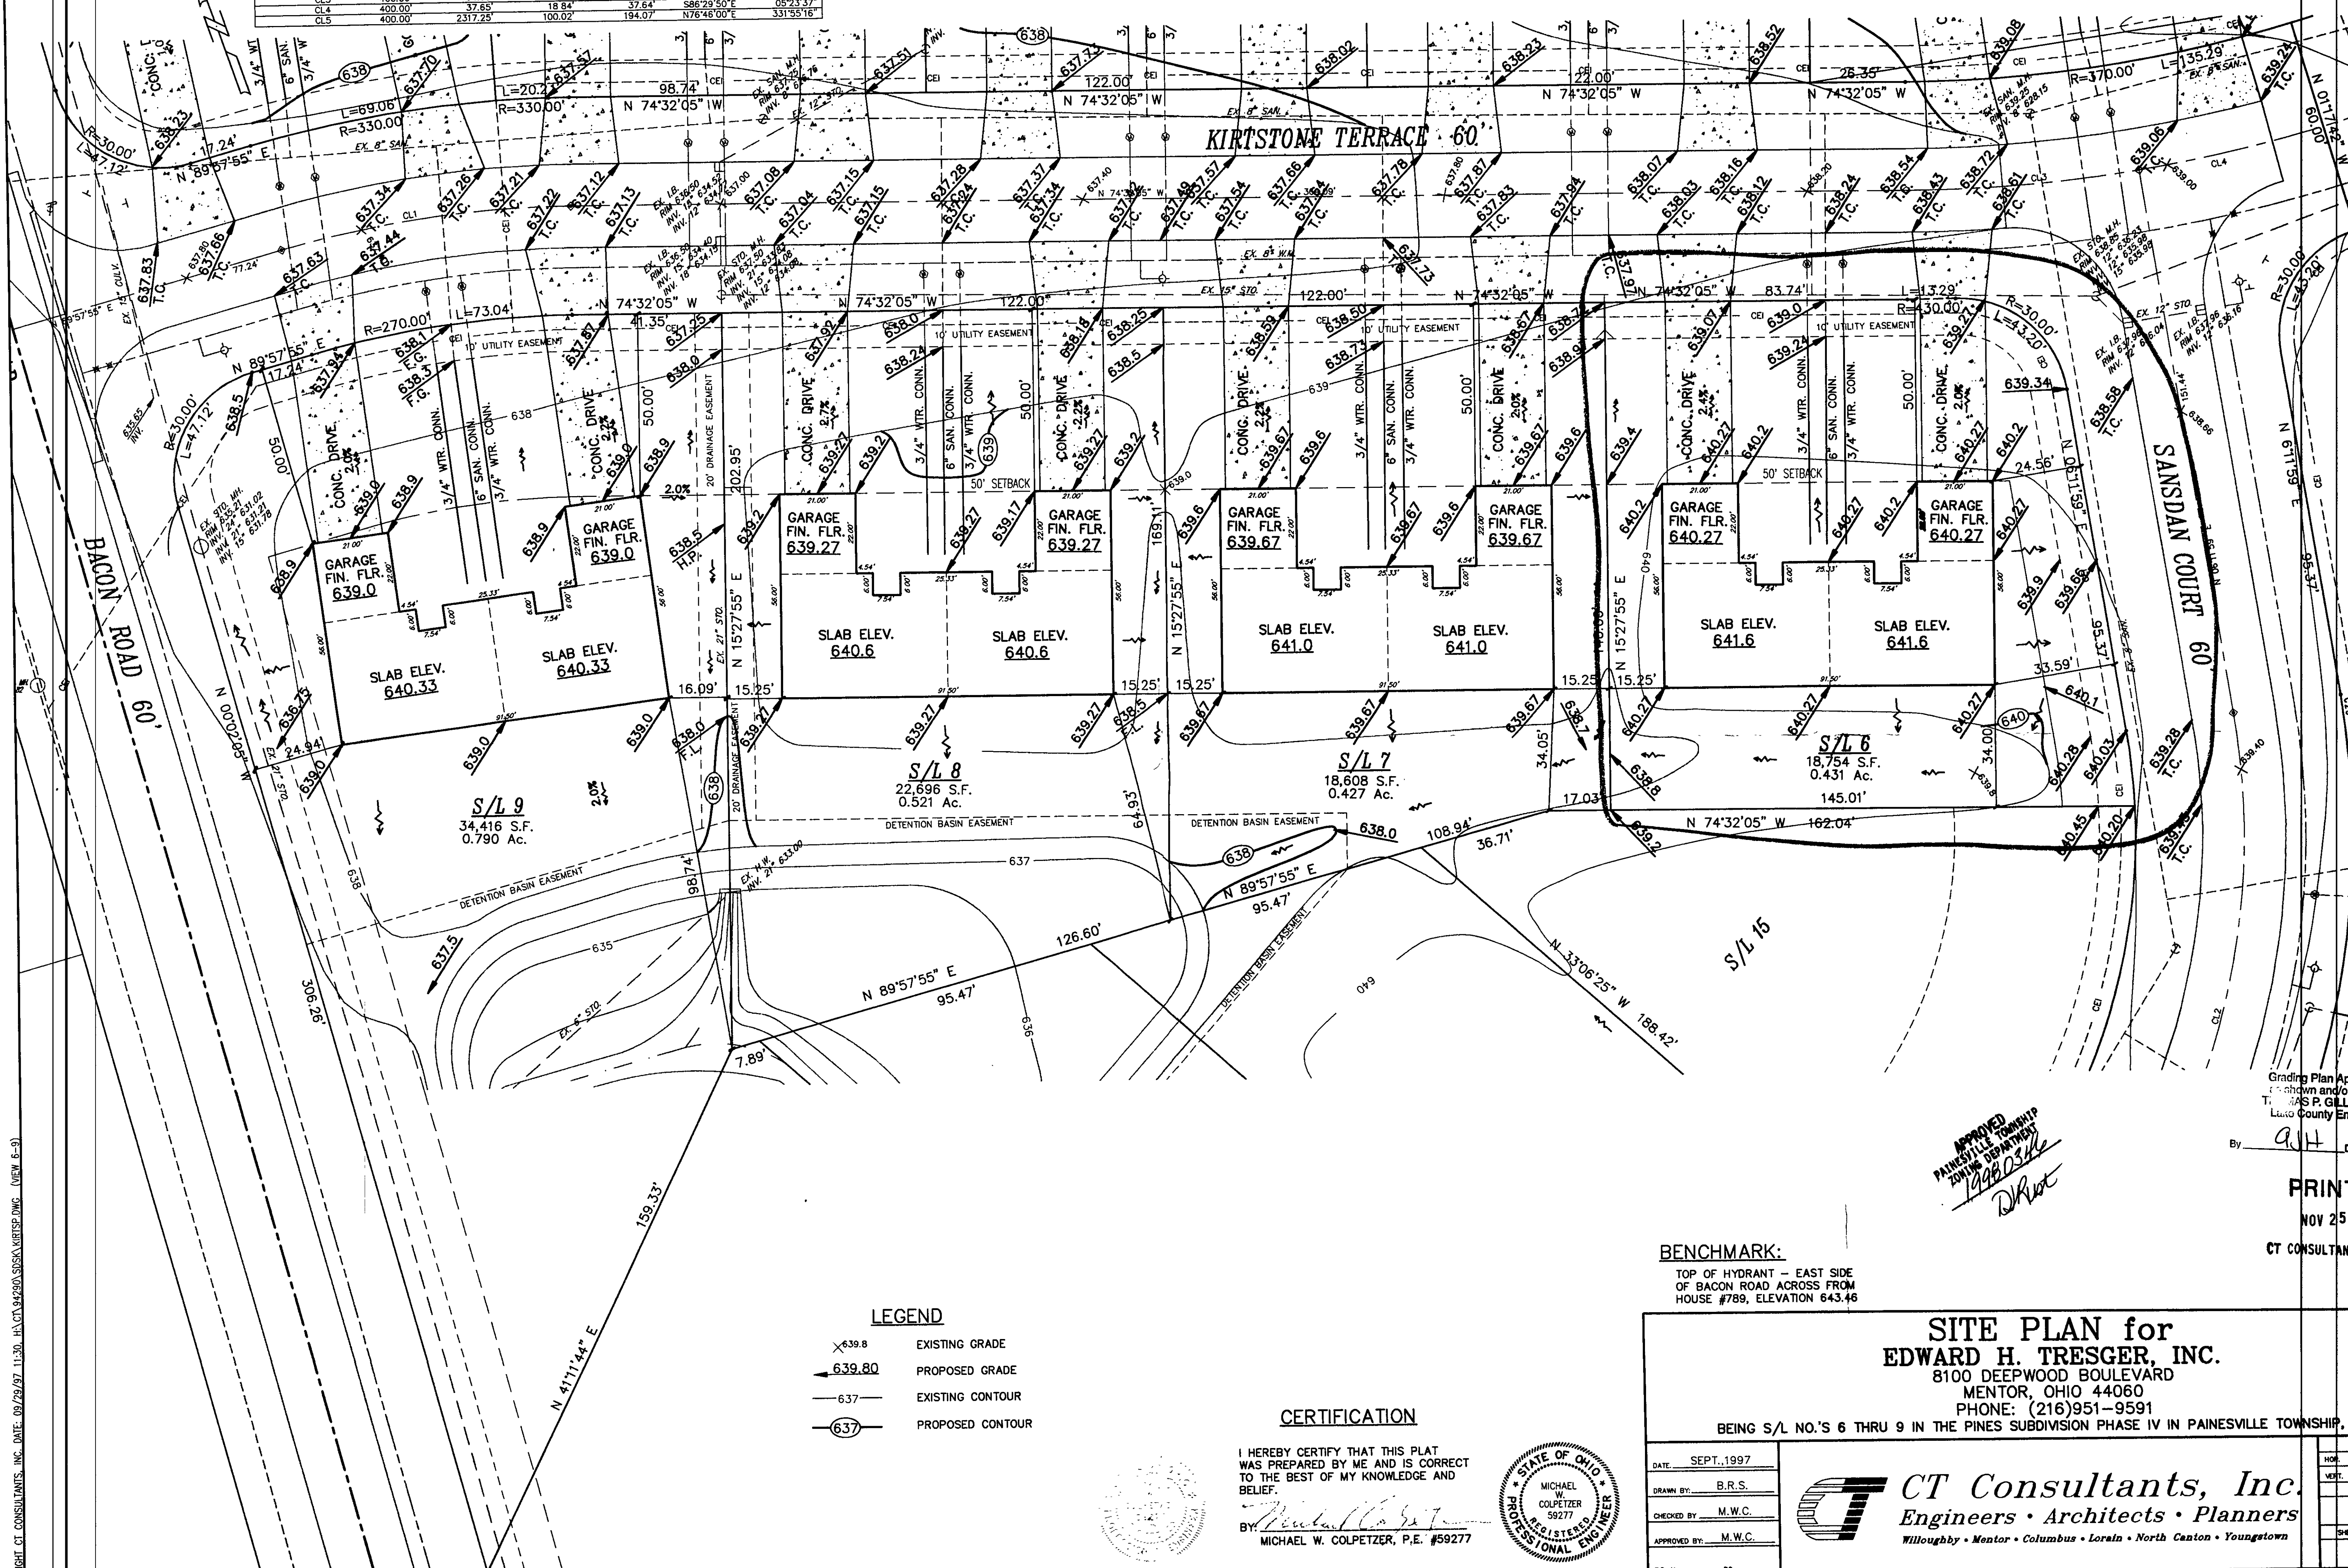


LEGEND

- ✕ 639.8 EXISTING GRADE
- 639.80 PROPOSED GRADE
- 637 EXISTING CONTOUR
- 637 PROPOSED CONTOUR

CERTIFICATION

I HEREBY CERTIFY THAT THIS PLAT WAS PREPARED BY ME AND IS CORRECT TO THE BEST OF MY KNOWLEDGE AND BELIEF.

BY: *Michael W. Colpetzer*
MICHAEL W. COLPETZER, P.E. #59277

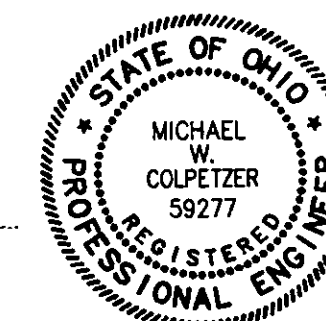

BENCHMARK:

TOP OF HYDRANT - EAST SIDE OF BACON ROAD ACROSS FROM HOUSE #789, ELEVATION 643.46

SITE PLAN for
EDWARD H. TRESGER, INC.
8100 DEEPWOOD BOULEVARD
MENTOR, OHIO 44060
PHONE: (216)951-9591

BEING S/L NO.'S 6 THRU 9 IN THE PINES SUBDIVISION PHASE IV IN PAINESVILLE TOWNSHIP, OHIO

DATE	SEPT. 1997
DRAWN BY	B.R.S.
CHECKED BY	M.W.C.
APPROVED BY	M.W.C.
F.B. No.	PG



CT Consultants, Inc.
Engineers • Architects • Planners
Willoughby • Mentor • Columbus • Lorain • North Canton • Youngstown

SHEET NO.		OF
1		1

Grading Plan Approved
and/or noted
T. J. GILES, P.E.
By: *A.J.H.* Date: *12.10.98*

PRINTED

NOV 25 1998

CT CONSULTANTS, INC.