
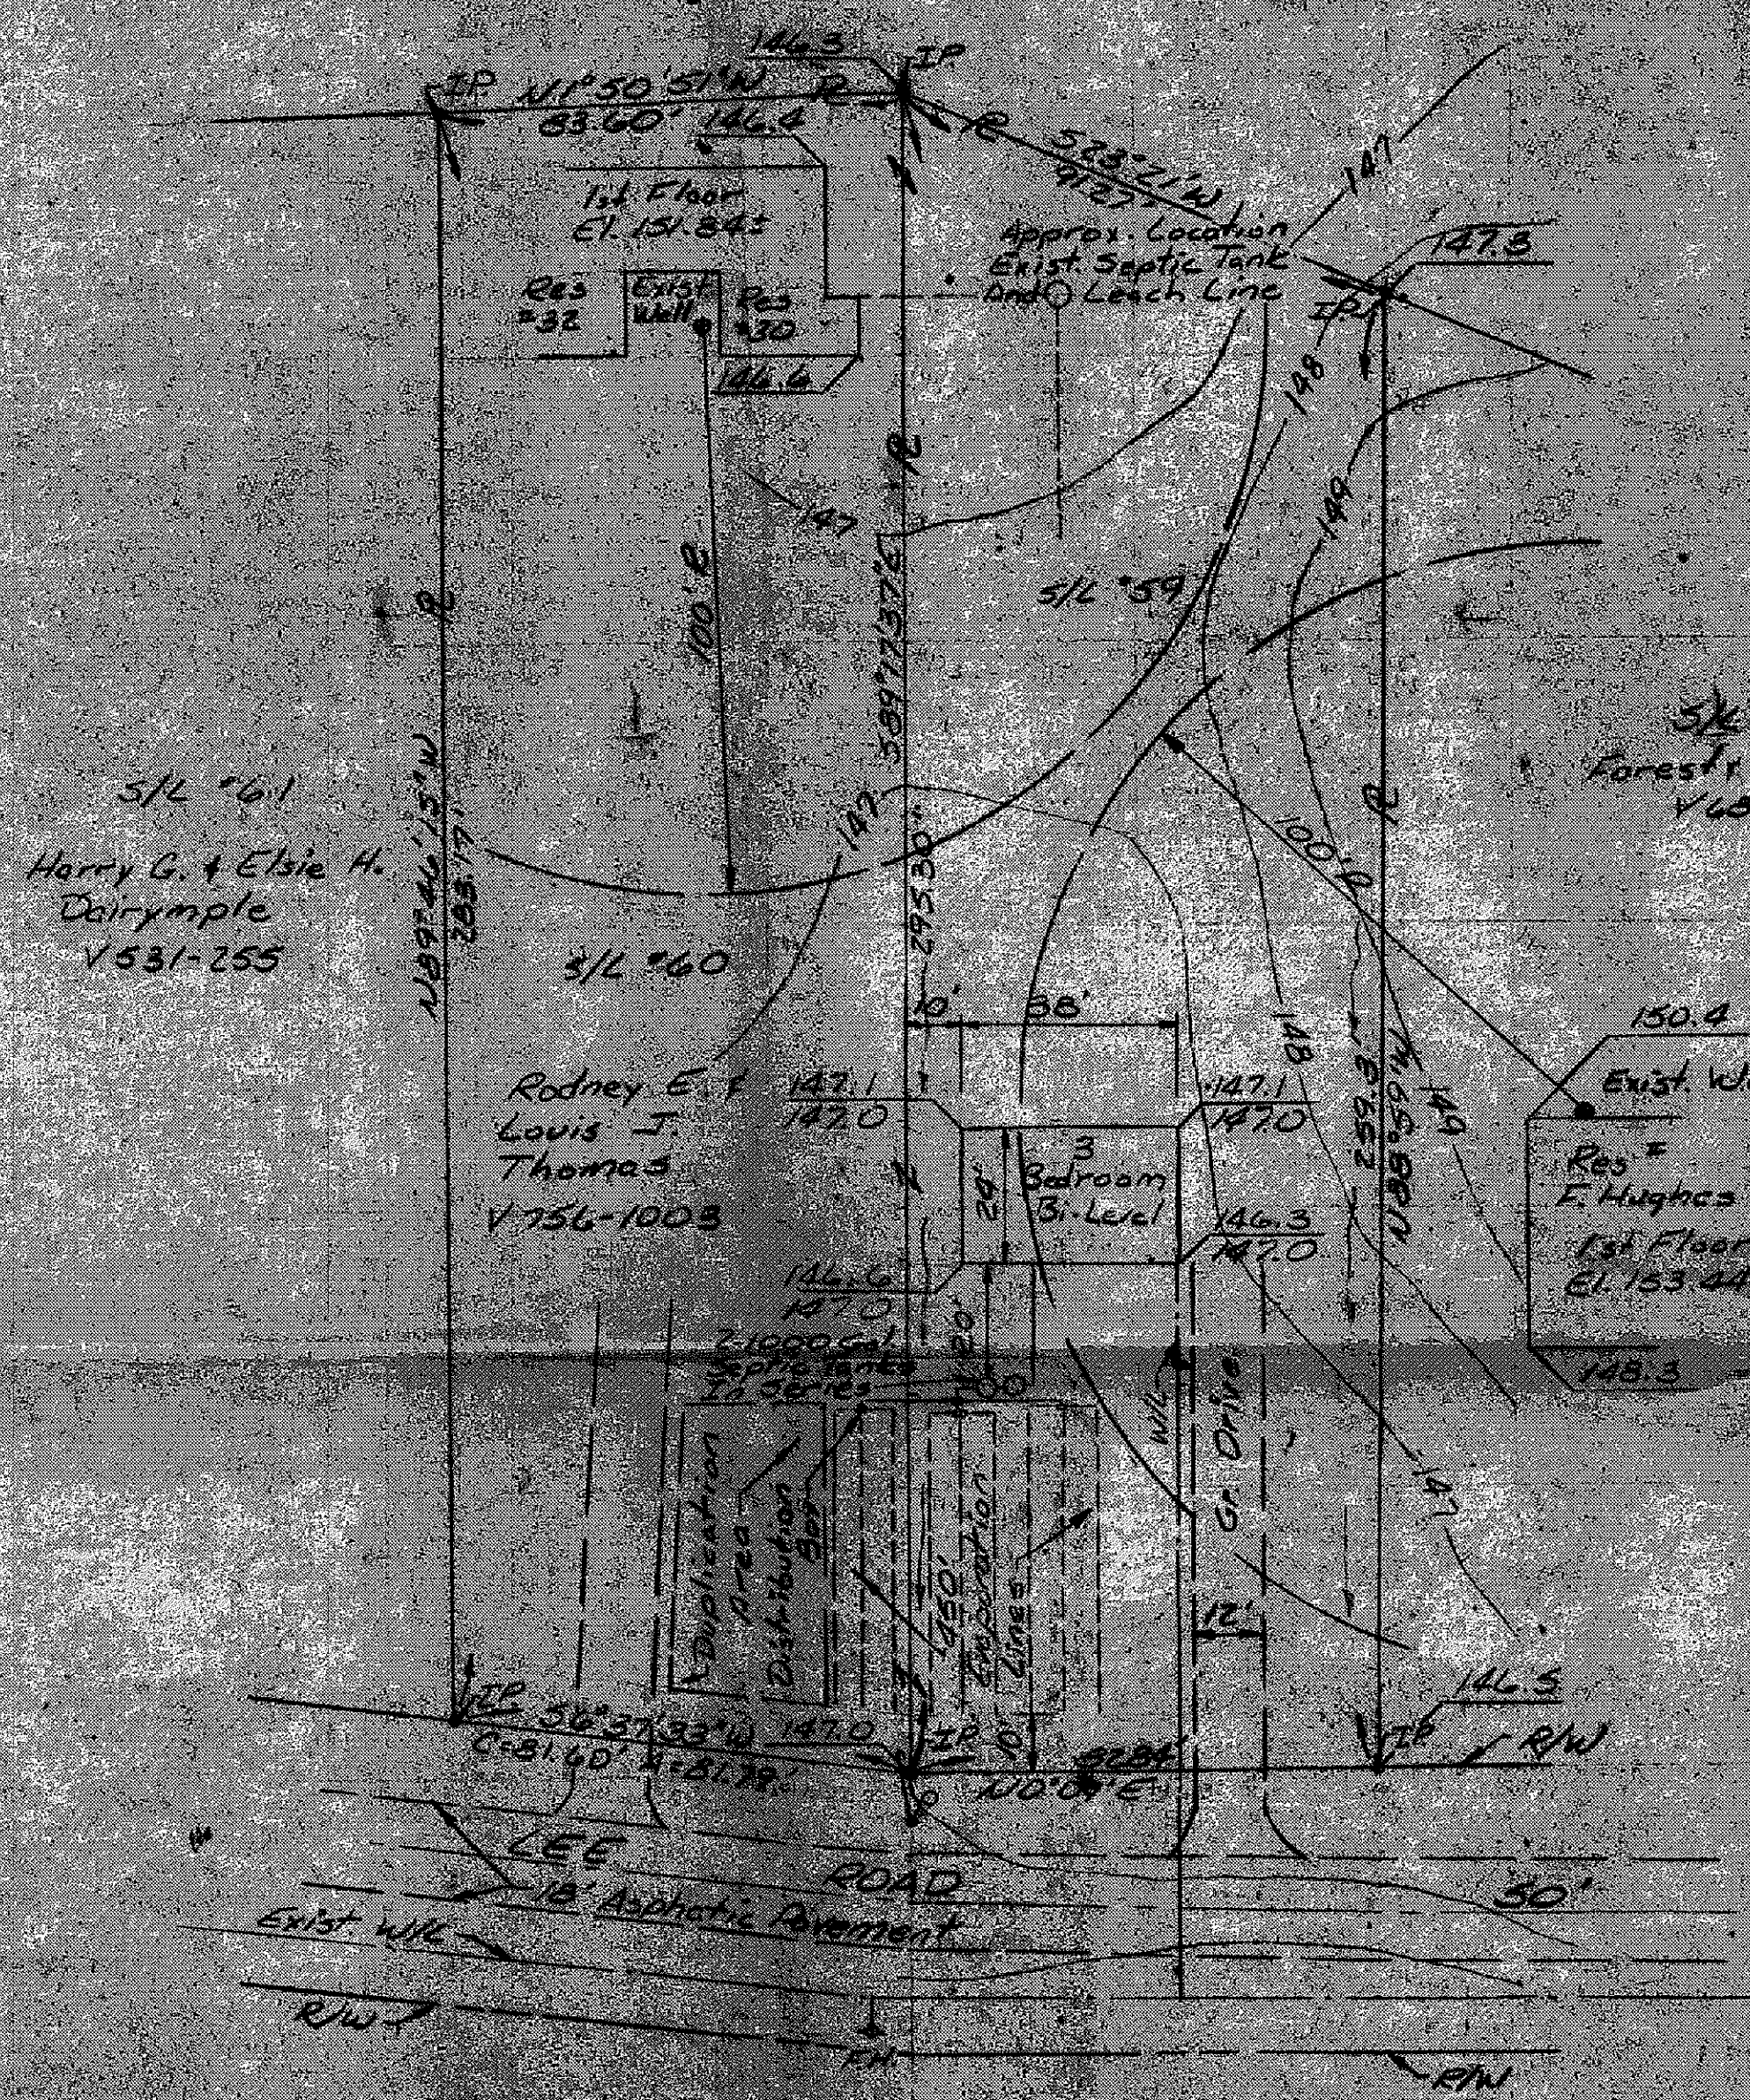


PAINESVILLE TOWNSHIP
ZONING APPROVED
#4272 3-26-77
Gregory J. Anderson
Zoning Inspector

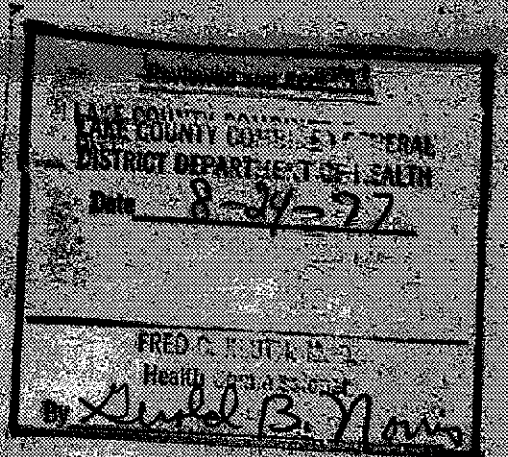

1. To be brought to finished grade
2. Septic tank manhole covers
3. Splitter box cover
4. Driveway on box cover
5. Vets pits
6. No fire or fuel in driveway
7. No fire or fuel in septic tank
8. All work to be done in accordance with

"BENCH MARK"
Top of 1st Floor Hydrant
on East Side of Lee Road
Across from PP-355912
Elevation Set at 150.00.

SITE PLAN

Painesville Township LAKE COUNTY

FOR: Custom Contract Homes, Rodney E. Hughes

32 Lee Road Painesville

Subdivision	11112	LOT	756
59160	Lee Road	VOLUME	0
SUBLOT NO.	STREET	PERM. PARCEL NO.	

LEGEND	
PROPERTY LINE	INDICATES DIRECTION
AS-BUILT ELEVATION	SURFACE DRAIN
EXISTING CONTOURS	
PROPOSED CONTOURS	
EXIST. ELEV.	PROPOSED ELEV.

REMARKS

DESIGN CERTIFICATION
THIS PLAN WAS PREPARED BY ME, AND IS CORRECT TO THE BEST OF MY KNOWLEDGE AND BELIEF.
Harry Jones Jr. 3-6-77
NAME SURVEYOR REGISTRATION

CHECK LIST	
NO. OF BEDROOMS	
DIMENSIONS	
REARINGS	
TO NEAREST STREET	
SUBLOT NO. PARCEL	
SURROUNDING OWNERS	
WELL DEPTH/TYPE/IN. IN	
WELL TYPE FOR GRADES	
APPROX TYPE WITH THICKNESS	
STORMWATER TYPE WITH THICKNESS	
CONCRETE TYPE DIA. LENGTH	

REVISIONS			PLAN PREPARED BY	
NO.	DATE	BY		
1			Harry Jones Jr. P.E.	
2			John T. Radcliffe	
3			DRAWN BY	SCALE 1"=30'
4			CHECKED	DATE Aug. 16, 77
5				

"AS BUILT" CERTIFICATION
I HEREBY CERTIFY THAT THE CIRCLED GRADES EXISTING FINISH GRADES CHECKED IN FIELD ARE CORRECT TO THE BEST OF MY KNOWLEDGE AND BELIEF.

REGISTERED SURVEYOR REGISTRATION

Grading Plan Approved
as shown and/or noted
THOMAS P. GILLES, P.E.
Lake County Engineer
Date 26 Aug 77