




**EDWARD H. TRESGER, INC.**  
8100 DEEPWOOD BOULEVARD

REG SURVEYOR NO. **12811**

REG SURVEYOR NO. \_\_\_\_\_

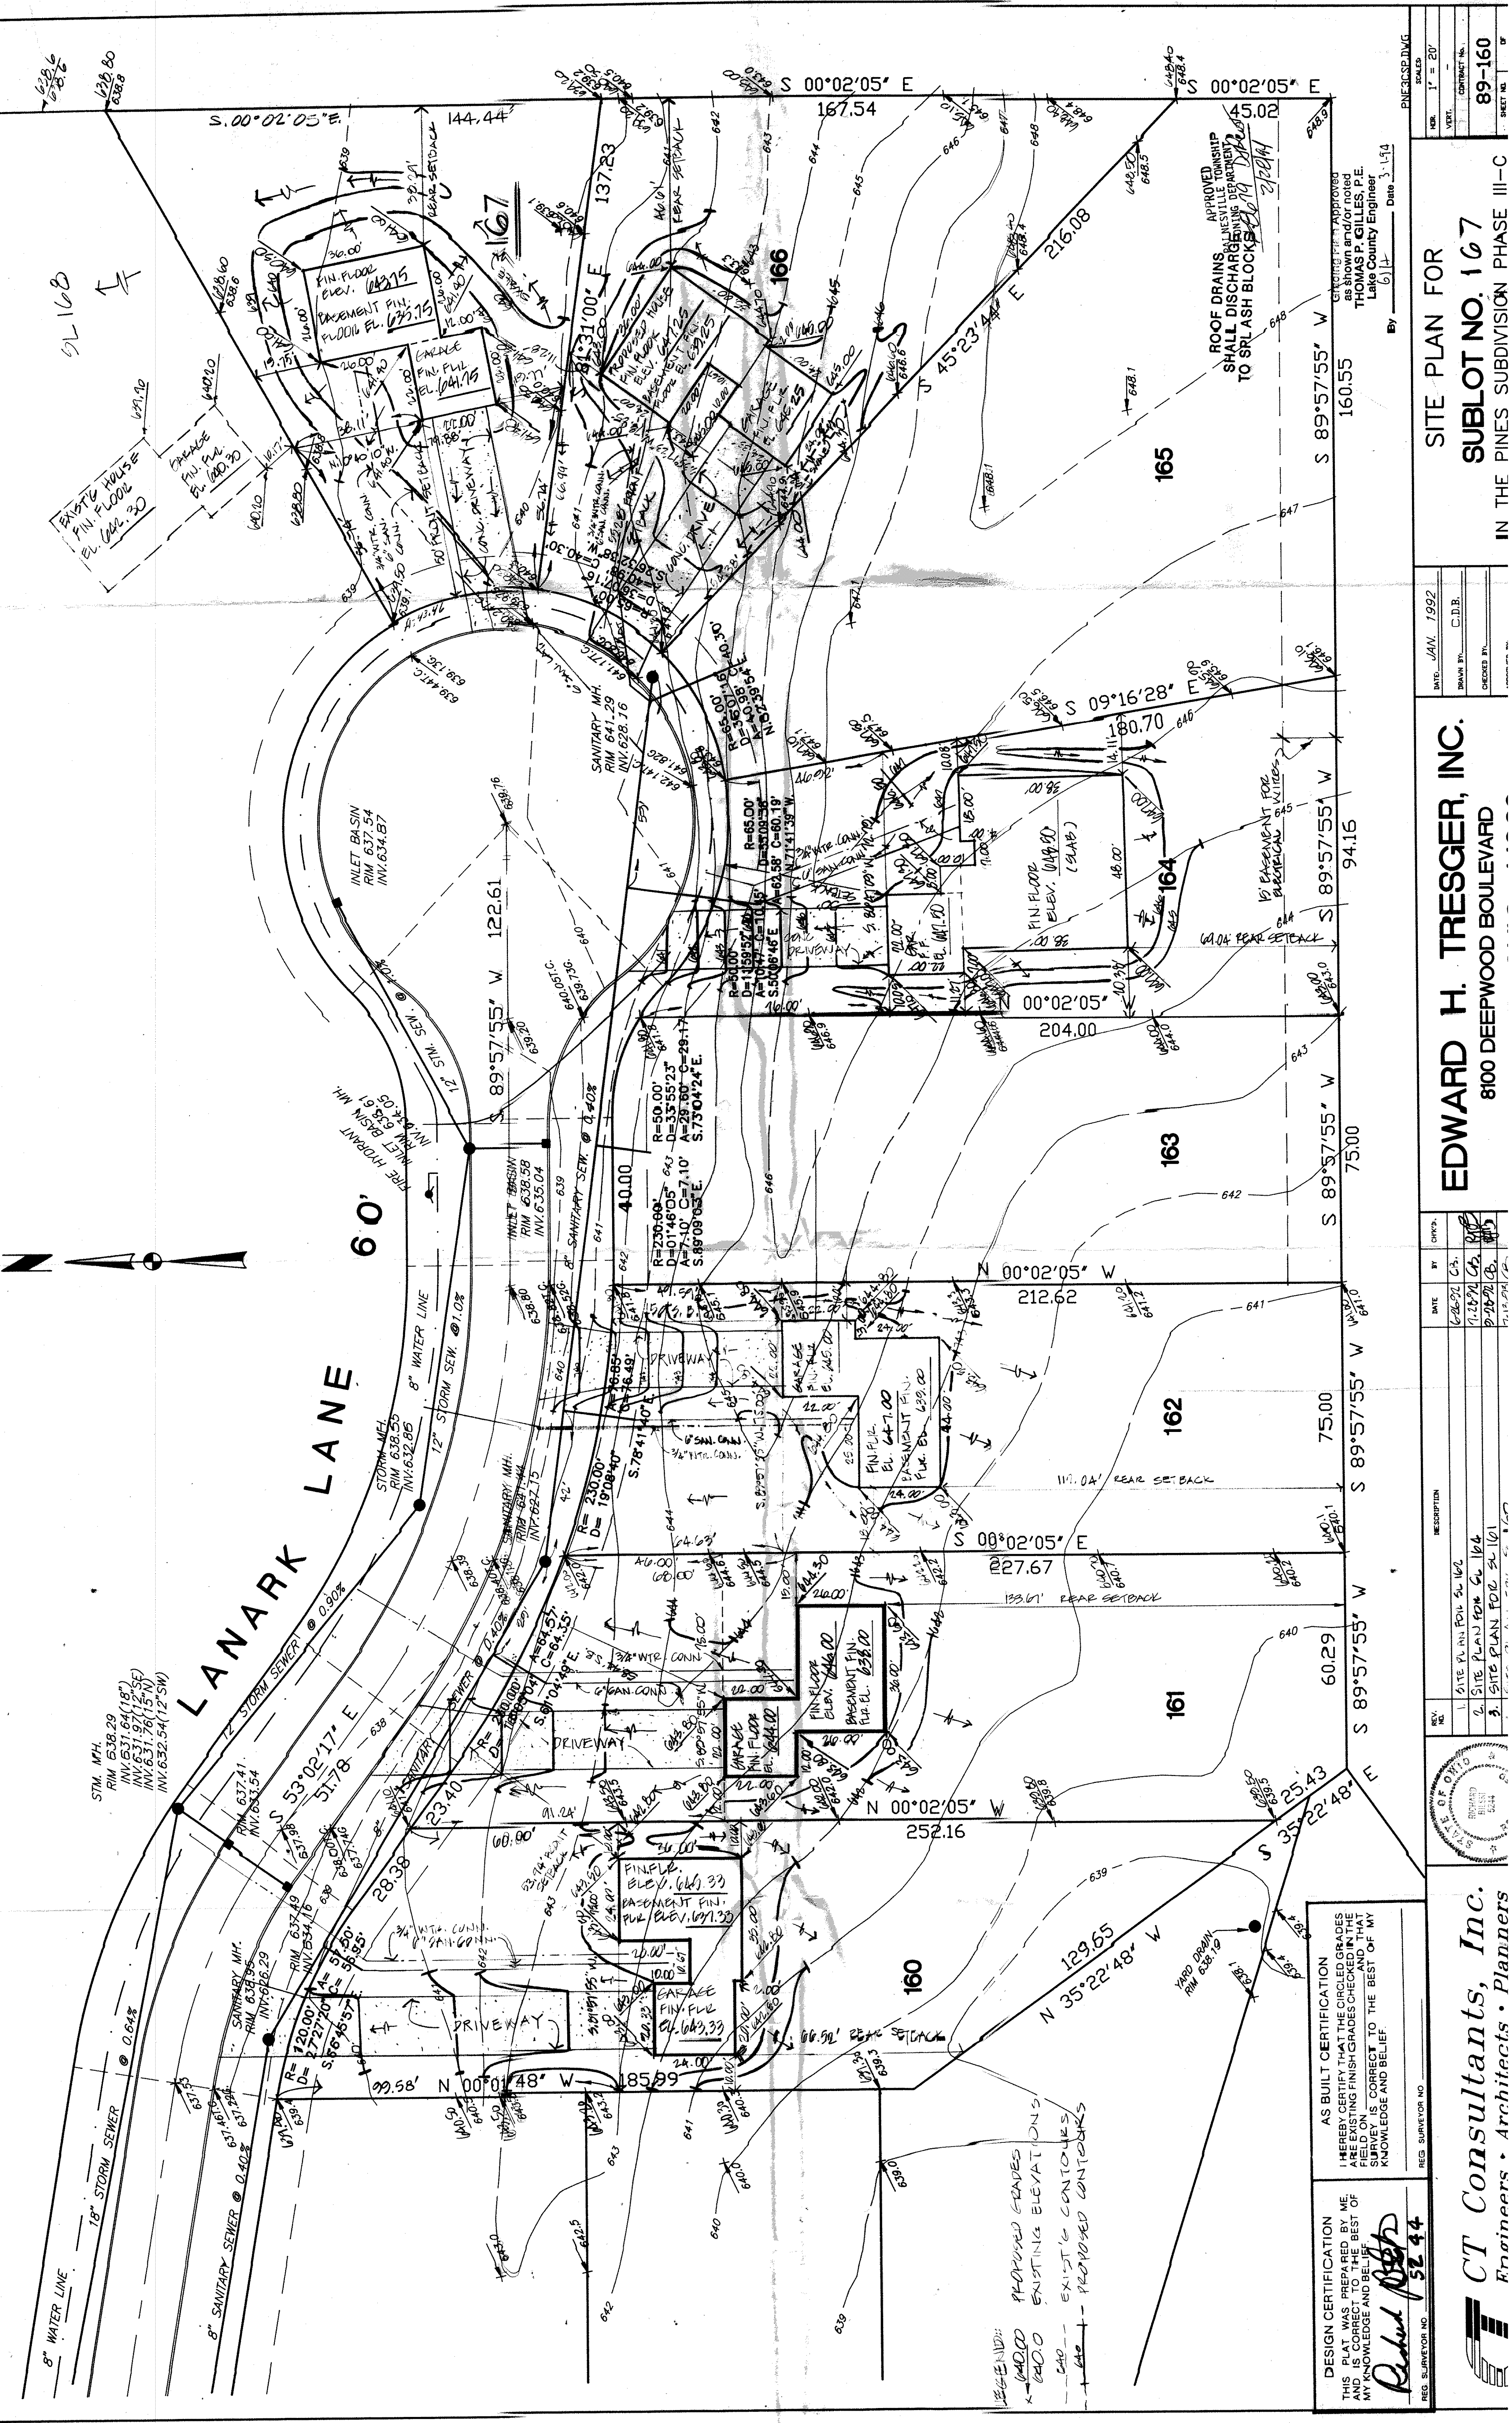

**CT Consultants, Inc.**  
*Engineers • Architects • Planners*

**SITE PLAN FOR  
SUBLOT NO. 167  
IN THE PINES SUBDIVISION PHASE**

|              |          |
|--------------|----------|
| HDR.         | 1' = 20' |
| VERT.        | -        |
| CONTRACT NO. |          |
| 89-160       |          |
| SHEET NO.    | OF       |