


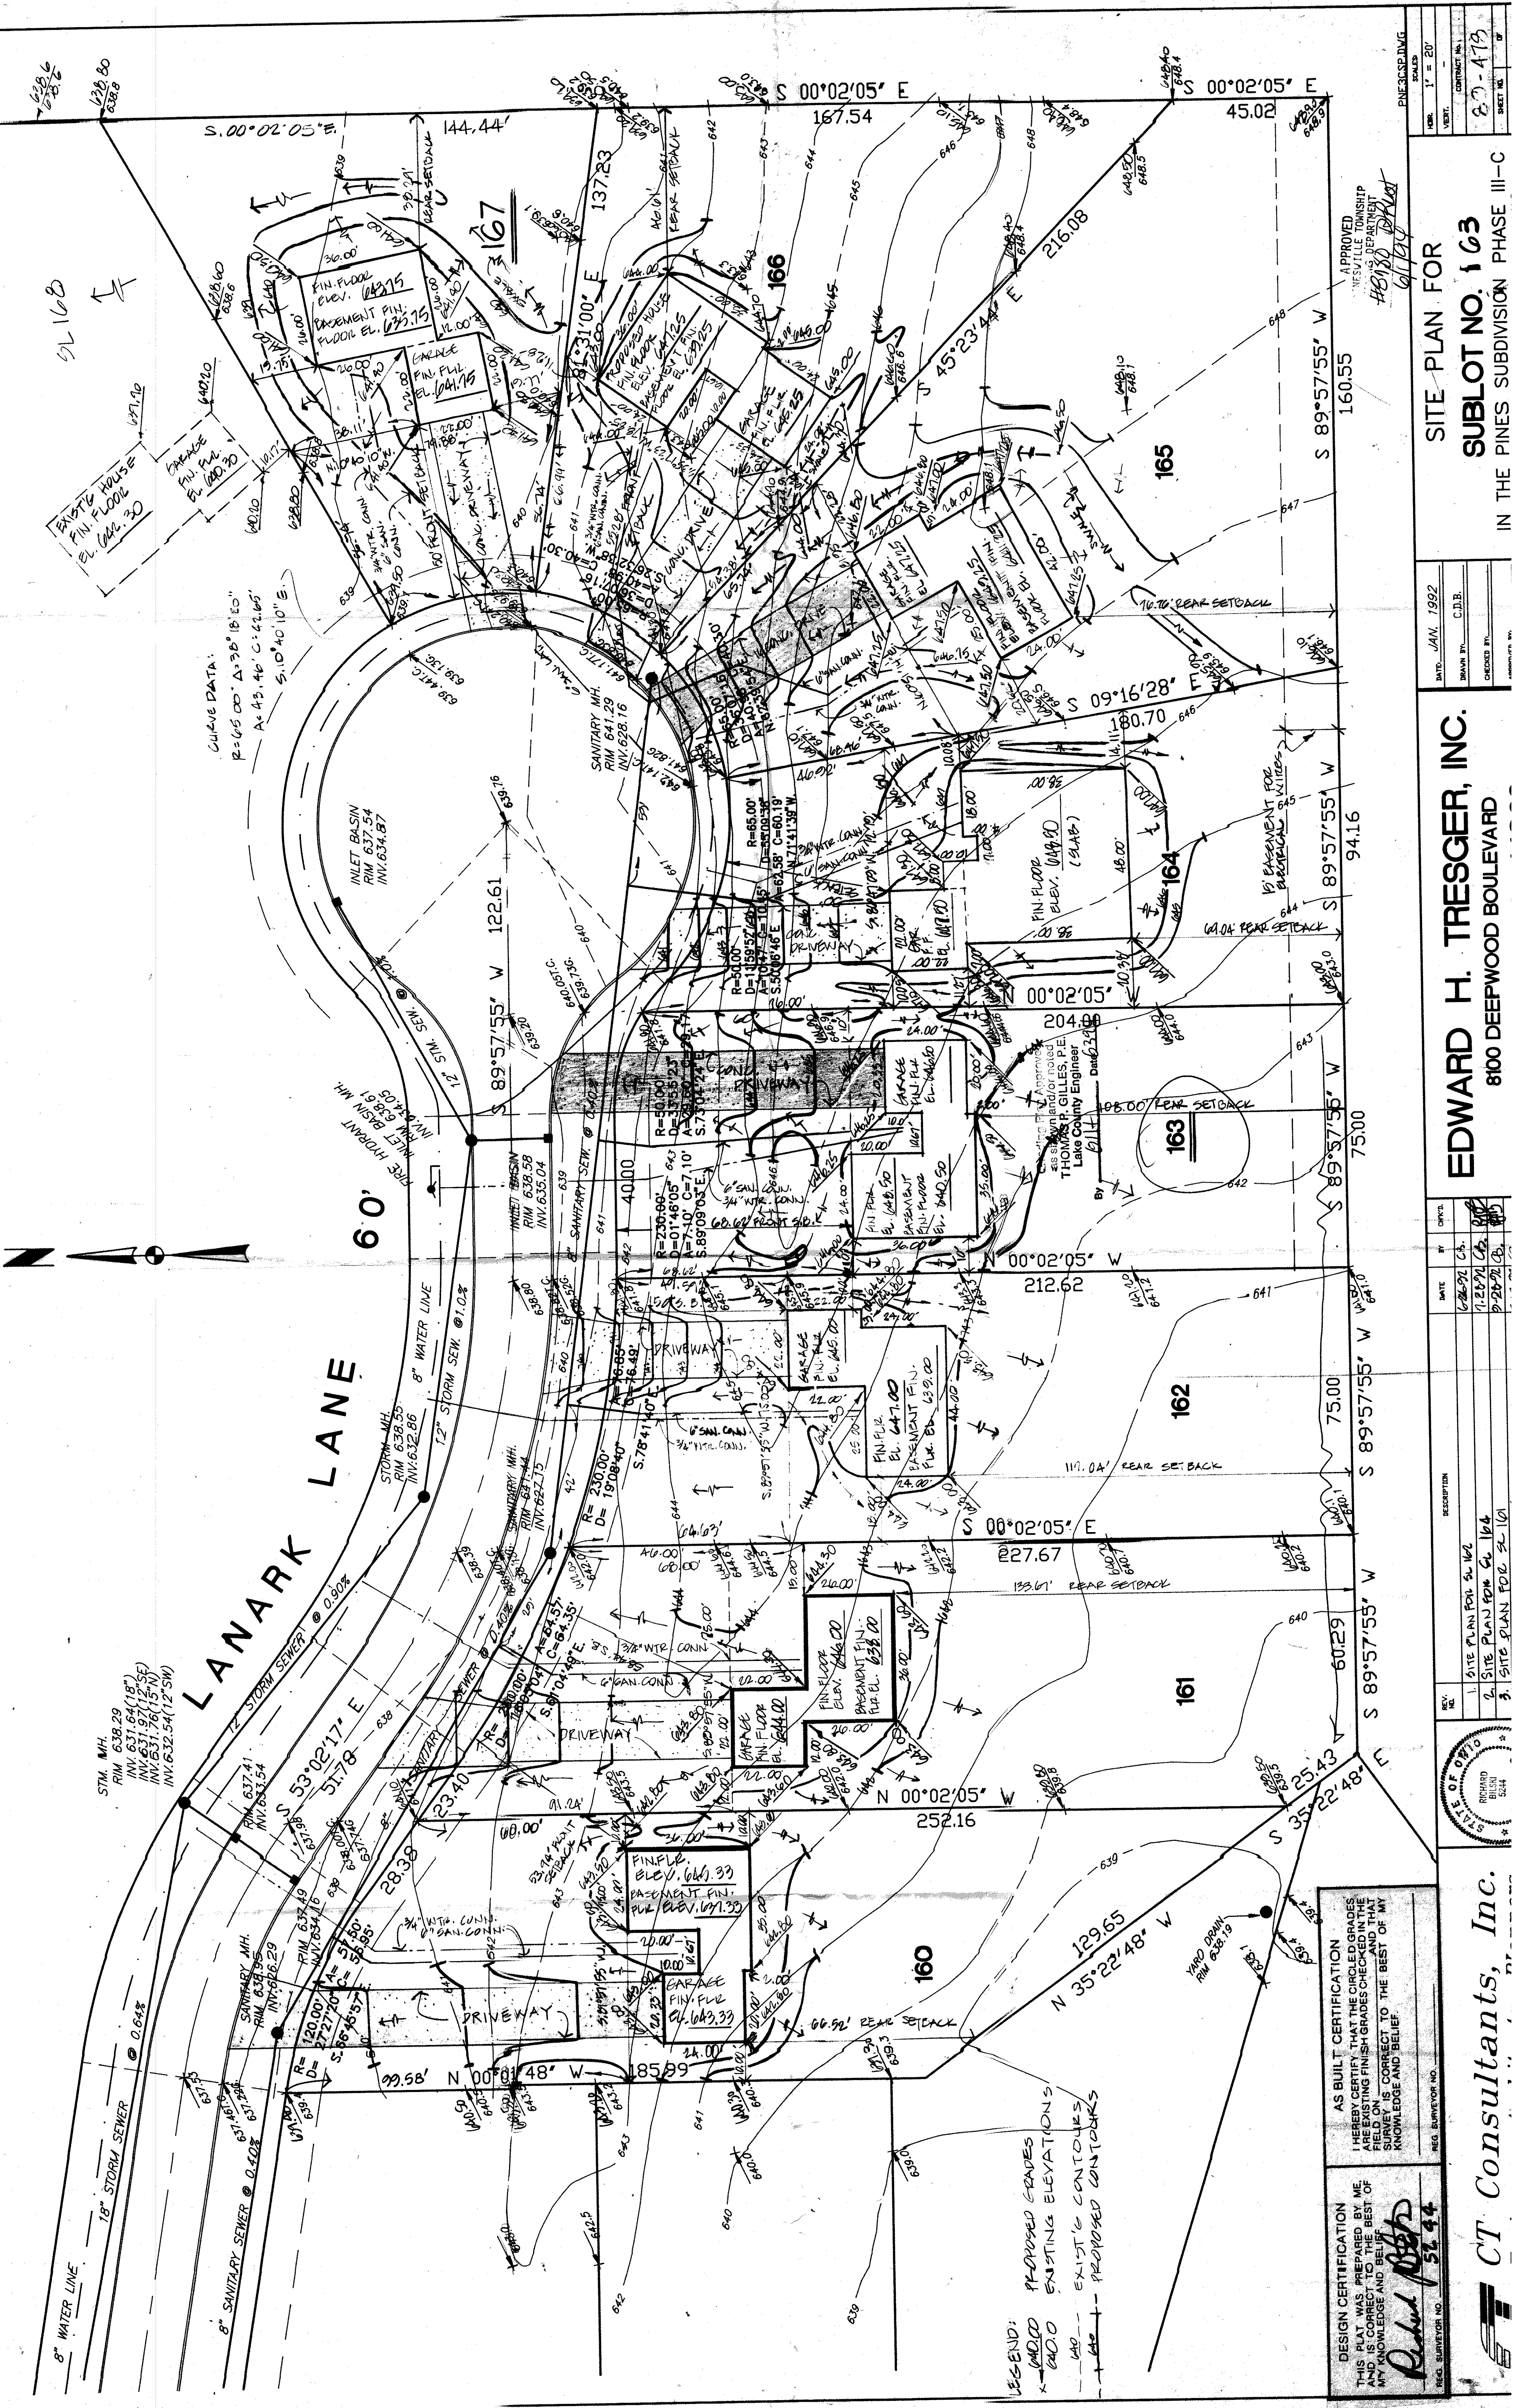

JAN. 1992

SITE PLAN FOR

SUBLOT NO. 163

IN THE PINES SUBDIVISION PHASE III-C

EDWARD H. TRESGER, INC.

8100 DEEPWOOD BOULEVARD

REV. NO.	DESCRIPTION	DATE	BY	CHKD.

Consultants, Inc.



CT Consultants, Inc.