


LANARK LANE 60'

WICKHAM PLACE

- PROPOSED GRADES
- EXISTING ELEVATIONS
- EXISTING CONTOURS
- PROPOSED CONTOURS

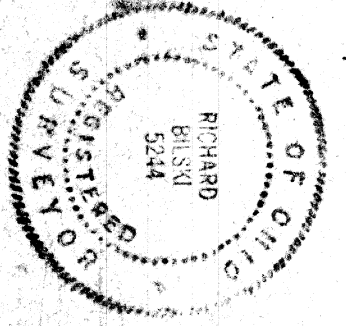

DESIGN CERTIFICATION:
I HEREBY CERTIFY THAT THIS
PLAN IS CORRECT TO THE BEST OF
MY KNOWLEDGE AND BELIEF.
Richard J. Blasz
P.E.

DATE 10/1/86

SCALE 1"=40'

DRAWN BY CFB

CHECKED BY

P.E.

COLPETZER & WOODS

CONSULTANTS, INC.

MENTOR, OHIO 44060

SITE PLAN FOR:

EDWARD H. TRESSEGER, INC.

8100 DEERWOOD BLVD. MENTOR, OHIO

BEING SUBJECT NO. 179 IN THE PLATS SUBDIVISION NO. 2, IN PAINESVILLE TWP., OHIO

Grading Plan Approved as shown and/or noted

THOMAS P. GILLES, P.E.

Lake County Engineer

By Blasz Date 10-22-86

This Permit Expires OCT 23 1987


PAINESVILLE TOWNSHIP ZONING APPROVED

65472

William E. Munn

Engineering Inspector 10/22/86

BENCH MARK, TOP OF FIRE HYDRANT ELEV. 632.42

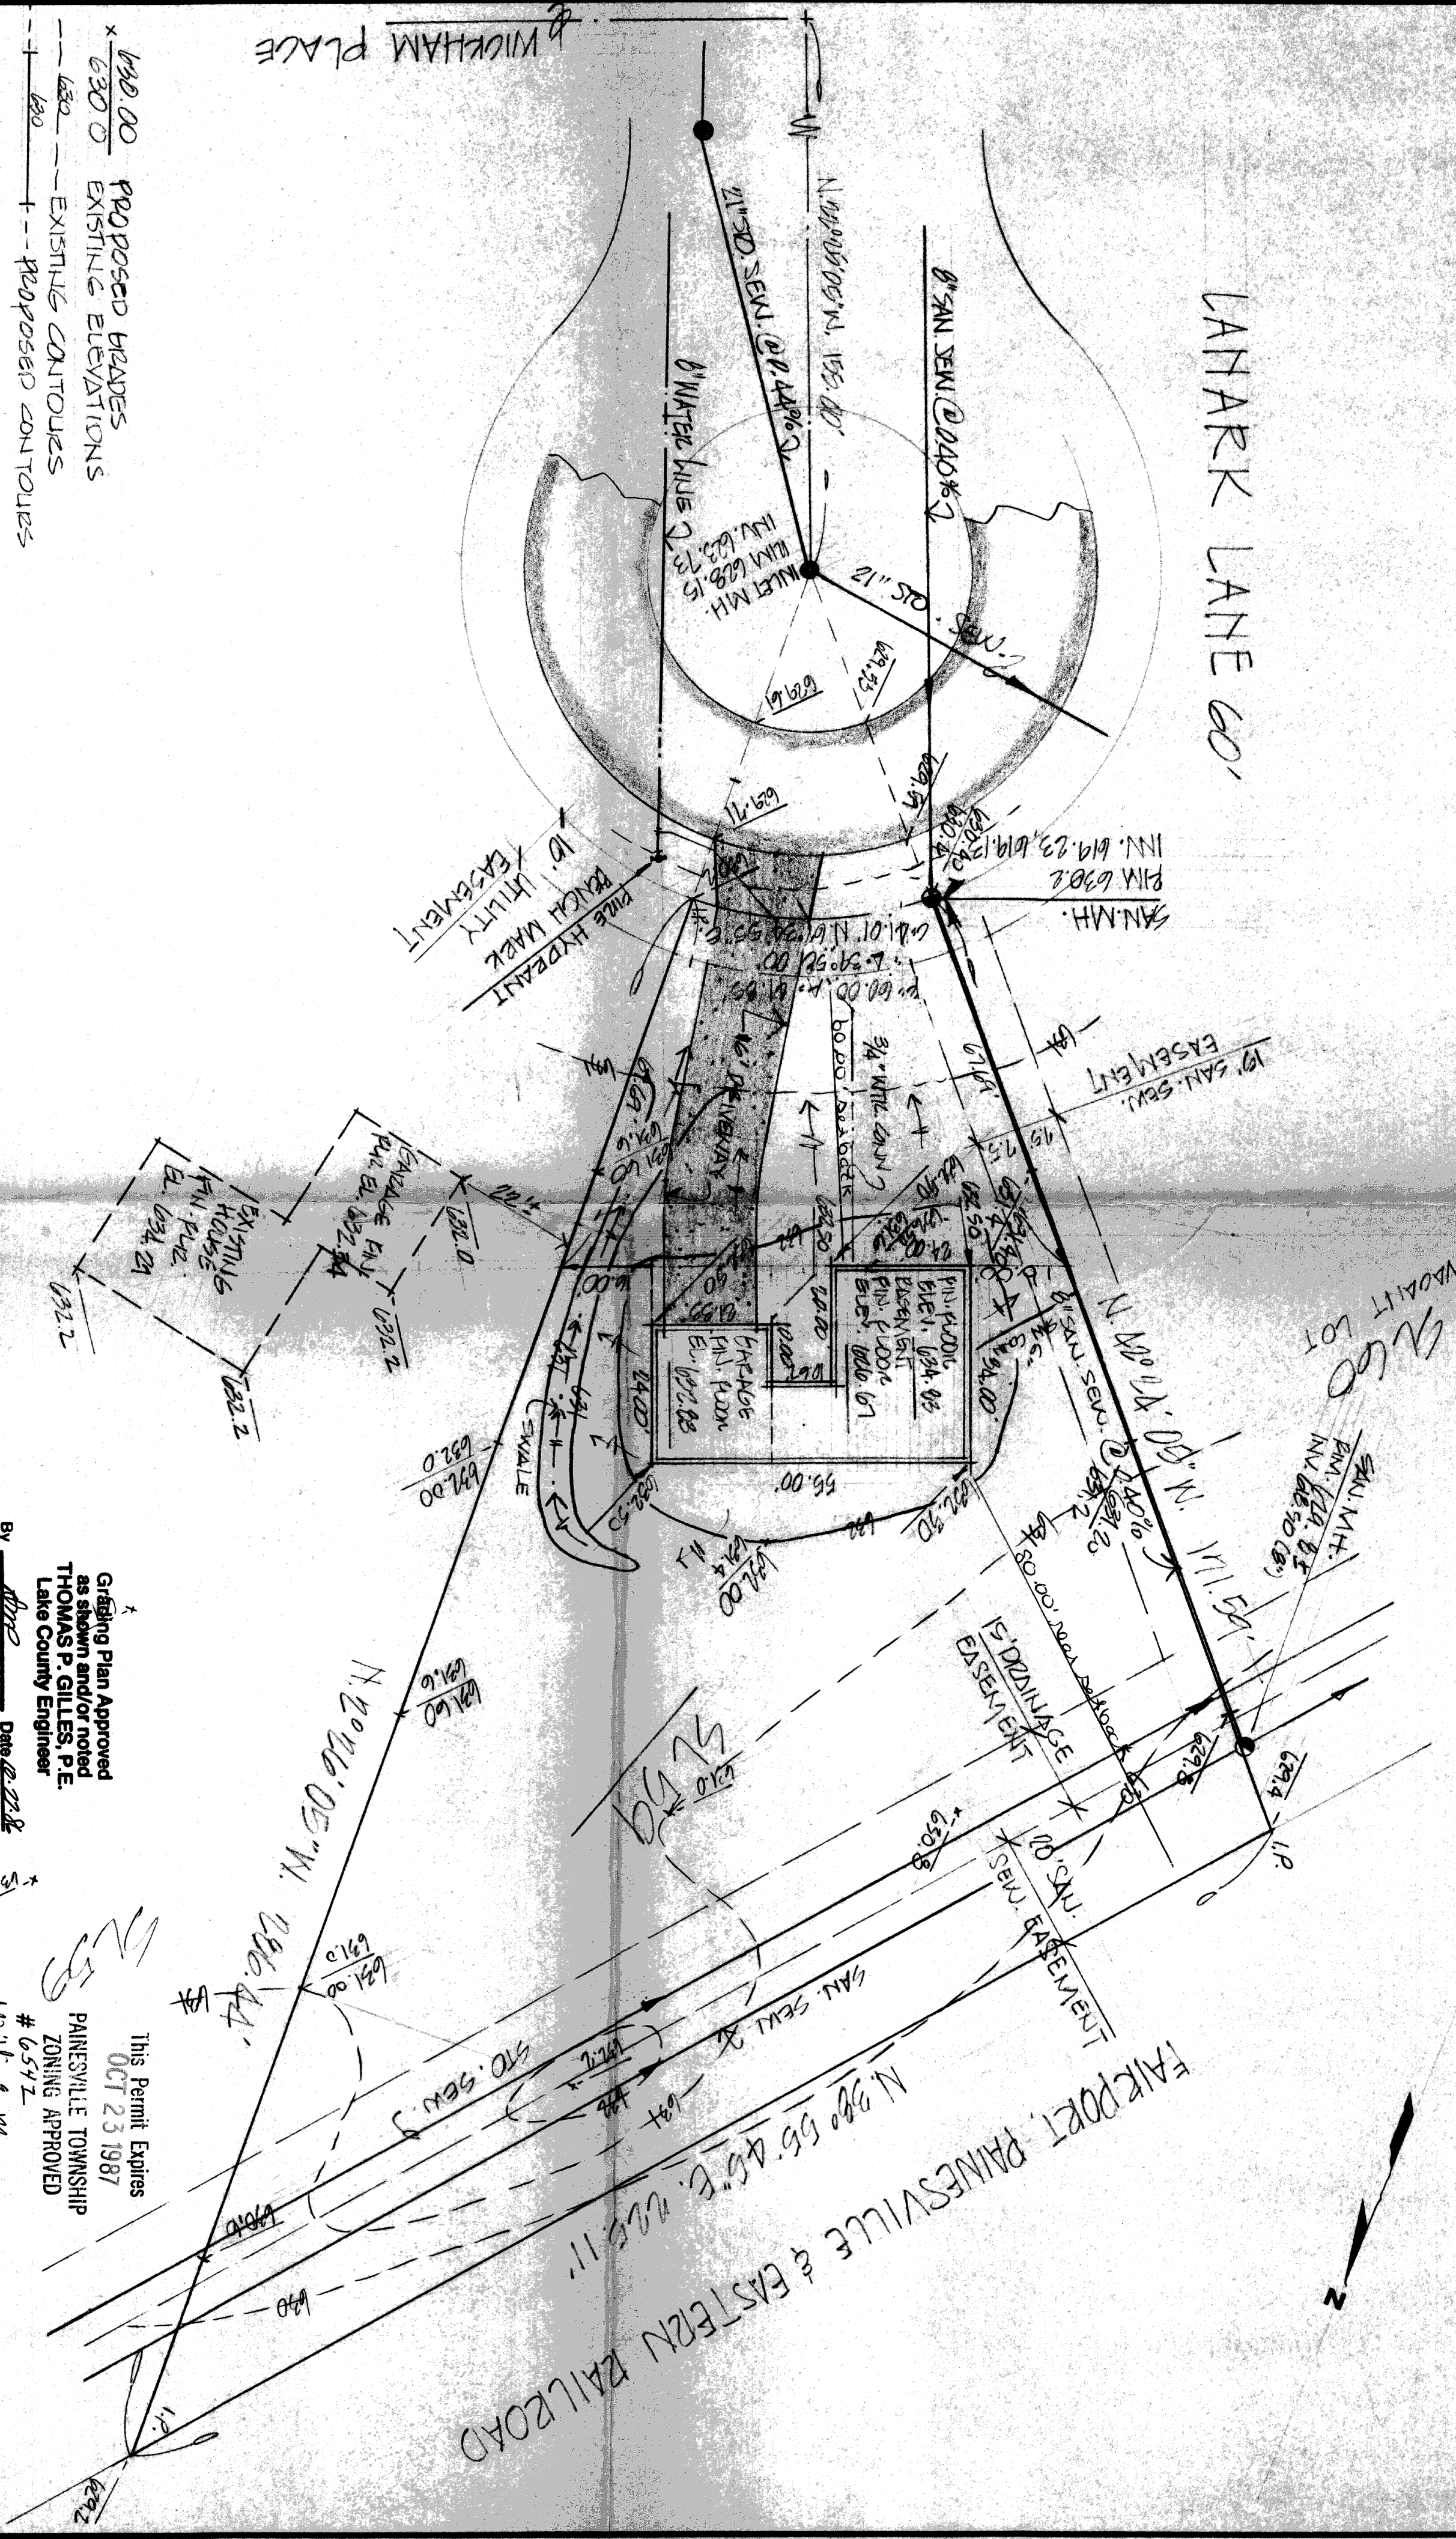

1505-9-1