


SITE PLAN
FOR
TED LYNDALL

Being Subject No. 6 to Special Order
Said No. 6 Township of Painesville,
Lake County, Ohio
Raymond Hill & Edward Lyndall
Vol. 552-982

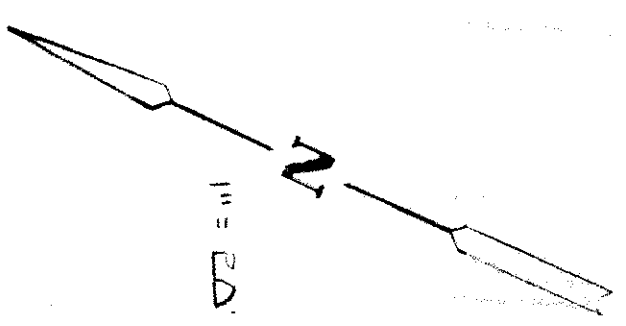

CURVE DATA - ★
Radius - 60.00'
Arc - 15.00'
Chords - 10.21'
Bearing - S 51° 38' 50" W

This Permit Expires
7/29/92
PAINESVILLE TOWNSHIP
ZONING APPROVED
#7892
Zoning Inspector
Grading Plan Approved
as shown and/or noted
THOMAS P. GILLES, P.E.
Lake County Engineer
By GJH Date 8/2/91
F-1000

VILLAGE SURVEYING CO.
202 Third St., Fairport Hg., Ohio 44017
(216) 357-1359

Phil Sup.

* GRINDER
PUMP REG'D IF
BASEMENT

1000 GAL. TANK
Elev 84.8
100 GAL. TANK
Elev 84.1

SPILLER
Elev 84.4
DIST. BOX
Elev 84.5


LOW YIELD WATER
FIXTURES REQUIRED
ON ALL:
Shower Head
Toilet

LAKE COUNTY GENERAL HEALTH DISTRICT
Date 7-25-91
JOEL LUCIA, R.S., M.P.H.
Health Commissioner
BY N. M. Lucia

HYDRAULIC PROFILE
VERT. 1" = 3' Horiz. 1" = 30'
3 Bedroom Home

SEWAGE DISPOSAL PERMIT MUST BE
OBTAINED BY A LAKE COUNTY LICENSED
INSTALLER BEFORE INSTALLATION IS
STARTED.

B. No footer drains or downspouts
to be discharged into septic tanks
C. All waste water to be discharged into
septic tanks

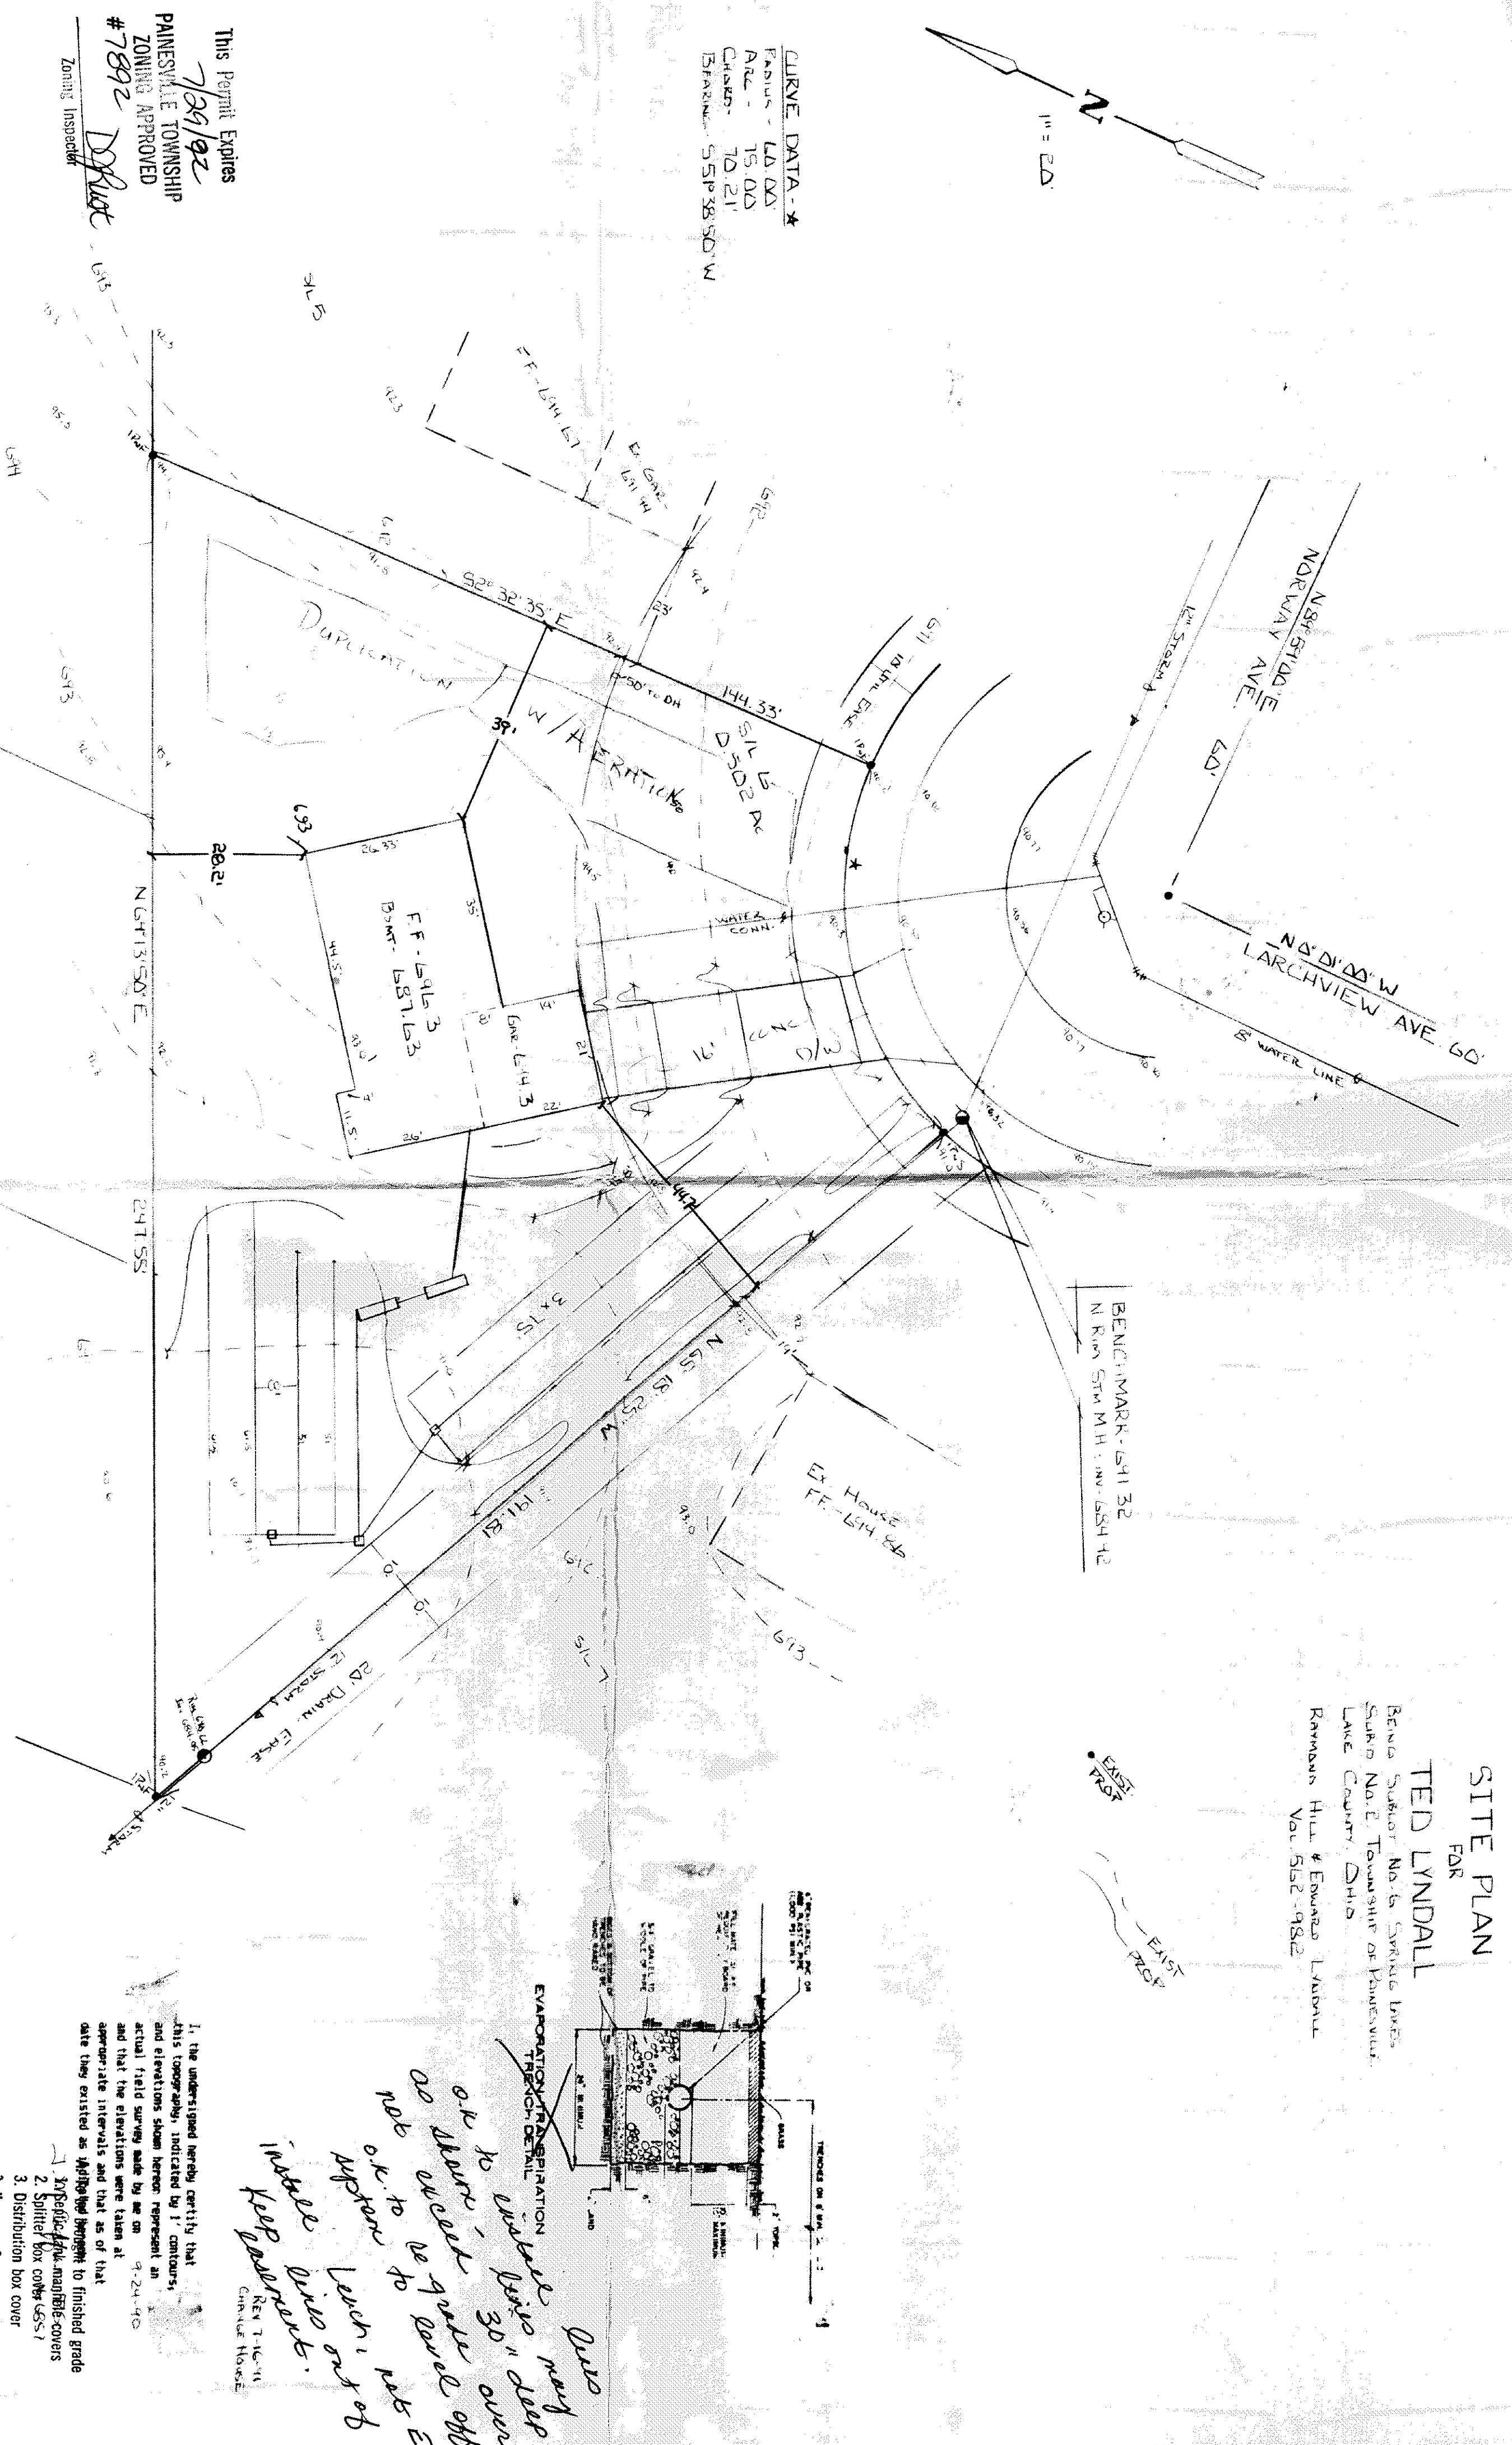

EVAPORATION TRANSPIRATION
TRENCH DETAIL
REV 7-16-91
CHARLIE HOWE