



I:\topokone\1\100001\cad\Site-plan.dwg Tue Aug 22 15:43:37 2000 Copyright Foresight Engineering Group, Inc.

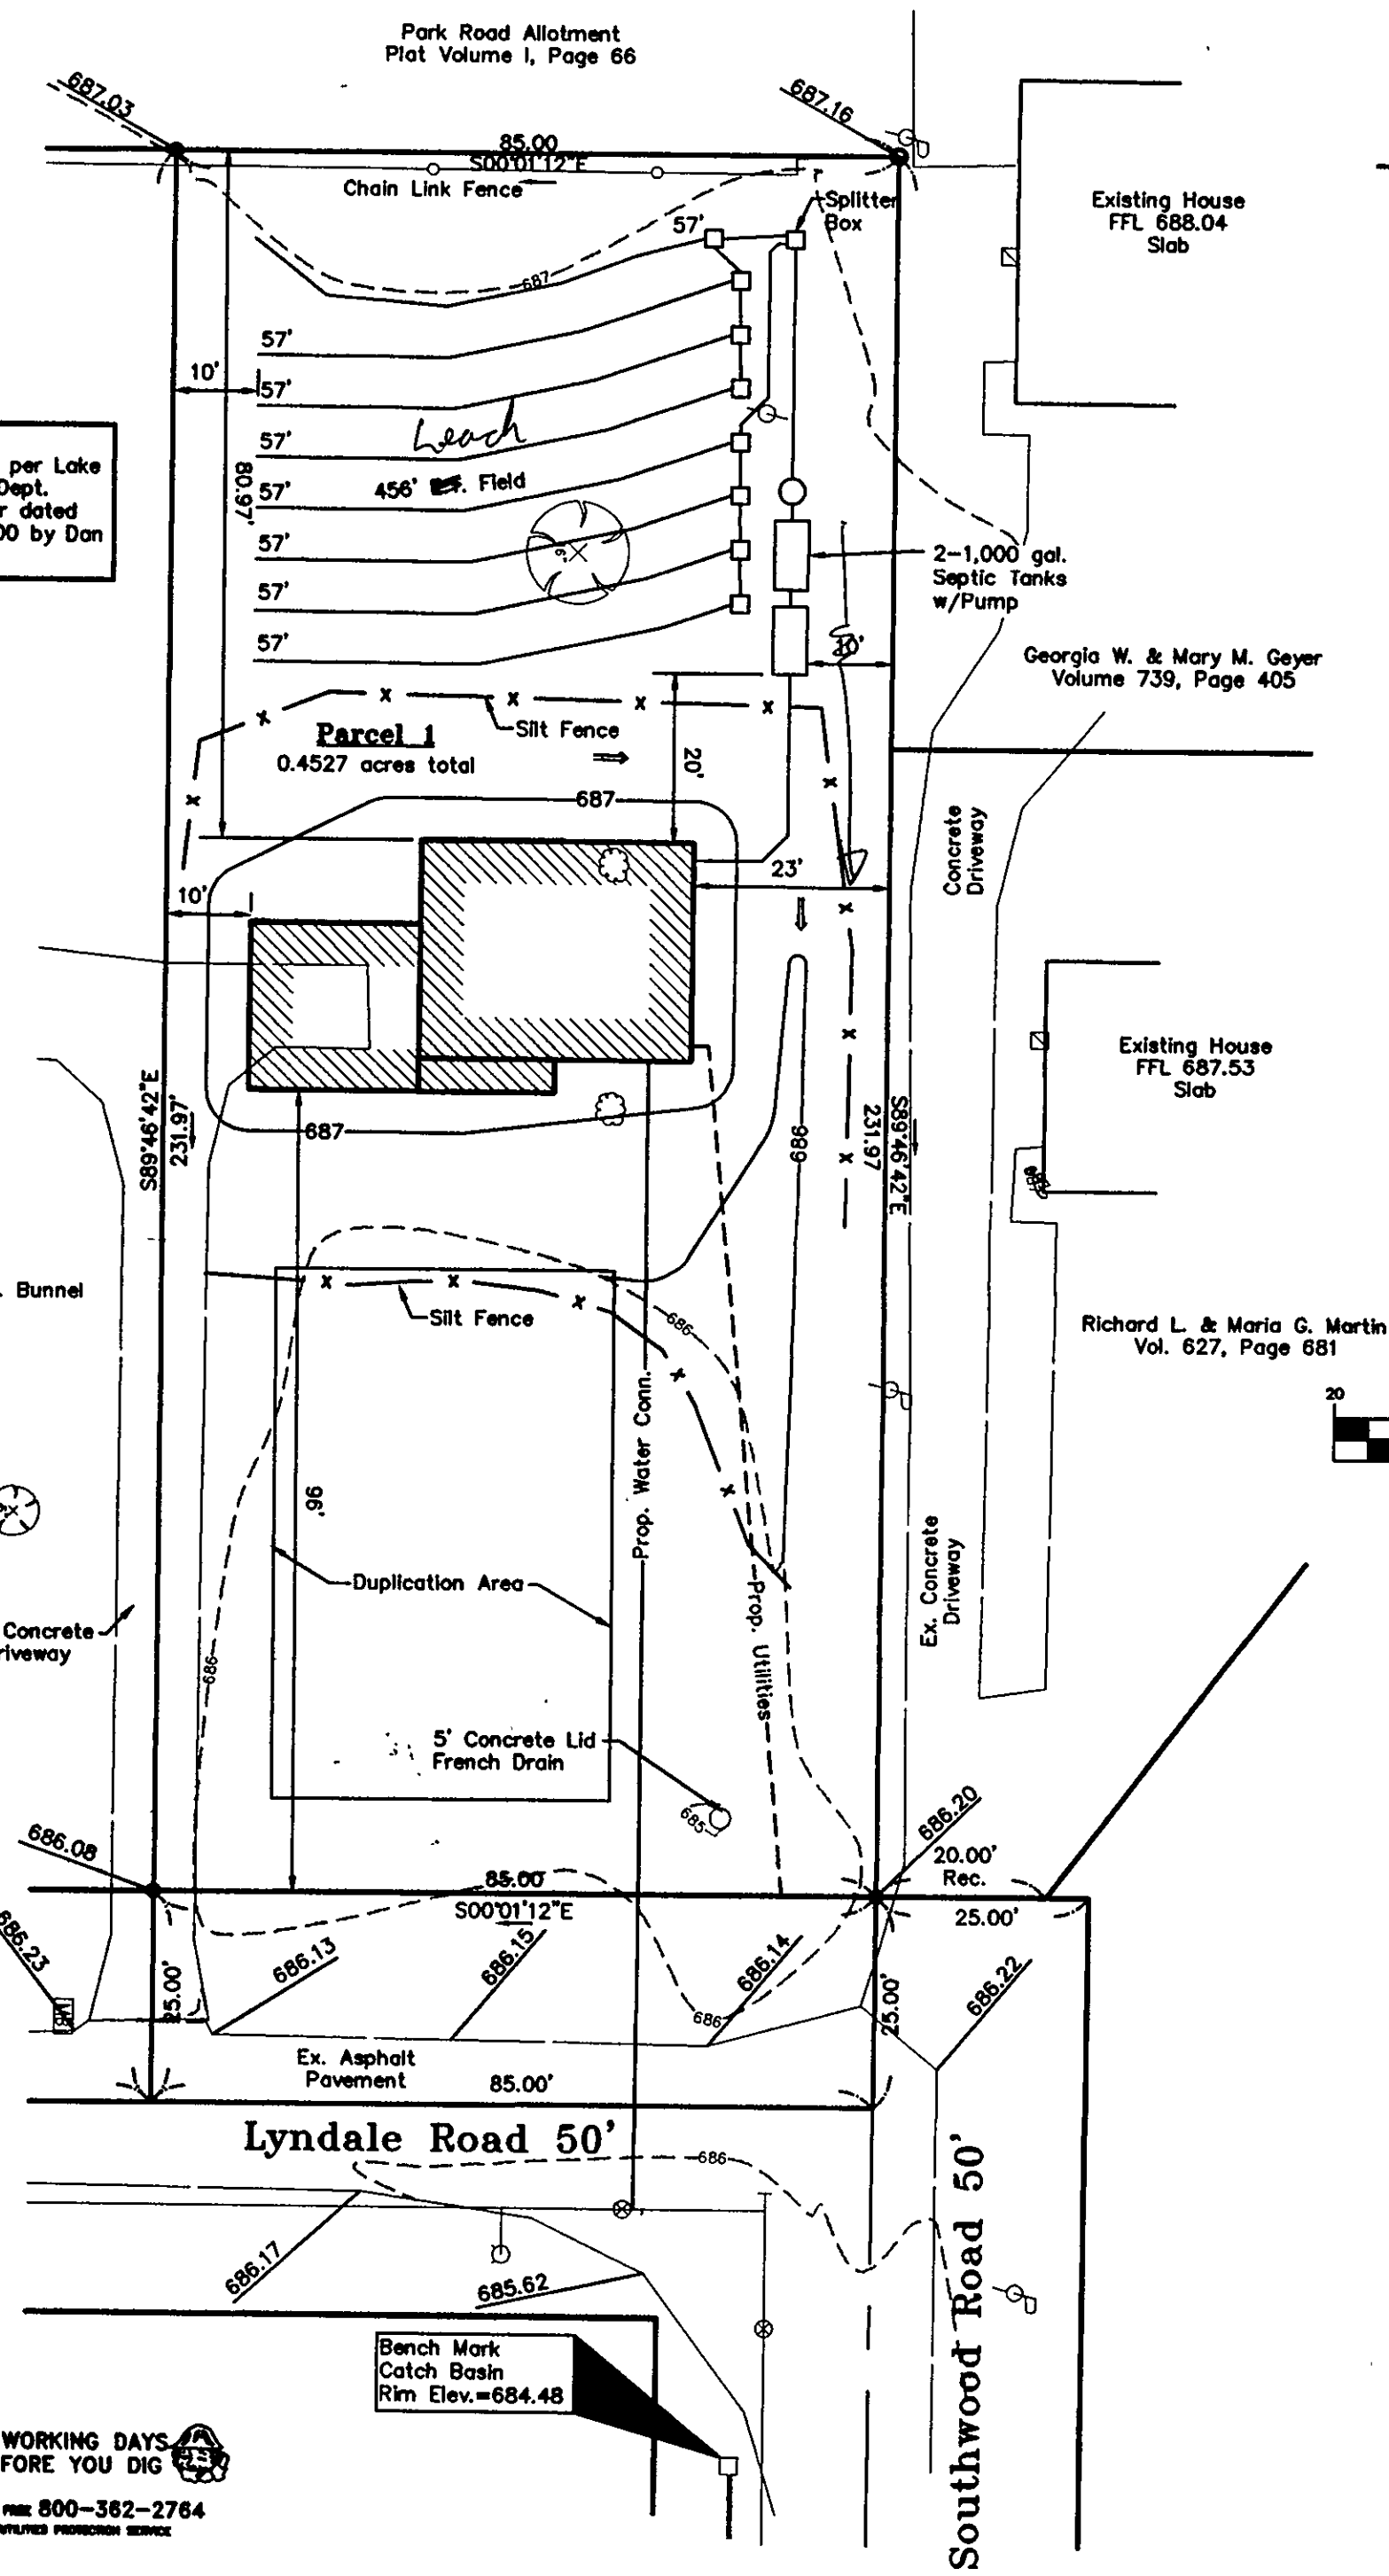

Note
E.T. Field Sized per Lake
County Health Dept.
evaluation letter dated
January 11, 2000 by Dan
Lark.

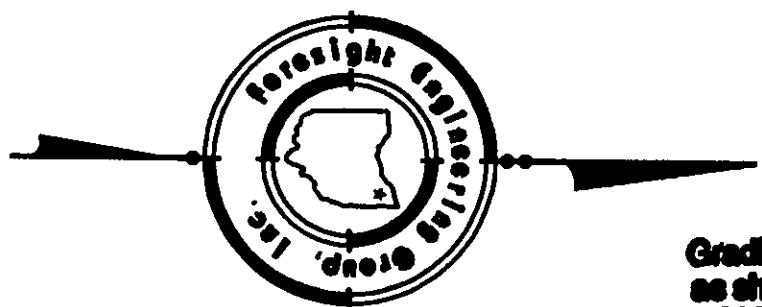

Grading Plan Approved
as shown and/or noted
THOMAS P. GILES, P.E.
Lake County Engineer

SYMBOL LEGEND

○	Iron Pin found (As described)
⊕	Power Pole
⊞	Gas Meter
⊞	Mail Box
⊞	Catch Basin
⊞	Water Valve
⊞	Fire Hydrant
⊞	Light and Power Pole
⊞	Manhole
⊞	5/8" Rebar Set

Swale as shown and
Lower FG. as noted
**ROOF DRAINS
SHALL DISCHARGE
TO SPLASH BLOCKS.**



Note: Utilities include Gas Line, Electric,
Phone, and Cable. Contractor to field verify
location at roadway.

Painesville Twp Zoning Requirements:
Min. Front Setback: 50'
Min. Side yard Clearance: 10'
Min. Rear yard Clearance: 25'



"I, the undersigned hereby certify that this topography, indicated by 6", 1' or 2' contours, and the elevations shown hereon represent an actual field survey made by Foresight Engineering Group, Inc. on the 24 day of January, 2000 and that the elevations were taken at appropriate intervals and that as of that date they existed as indicated hereon."


NAME: *Steven N. Roessner*

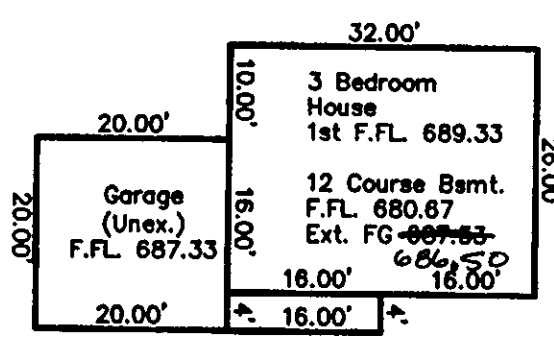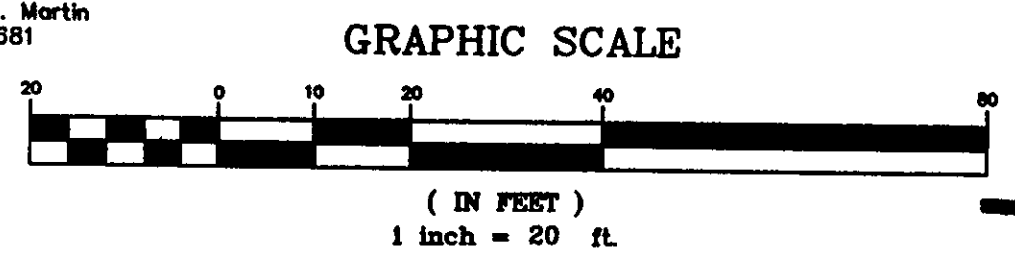

REVIEWED AND ACCEPTED
LAKE COUNTY GENERAL
HEALTH DISTRICT

Date: 8-24-00 BY: *David B. Morris*

SEWAGE DISPOSAL PERMIT MUST BE
OBTAINED BY A LAKE COUNTY LICENSED
INSTALLER BEFORE INSTALLATION
STARTED.

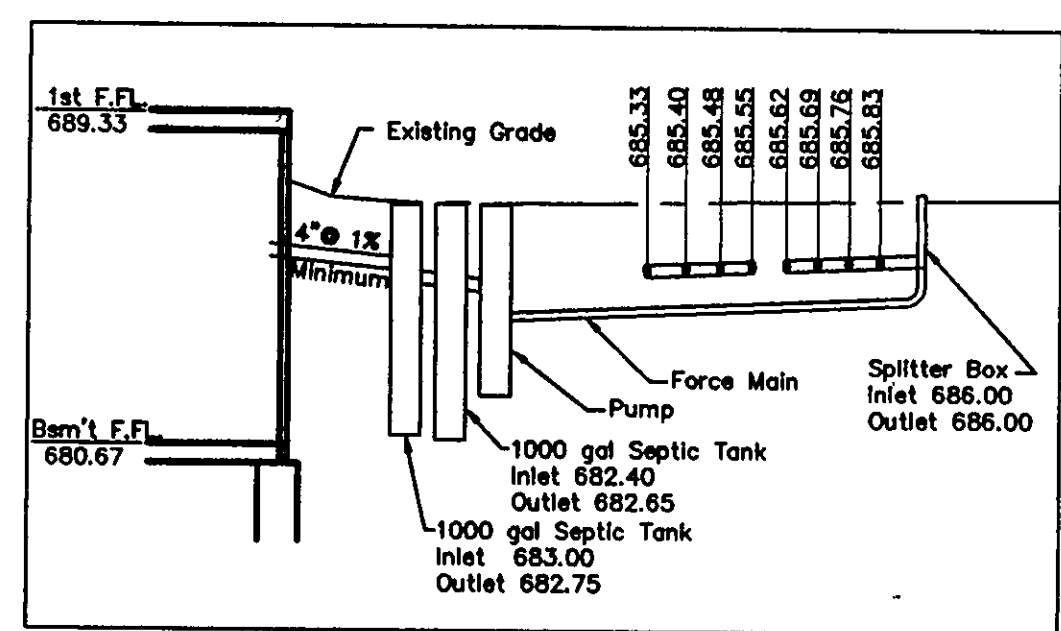

Hydraulic Profile

SITE PLAN
for: **R.L. MOORE BUILDERS, INC.**
7121 Ravenna Rd. Concord OH 44077
ADDRESS CITY STATE ZIP

SUBLOT No. 30 LOT TRACT 1
SUBDIVISION NAME Painesville Twp. CITY OHIO
VOL. 1 PAGE 1


Foresight Engineering Group
Engineers & Surveyors
440 286-1010
440 286-1034 fax
320 Center Street, Unit F
Chardon, Ohio 44024

SCALE: 1" = 20'
FILE NAME: I:\RLM10001\site-plan
DATE: August 22, 2000

BENCHMARK: Catch Basin Rim Elev. = 684.48
SHEET NO. 1/2

EXISTING UNDERGROUND UTILITIES NOTES:
The location both horizontal and vertical of the underground utilities shown hereon, have been obtained by a diligent and comprehensive search of available records. Verification by field observation, has been conducted where practical. However, Foresight Engineering Group, Inc. does not guarantee the completeness nor accuracy thereof.

APPROVED
PAINESVILLE TOWNSHIP
ZONING DEPARTMENT
20000321
DR

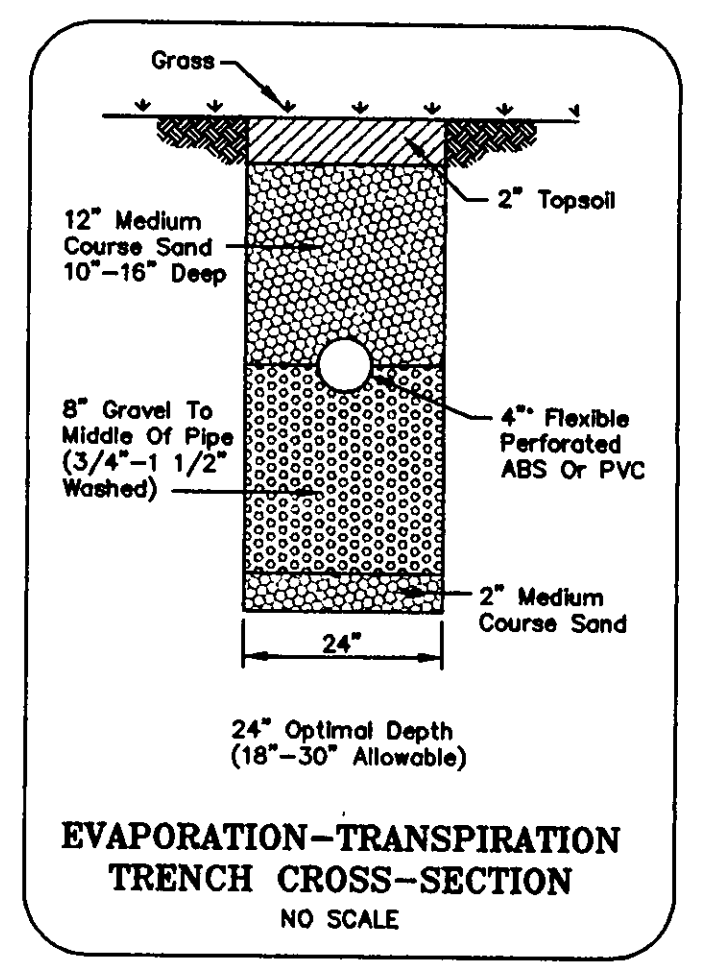

2 WORKING DAYS
BEFORE YOU DIG
CALL TOLL FREE 800-362-2764
AND VISIT OUR WEBSITE

139 Lyndale Dr