

MADISON AVENUE

PARKING LOT
6000 SQ. FT.
NOT INCLUDING RIGHT-OF-WAY

PARKING LOT
2000 SQ. FT.
NOT INCLUDING RIGHT-OF-WAY

EXISTING BUILDING

27'-0" x 113'-0"
3051 SQ. FT.

PARKING LOT
2450 SQ. FT.

APPROX. 40-45 FT.


PROPOSED
CONSTRUCTION
24'-0" x 32'-0"
POLE BUILDING
768 SQ. FT.

DRAWING NOT TO SCALE

Accepted this plan on basis
of its known location, being a pole
bldg., & its proximity to positive
drainage. Informed Bldg. Dept. to
make sure drainage is directed over bank
Inc
11-7-80

PLOT MAP

SHOWING PROPOSED CONSTRUCTION
AT
LARRY'S LAWN AND GARDEN, INC.,
720 MADISON AVENUE, PAINESVILLE, OHIO 44077
DAVID R. ZITO

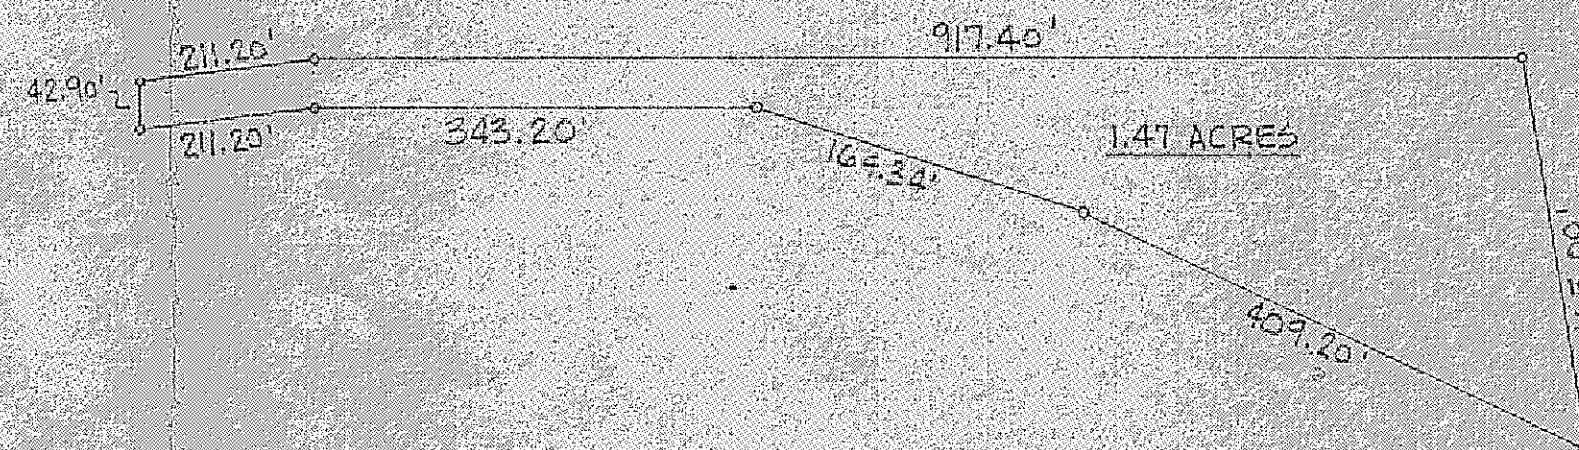

DRAWN: 11-3-80 MR