


CEDAR GLEN DR. NO. 2
(PROPOSED)

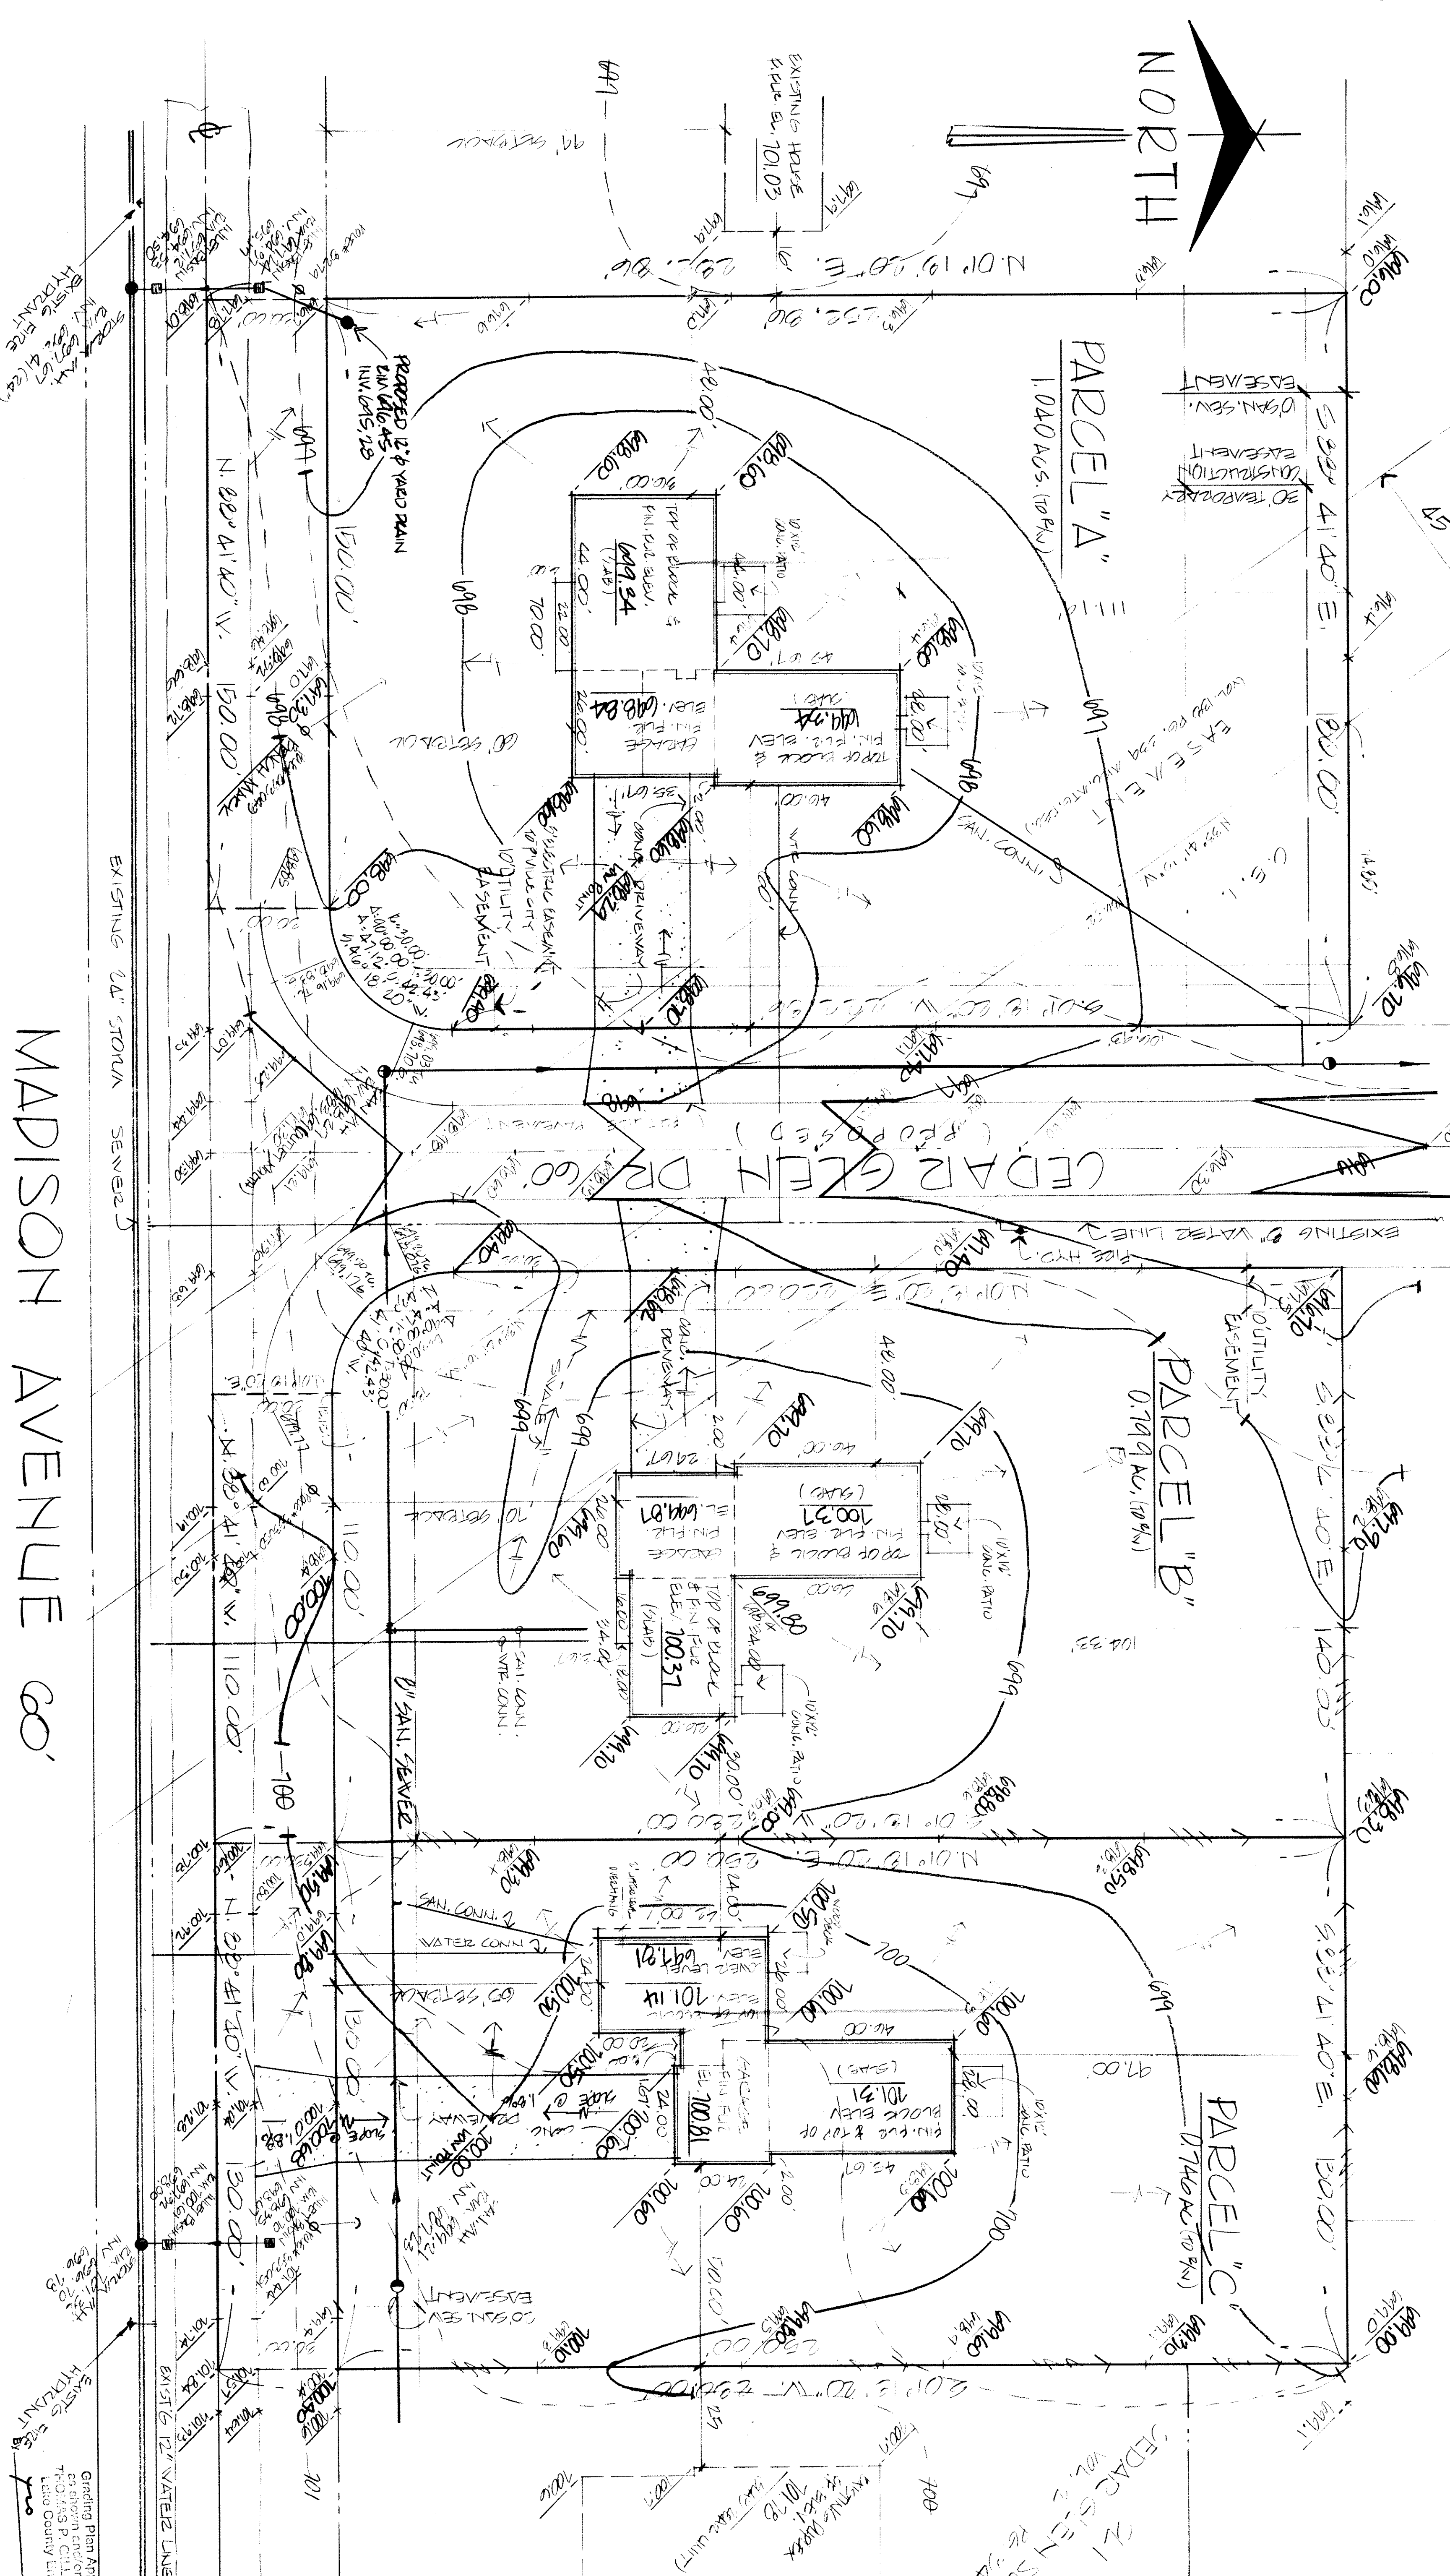


MADISON AVENUE 60'

NO. 653049 ELEV. 693.30

LEGEND:
100.00 PROPOSED GRADES
100.00 EXISTING GRADES
100.00 EXISTING UTILITIES
100.00 PROPOSED UTILITIES

NOTE: ELEVATIONS SHOWN ABOVE & UPGRADE AREA DE.
ARE PROPOSED DESIGN GRADIES FROM IMPROVEMENT PLANS.

REV. No.	DESCRIPTION	DATE	BY	CHKD
1				
2				
3				
4				
5				
6				
7				
8				
9				
10				

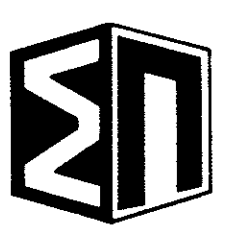

COLPETZER · WOODS
CONSULTANTS, INC.
MENTOR, OHIO 44060

DATE MAY 15, 2023
SCALE: HOR. 1"=100'
VERT. 1"=10'
DRAWN BY JLB
CHKD BY JLB
F.B. # 1400 PG 0119

CASEMENT HOMES

DESIGN CERTIFICATION:
THIS IS A TRUE AND CORRECT COPY OF THE DESIGN AS SUBMITTED BY ME AND IS CORRECT TO THE BEST OF MY KNOWLEDGE AND BELIEF.
Elis J. Colpetzer
Date 10.10.24
F.B. # 1400 PG 0119

SHEET 1 OF 1
CONTRACT No. 24-105