

1" = 20'

EXIST PROP  
EXIST PROP

SEE ATTACHED COPY

Grading Plan Approved  
as shown and recorded  
THOMAS P. COFFMAN, P.E.  
Lake County, Ohio

By 6114 4293  
DISCHARGE Sump Pump To  
STORM SEWER.


ROOF DRAINS  
SHALL DISCHARGE  
TO SPLASH BLOCKS.  
SITE PLAN

FOR  
DUSAN KNEZ  
BEING SUBLOT No. 15, MISTY MEADOWS  
SUB'D. IN THE TOWNSHIP OF PAINESVILLE,  
COUNTY OF LAKE, STATE OF OHIO.

APPROVED  
PAINESVILLE TOWNSHIP  
ZONING DEPARTMENT  
#8375 3/30/93 *[Signature]*

I, the undersigned hereby certify that  
this topography, indicated by 1' contours,  
and elevations shown hereon represent an  
actual field survey made by me on MARCH 26, 1993  
and that the elevations were taken at  
appropriate intervals and that as of that

*J. M. Coffman, P.E.*

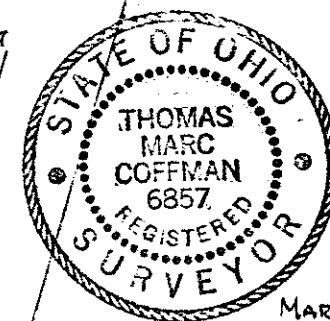

MARCH 29, 1993  
REV 3-30-93 (SL'S + R.V.)

VILLAGE SURVEYING CO.  
202 THIRD ST., FAIRPORT HBR., OH 44017  
(216) 357-1359