


SITE PLAN

FOR

BOB GIBBS

BEING SUBLOTS 24 & 25 OF THE
MELROSE DRIVE SUBDIVISION IN THE
TOWNSHIP OF PAINESVILLE, LAKE COUNTY, OHIO

Approved
12/19/88

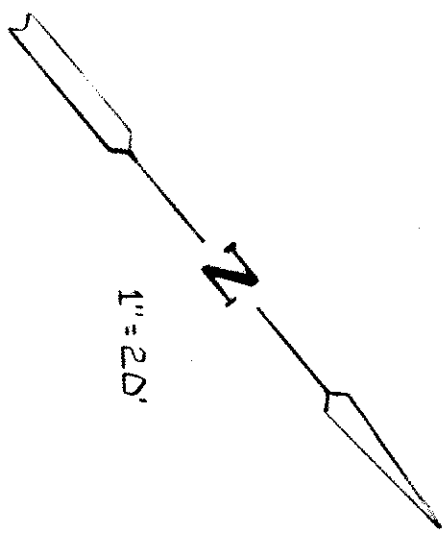


* EXISTING DITCH TO BE FILLED AND/OR
RELOCATED AS SHOWN

CURVE DATA			
	1	2	3
Radius	253.58'	253.58'	202.00'
Arc	84.64'	39.55'	81.61'
Chord	84.22'	31.51'	86.98'
B	N 64° 41' 10" W	N 83° 42' 46" W	N 15° 45' 03" W


BENCHMARK - 673.98
N. R.M. SAN. M.H.

This Permit Expires
12-9-89
ZONING APPROVED
2138-7139
Zoning Inspector
12/19/88

VILLAGE SURVEYING Co.
202 THIRD ST., FAIRPORT HGB. OH 44017
(216) 351-1359

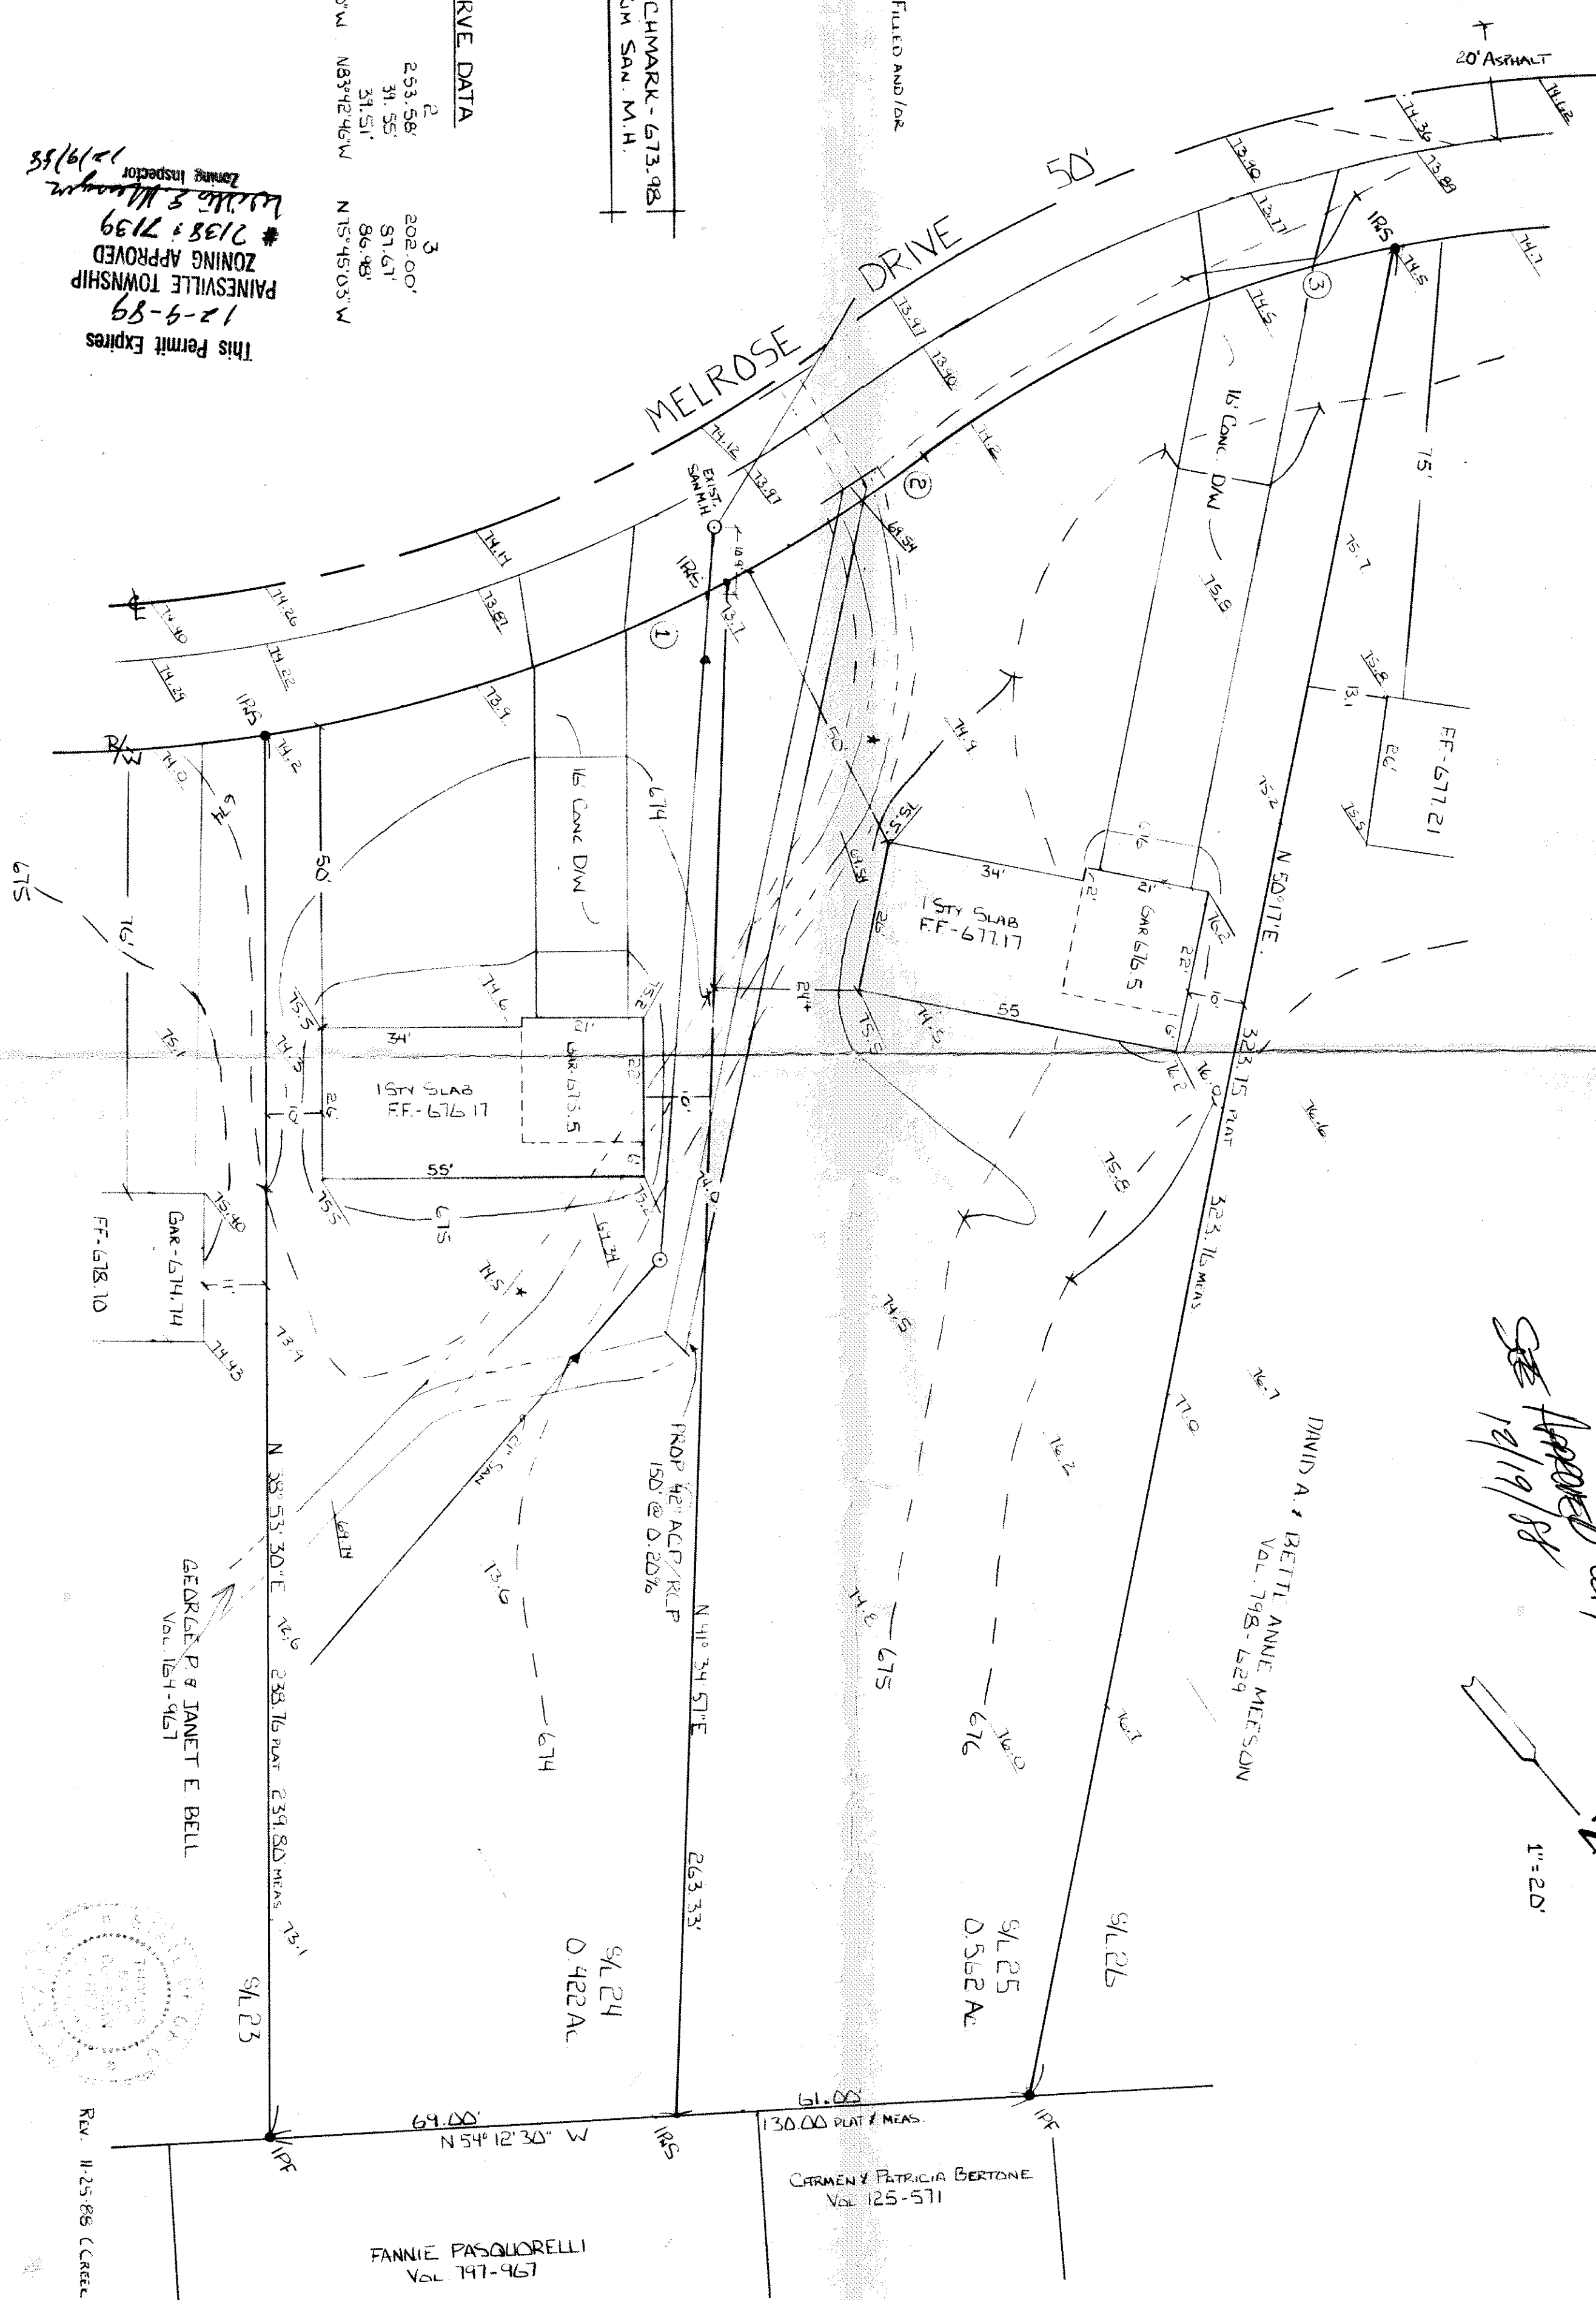

THIS PLAN WAS PREPARED BY ME AND IS ACCURATE
TO THE BEST OF MY KNOWLEDGE AND BELIEF.
THOMAS M. COFFMAN JR.
THOMAS M. COFFMAN JR. 6857

 

REV. 11-25-88 (CREEK & SAN. M.H.)