



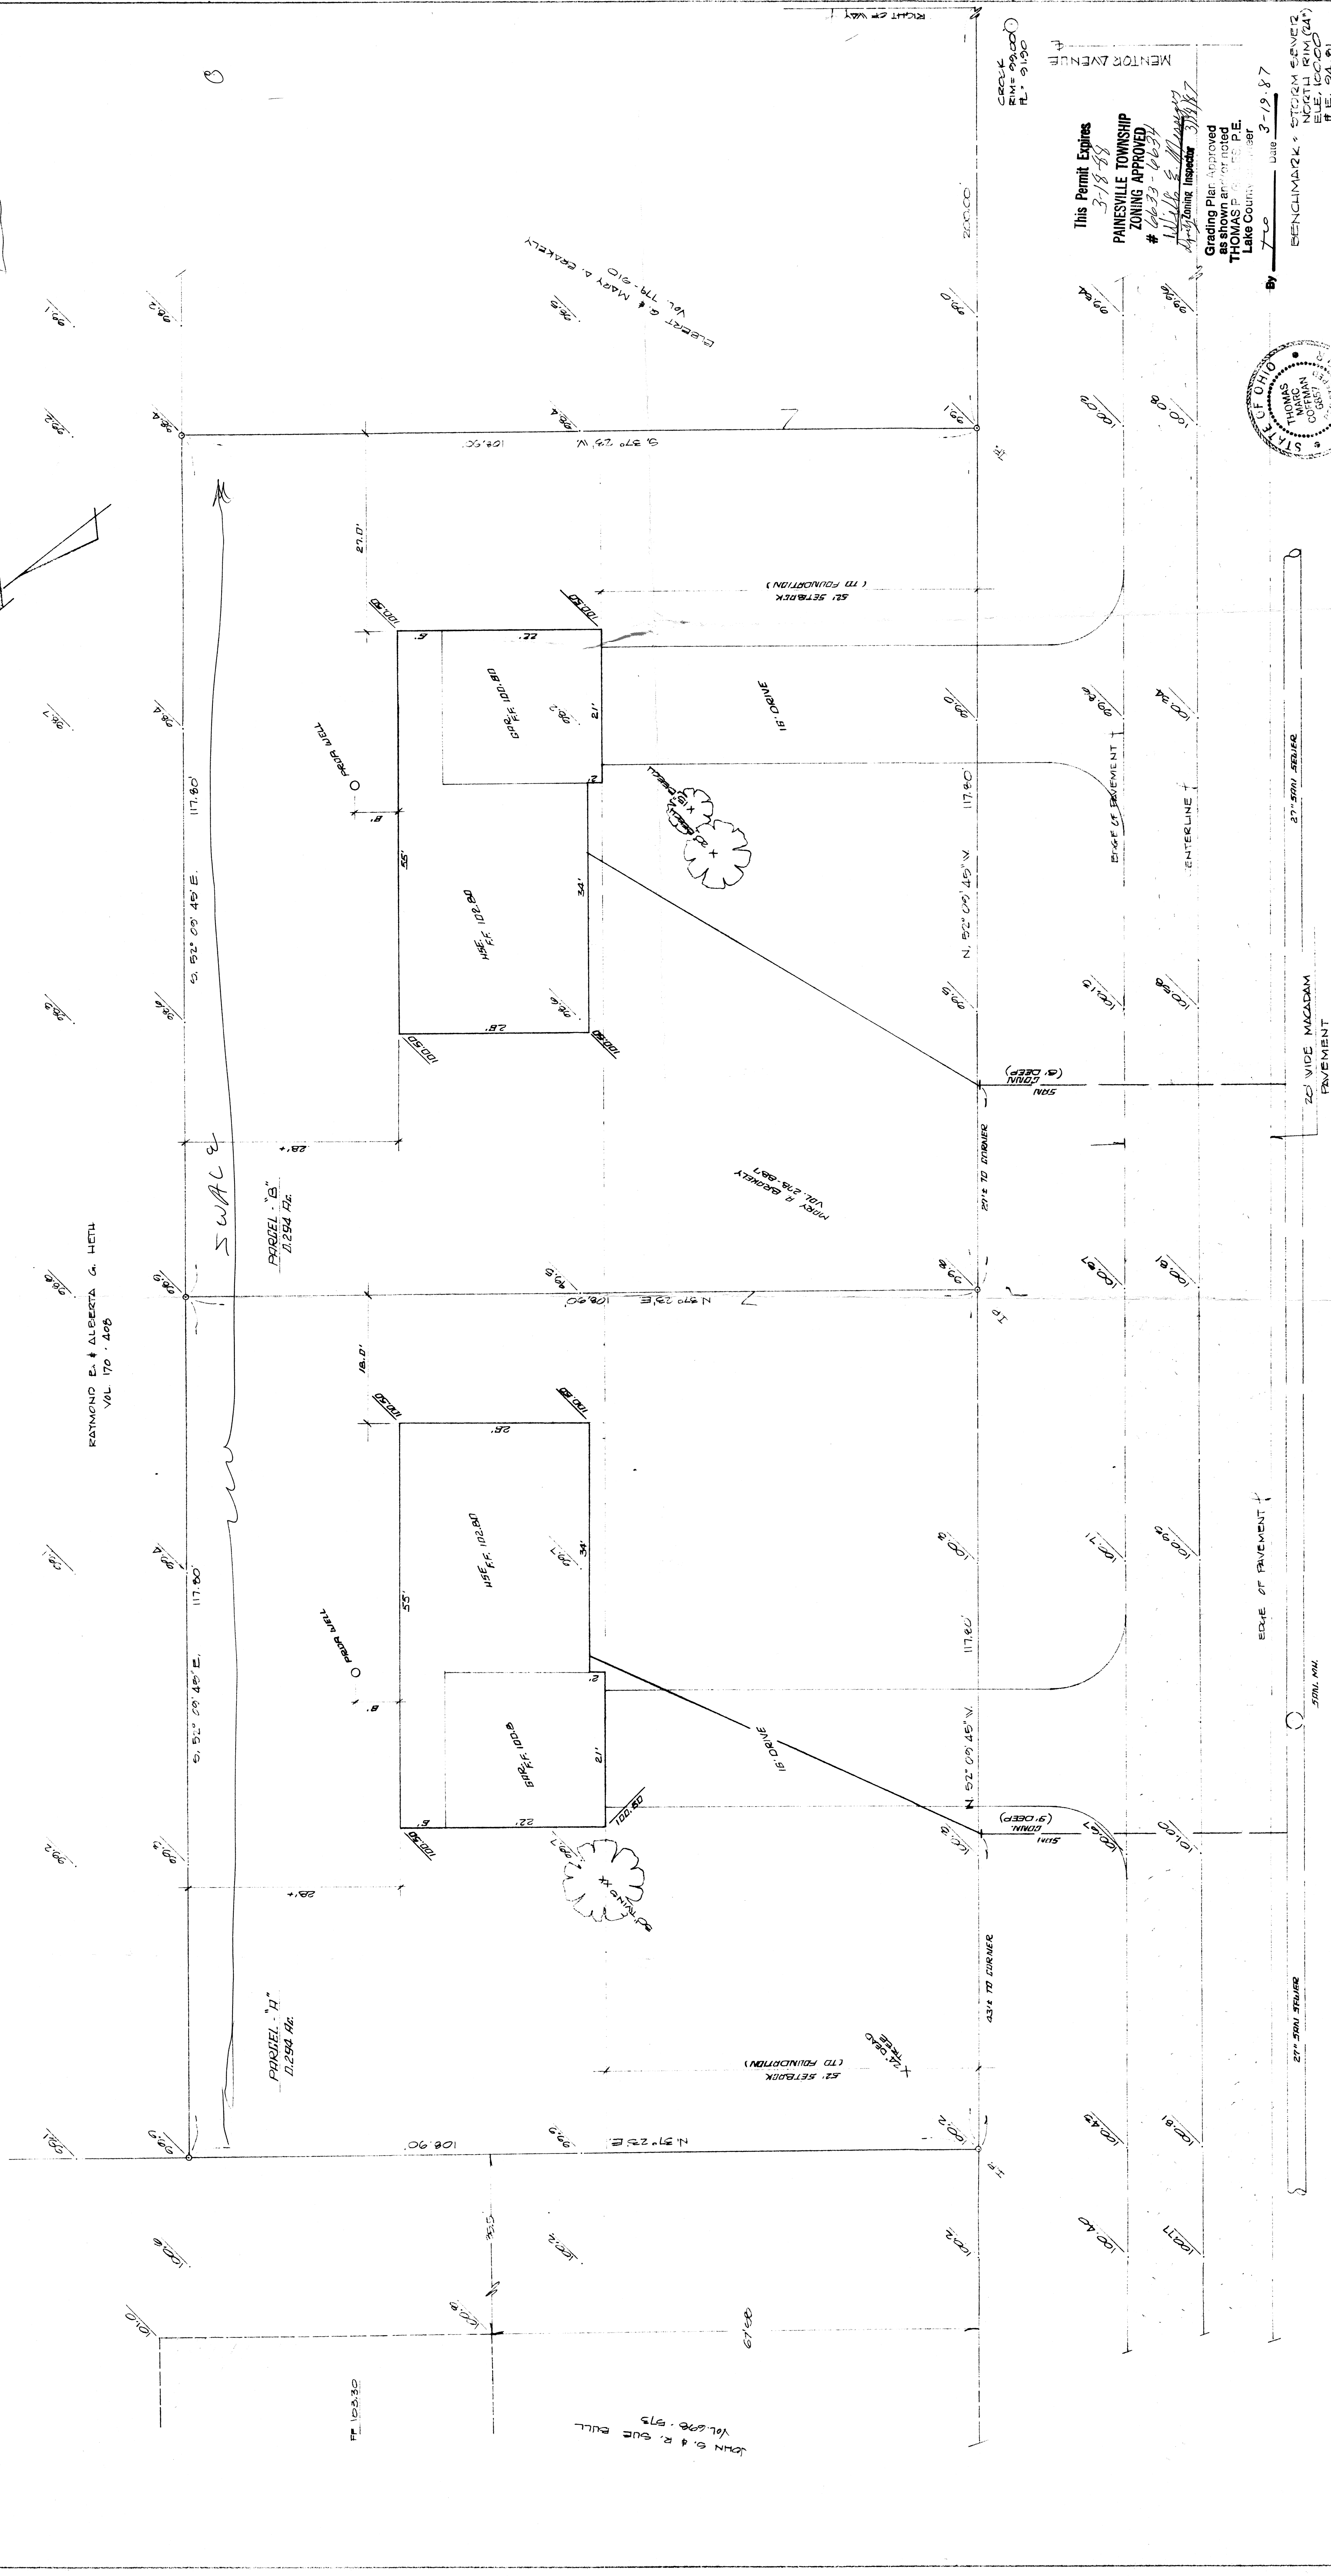

SITE PLAN
FOR
ROBERT E. GIBBS
SCALE, 1"=10' MARCH 1987
BEING PART OF LOT 57, TRACT 4, IN PAINESVILLE
TOWNSHIP, COUNTY OF LAKE, STATE OF OHIO

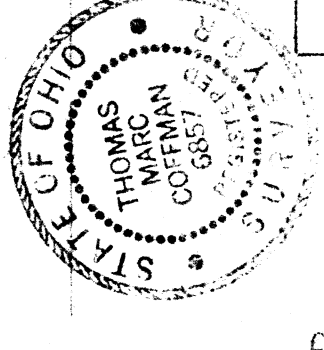

THIS PLAN WAS PREPARED BY ME AND
IS TRUE AND ACCURATE TO THE BEST OF
KNOWLEDGE AND BELIEF.


By 7-6 Date 3-19-87

Grading Plan Approved
as shown and/or noted
by Thomas P. Gibbs, P.E.
Lake County Engineer

This Permit Expires
3-18-88
PAINESVILLE TOWNSHIP
ZONING APPROVED
William E. Haggerty
Zoning Inspector

CRACK
RIM = 99.00
FL = 91.00

MENTOR AVENUE
R.H.

BENCHMARK: STORM SEWER
NORTH RIM (24")
ELEV. 100.00
ELEV. 94.81

BEARINGS AND DISTANCES ARE FROM DEED RECORD.