


1

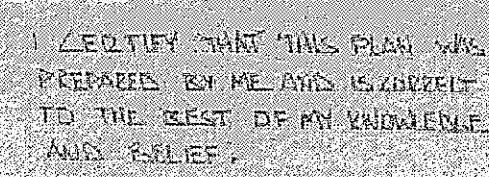

WILL C. SPONHEZNY
1139 VIEWMOUNT DRIVE
CINCINNATI OHIO 45271
252-7742

180N. FLY SET
— EXISTING WASTE
PROPOSED
— MIN SWINE

Grading Plan Approved
as shown and/or noted
THOMAS P. GILLES, P.E.
Lake County Engineer
By me Date 7-18

SITE PLAN FOR		
RDY SLAYTON * SAW CONST.		
SCALE: 1"=20'	APPROVED BY: <u>ICS</u>	DRAWN BY: <u>DAVID</u>
DATE: 11 JAN 79		ZONES:
OF SJL 54-55 IMPROVE WOOD CORP		
TWP. OF PAINESVILLE		LIVE LOUWY
		DRAWING