

SECRET

6/2/29

EXIST FILE
#IN FILE - 700042

CURVE DATA
E=18000' A=57.81 C=57.17
Δ=8°05'40" N 72°44'50"E

-770E HYD. - ACROSS FROM
S/L 488 - TOP STEAM ELEV.
= 706.83

NEUMAR DRIVE 60

YACED 103A 12
KIM = 1035 BC

12" string

10455

1. DRAINAGE TO HAVE 5" DIA. HOLE IN

2. ALL DOWNSPOUTS TO BE CUT OFF TO SLASH BUSHES

3. BENCHMARK. FIVE HYDRANT ALONGS FROM S/L 58
TOD STEEL ELEVE = 706.83

EXISTING & PROPOSED

EXISTING CONTROL
EXPOSED CONTROL

DELETED SUBJECTS OXAMPHEN

EX-1143E
IN FILE = 00-78

5/5

Grading Plan Approved
as shown and/or
THOMAS P. GILL
Lake County Eng.
By G/H Date 4/
DISCHARGE Sump pump
STM. CANV.

THIS PLAN WAS PREPARED BY ME AND IS CORRECT
TO THE BEST OF MY KNOWLEDGE

Wm. H. Wood


This Permit Expires

4-16-92

4-15-1
PAINESVILLE TOWNSHIP
ZONING APPROVED

#7752-DK

Zoning Inspector

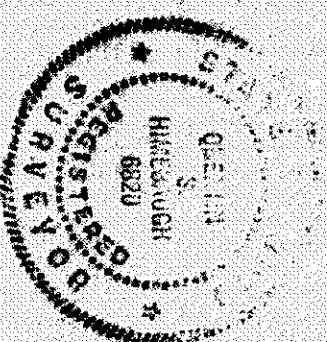

SITE PLAN SUBLOT 30 NEUMAR DRIVE

INTERL-WOODS SUB. #2 PAINESVILLE TWP. OH

SCALE	1/8"
DATE	Mar 2, 1960
APPROVED	<i>Joseph C. Murphy</i>
DESIGNED	

PLAN PREPARED BY: HIMEBAUGH AND ASSOCIATES
38083 W. SPALDING ST. WILLOUGHBY OH 44094

216-946-1761

80-016-5C