



FOR
THE DYNES
BEING A PART OF LOT #1 TRACT 1
LAKE COUNTY, OHIO.

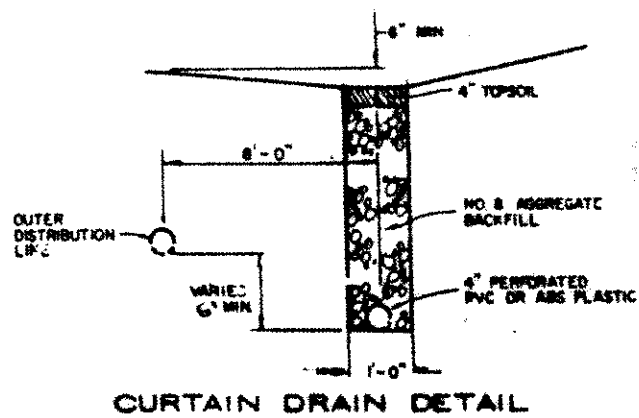

HYDRAULIC PROFILE
VERT 1" = 4' HORIZ 1" = 40'

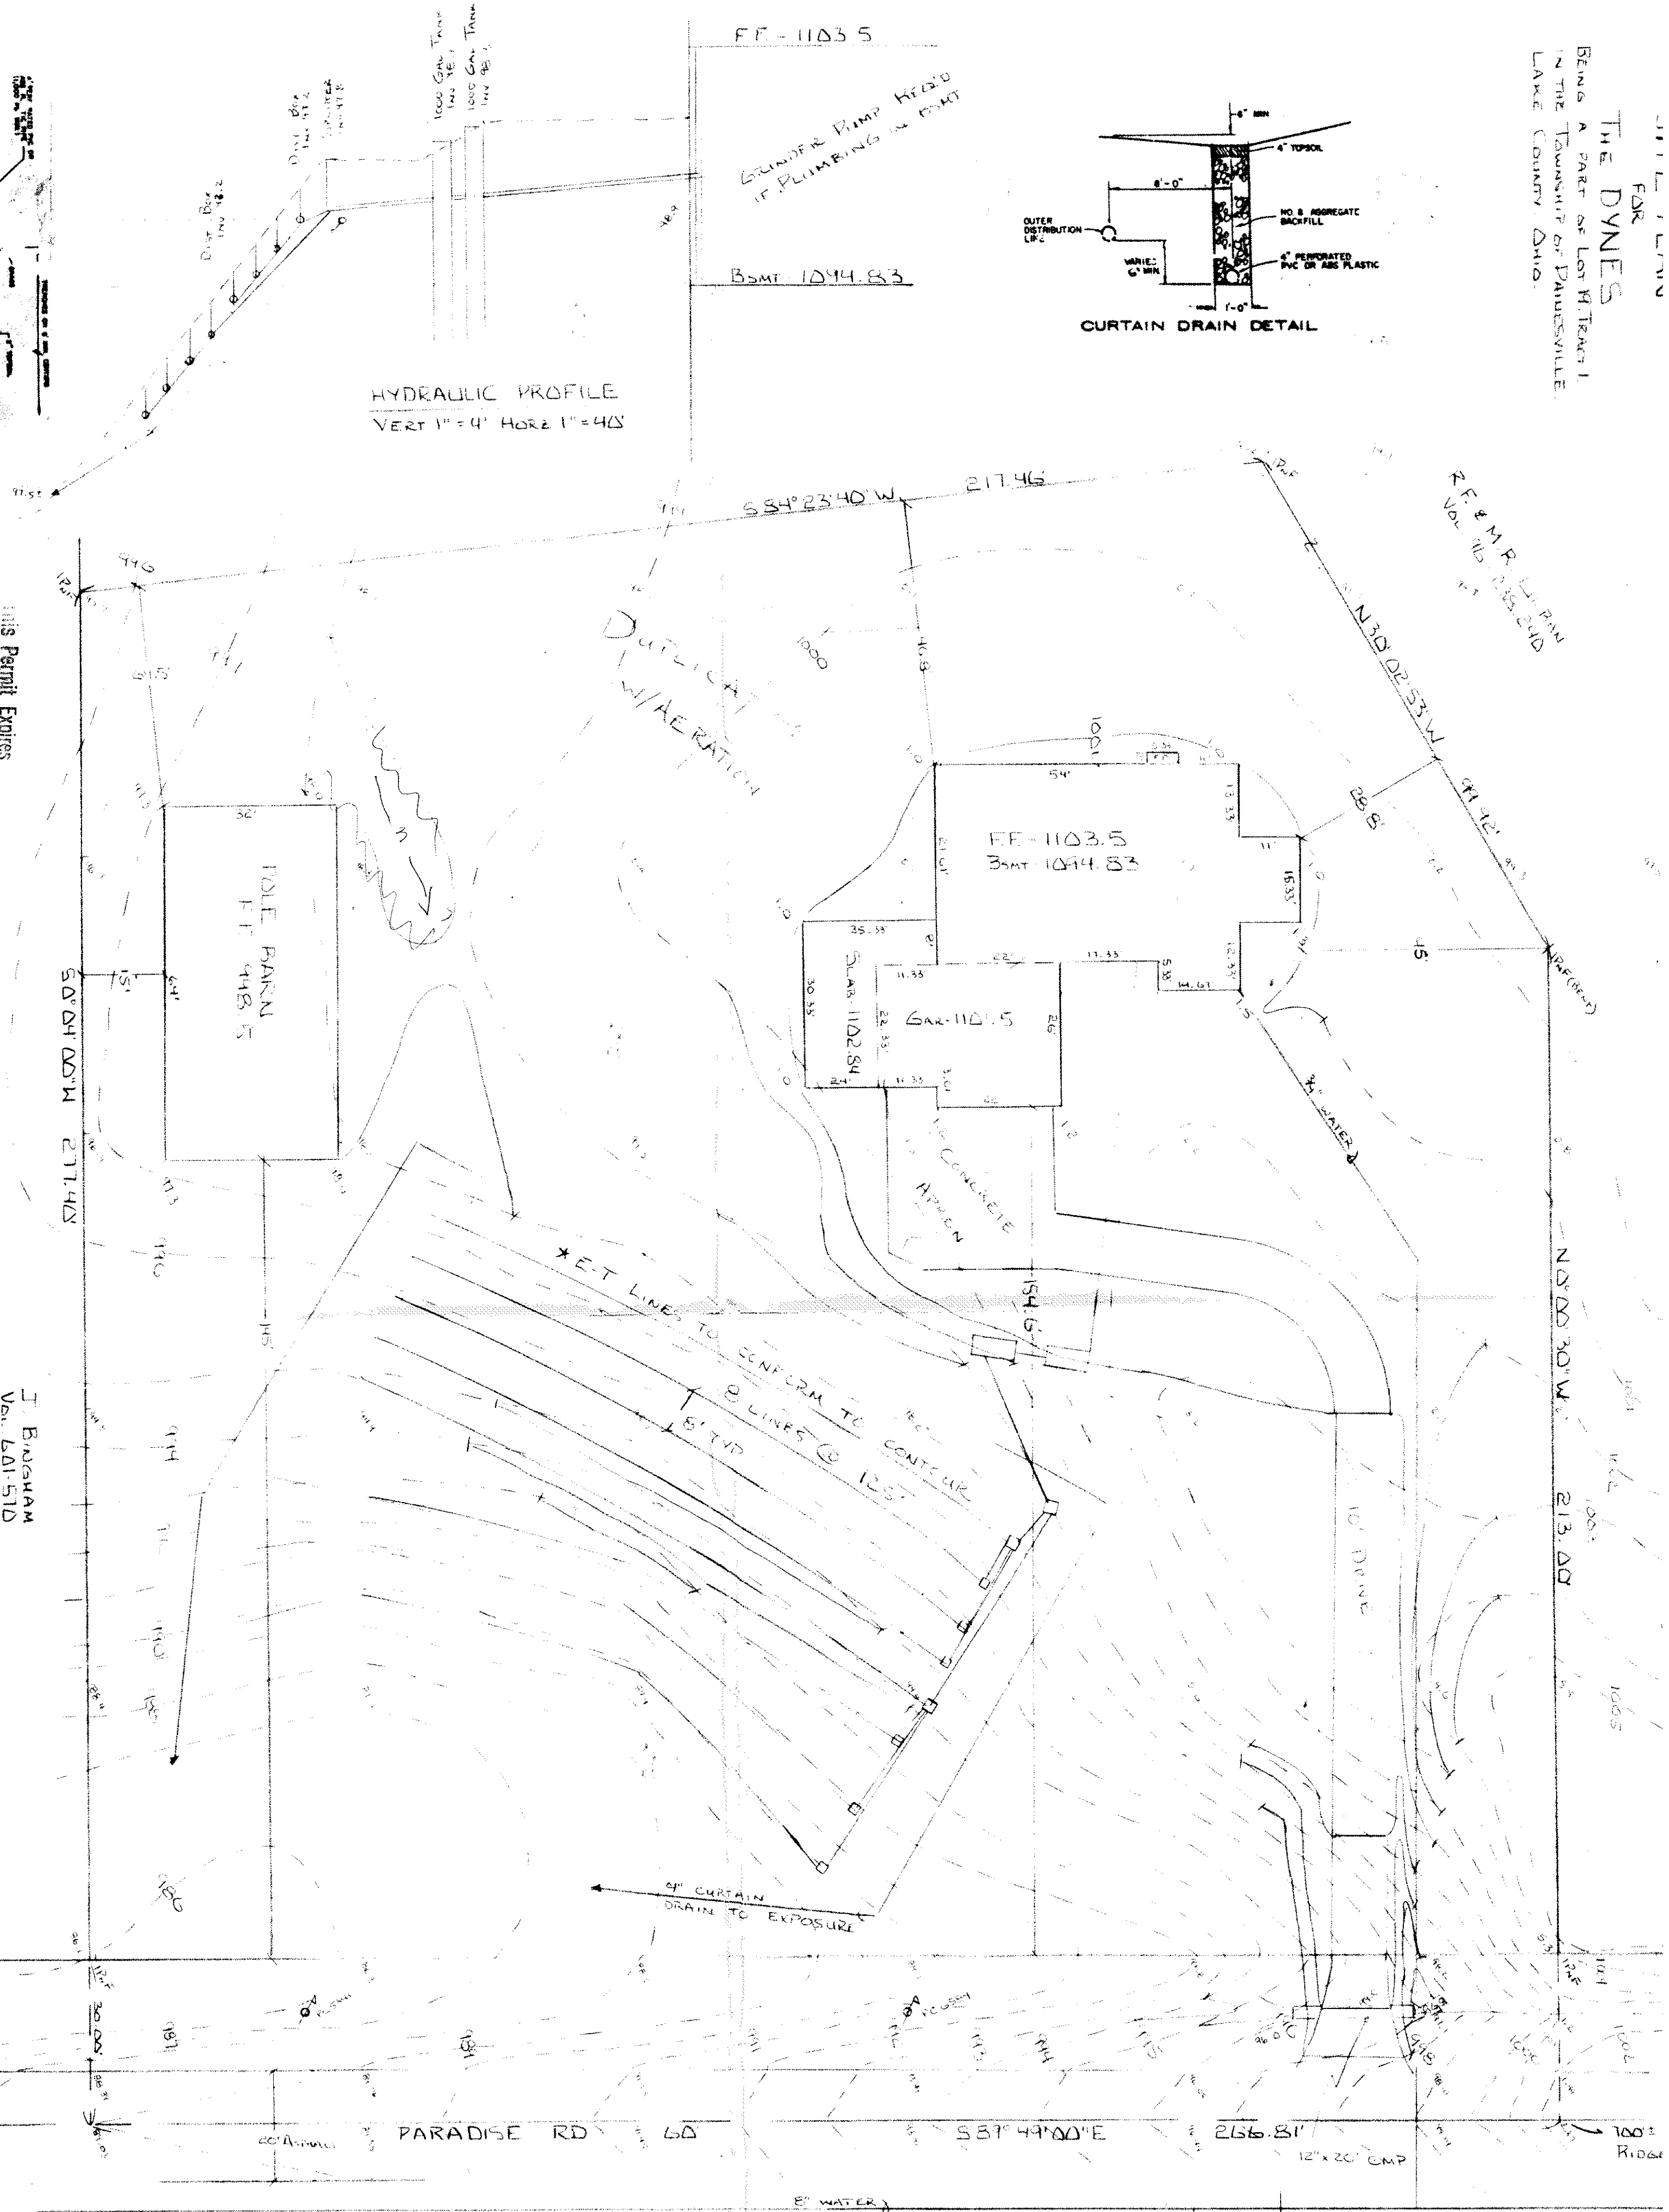


1015 Permit Expires
4/27/93

PAIDSVILLE TOWNSHIP
ZONING APPROVED
#8097 JKB

MARCH 26, 1992

J. B. BUGHAM
Vol. 601-570

VILLAGE SURVEYING CO.
202 TOWN ST., FAIRPORT HARBOR, OH 44027
(216) 357-1354

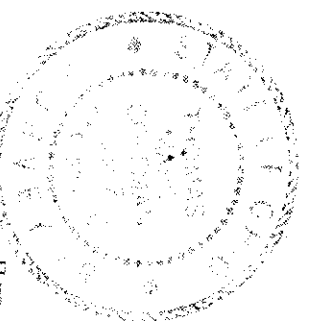

Grading Plan Approved
as shown and/or noted
THOMAS P. GILLES, P.E.
Lake County Engineer

By G/H Date 2/16/92

LOW YIELD WATER
FIXTURES REQUIRED
ON ALL:
Shower Head
Toilet

SEWAGE DISPOSAL PERMIT MUST BE
OBTAINED BY A LAKE COUNTY LICENSED
INSTALLER BEFORE INSTALLATION IS
STARTED.

- A. To be brought to finished grade
- 1. Septic tank manhole covers
- 2. Splitter box cover
- 3. Distribution box cover
- B. No footer drains or downspouts
to be discharged into septic tanks
- C. All waste water to be discharged into
septic tanks

Reviewed and Accepted
LAKE COUNTY GENERAL HEALTH DISTRICT
Date 4/22/92
JOEL LUDWIG, R.S., M.P.H.
Health Commissioner
BY Nancy N. Ludwig

BENCHMARK-1000 (ASSUMED)
TOP BOLT HYDRANT

1" = 20'

N