


SITE PLAN

FOR BARE BROOK, COURT, ETC.

OF SUBLOT NO. 105 IN LAKE ERIE SHORES PLANNING PAUESVILLE
 TOWNSHIP, OHIO AS SHOWN BY THE PLAT RECORDED IN VOLUME 45
 PAGE 30 OF LAKE COUNTY MAP RECORDS.

NOTES

1. PROPOSED GROUND GRADERS
2. --- 44 --- OVERLAND DRAINAGE FLOW
3. BEACH MOUND TOP OF LWD BEACH
 SL106 ELEV 626.44
4. --- 45 --- EXISTING COLTAGES
5. --- 45 --- PROPOSED COUTURES
6. CONTACT O.L.P.S. TWO WORKING
 DAYS BEFORE DRAINAGE 1-800-562-2764
7. IPS = 518' IRON PUMP SET WITH CAD
 TO SPASH BLOCKS
8. SAND PUMP TO BE INSTALLED
 IN GRADUALLY PLAU USED FOR
 FILLING GROUND GRADERS - DIZED 0.40 624.4

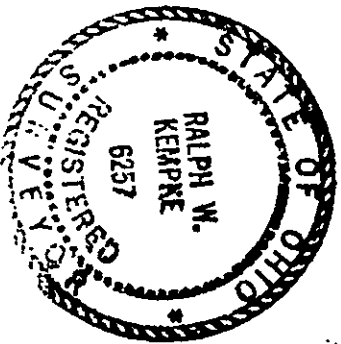

SL106
 VACANT LOT
 F.G. 624.25
 PROPOSED

Check limits

LOCAL
 SERVICE
 DRAINAGE
 EDSEMENT
 SL105
 9.22470C

THIS SURVEY PREPARED BY
 L.A. 639.8512

Stormwater Management Plan
 Approved as shown and/or noted
JAMES R. GILLS, P.E.
 County Drainage Engineer


By 6/11 Date 11/24/03

Subject to approval by:

- ☐ Zoning Department
- ☐ LC General Health District
- ☐ LC Soil & Water Conservation District
- ☒ LC Building Department (final approval)

Stoned construction entrance
 Temporary seeding and mulching of all disturbed areas
 Storm sewer inlet protection for rear yard drains and catch basins
 Temporary seeding within 50 feet of any stream or wetland (if necessary)
 Silt fencing (if necessary)

SL103
 VACANT LOT
 F.G. 625.50
 PROPOSED

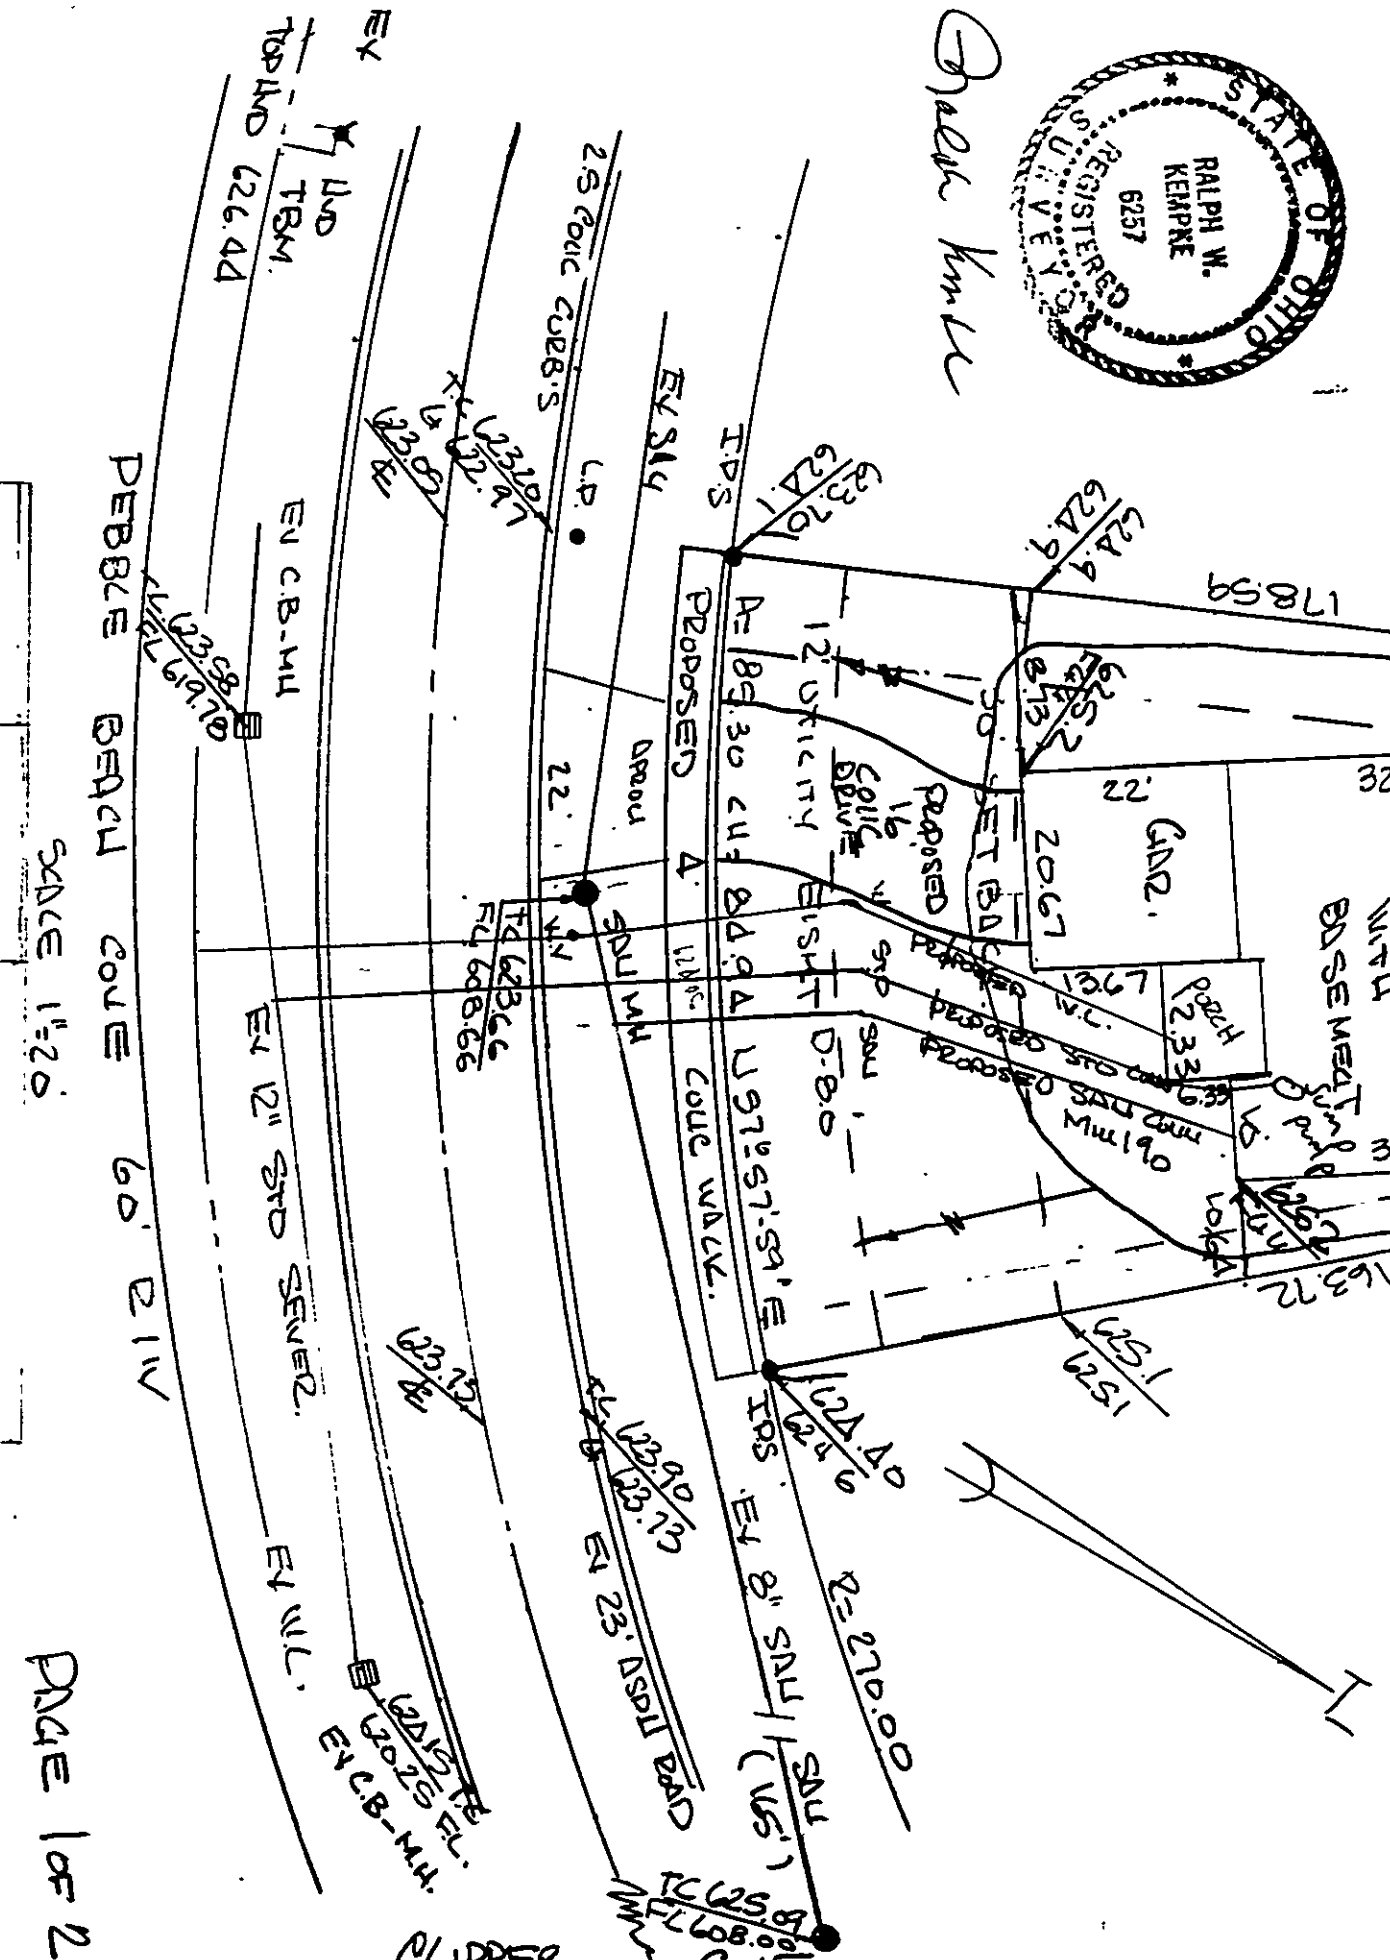

SCALE 1"=20'