
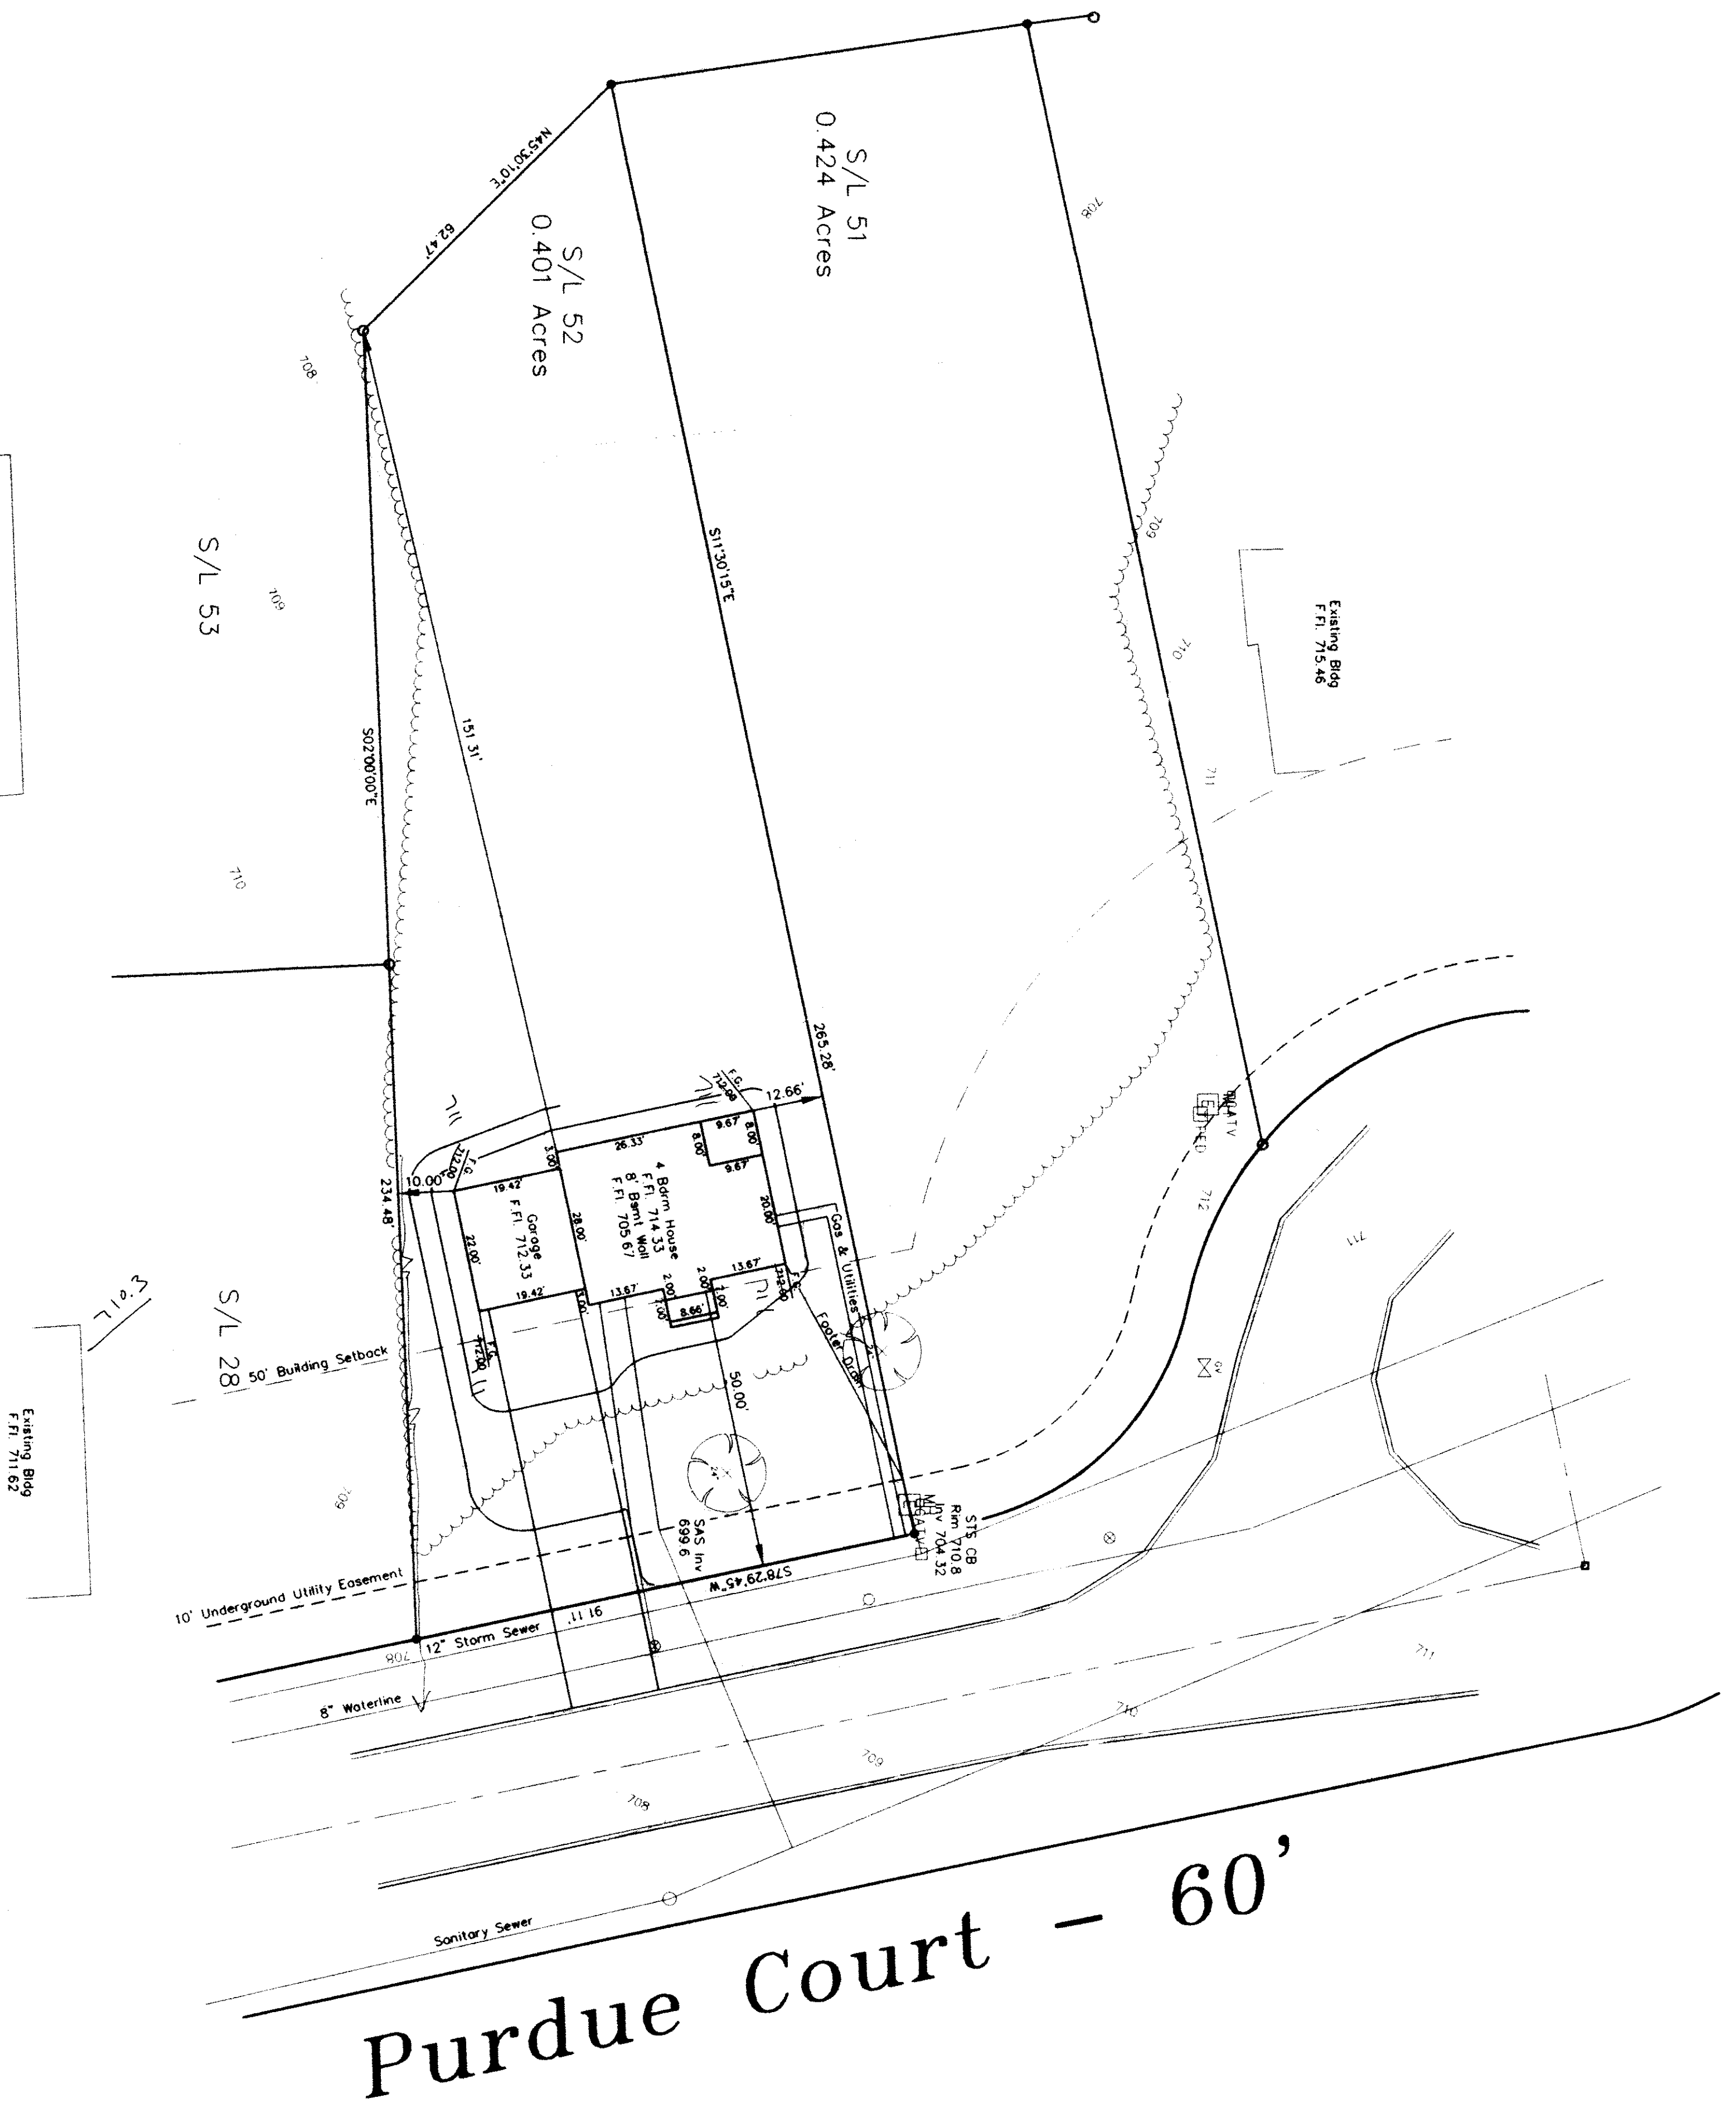


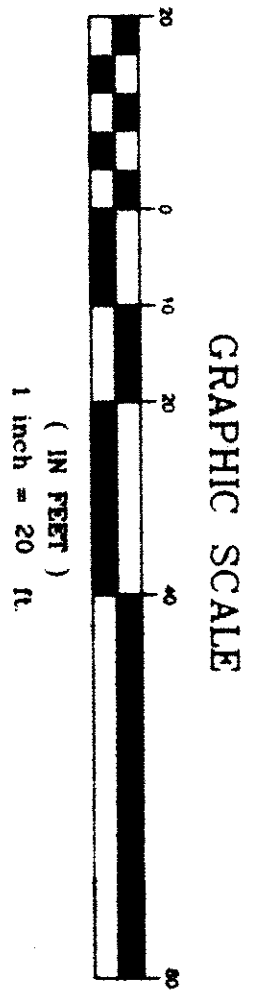


Purdue Court - 60'

ROOF DRAINS
SHALL DISCHARGE
TO SPLASH BLOCKS.

Lower Finished Grade to 711.0

SYMBOL LEGEND	
	Sanitary Manhole
	Iron Pin in Monument Found
	Iron Pin Found
	Water Shutoff Valve
	Fire Hydrant
	Catch Basin
	Cable Television
	Electric Transformer
	Telephone Pedestal
	Gas Valve

APPROVED
PAINESVILLE TOWNSHIP
ZONING DEPARTMENT
#96-0231
D.H. Mc

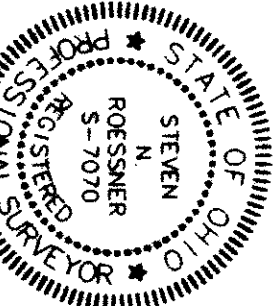

The topography indicated by 'i' contours, and elevations shown herein represent an actual field survey made by Foresight Engineering Group, Inc. on June 12, 1996. The elevations were taken from a datum of 711.0 feet above sea level. The above date is the date of the survey.

Foresight Engineering Group, Inc.

Deco Homes
Heatherstone Subdivision
Painesville Twp. - Lake County - Ohio
Site Plan - S/L 52 - Purdue Court

REVISIONS:

SCALE: Horz. 1" = 20'
Vert. None

FILE NAME:
I:\DEC19610\site.dwg

DATE: June 13, 1996

Foresight Engineering Group
Engineers & Surveyors
216 286-1010
216 286-1034 fax
320 Center Street, Unit F
Chardon, Ohio 44024