


5/6 50

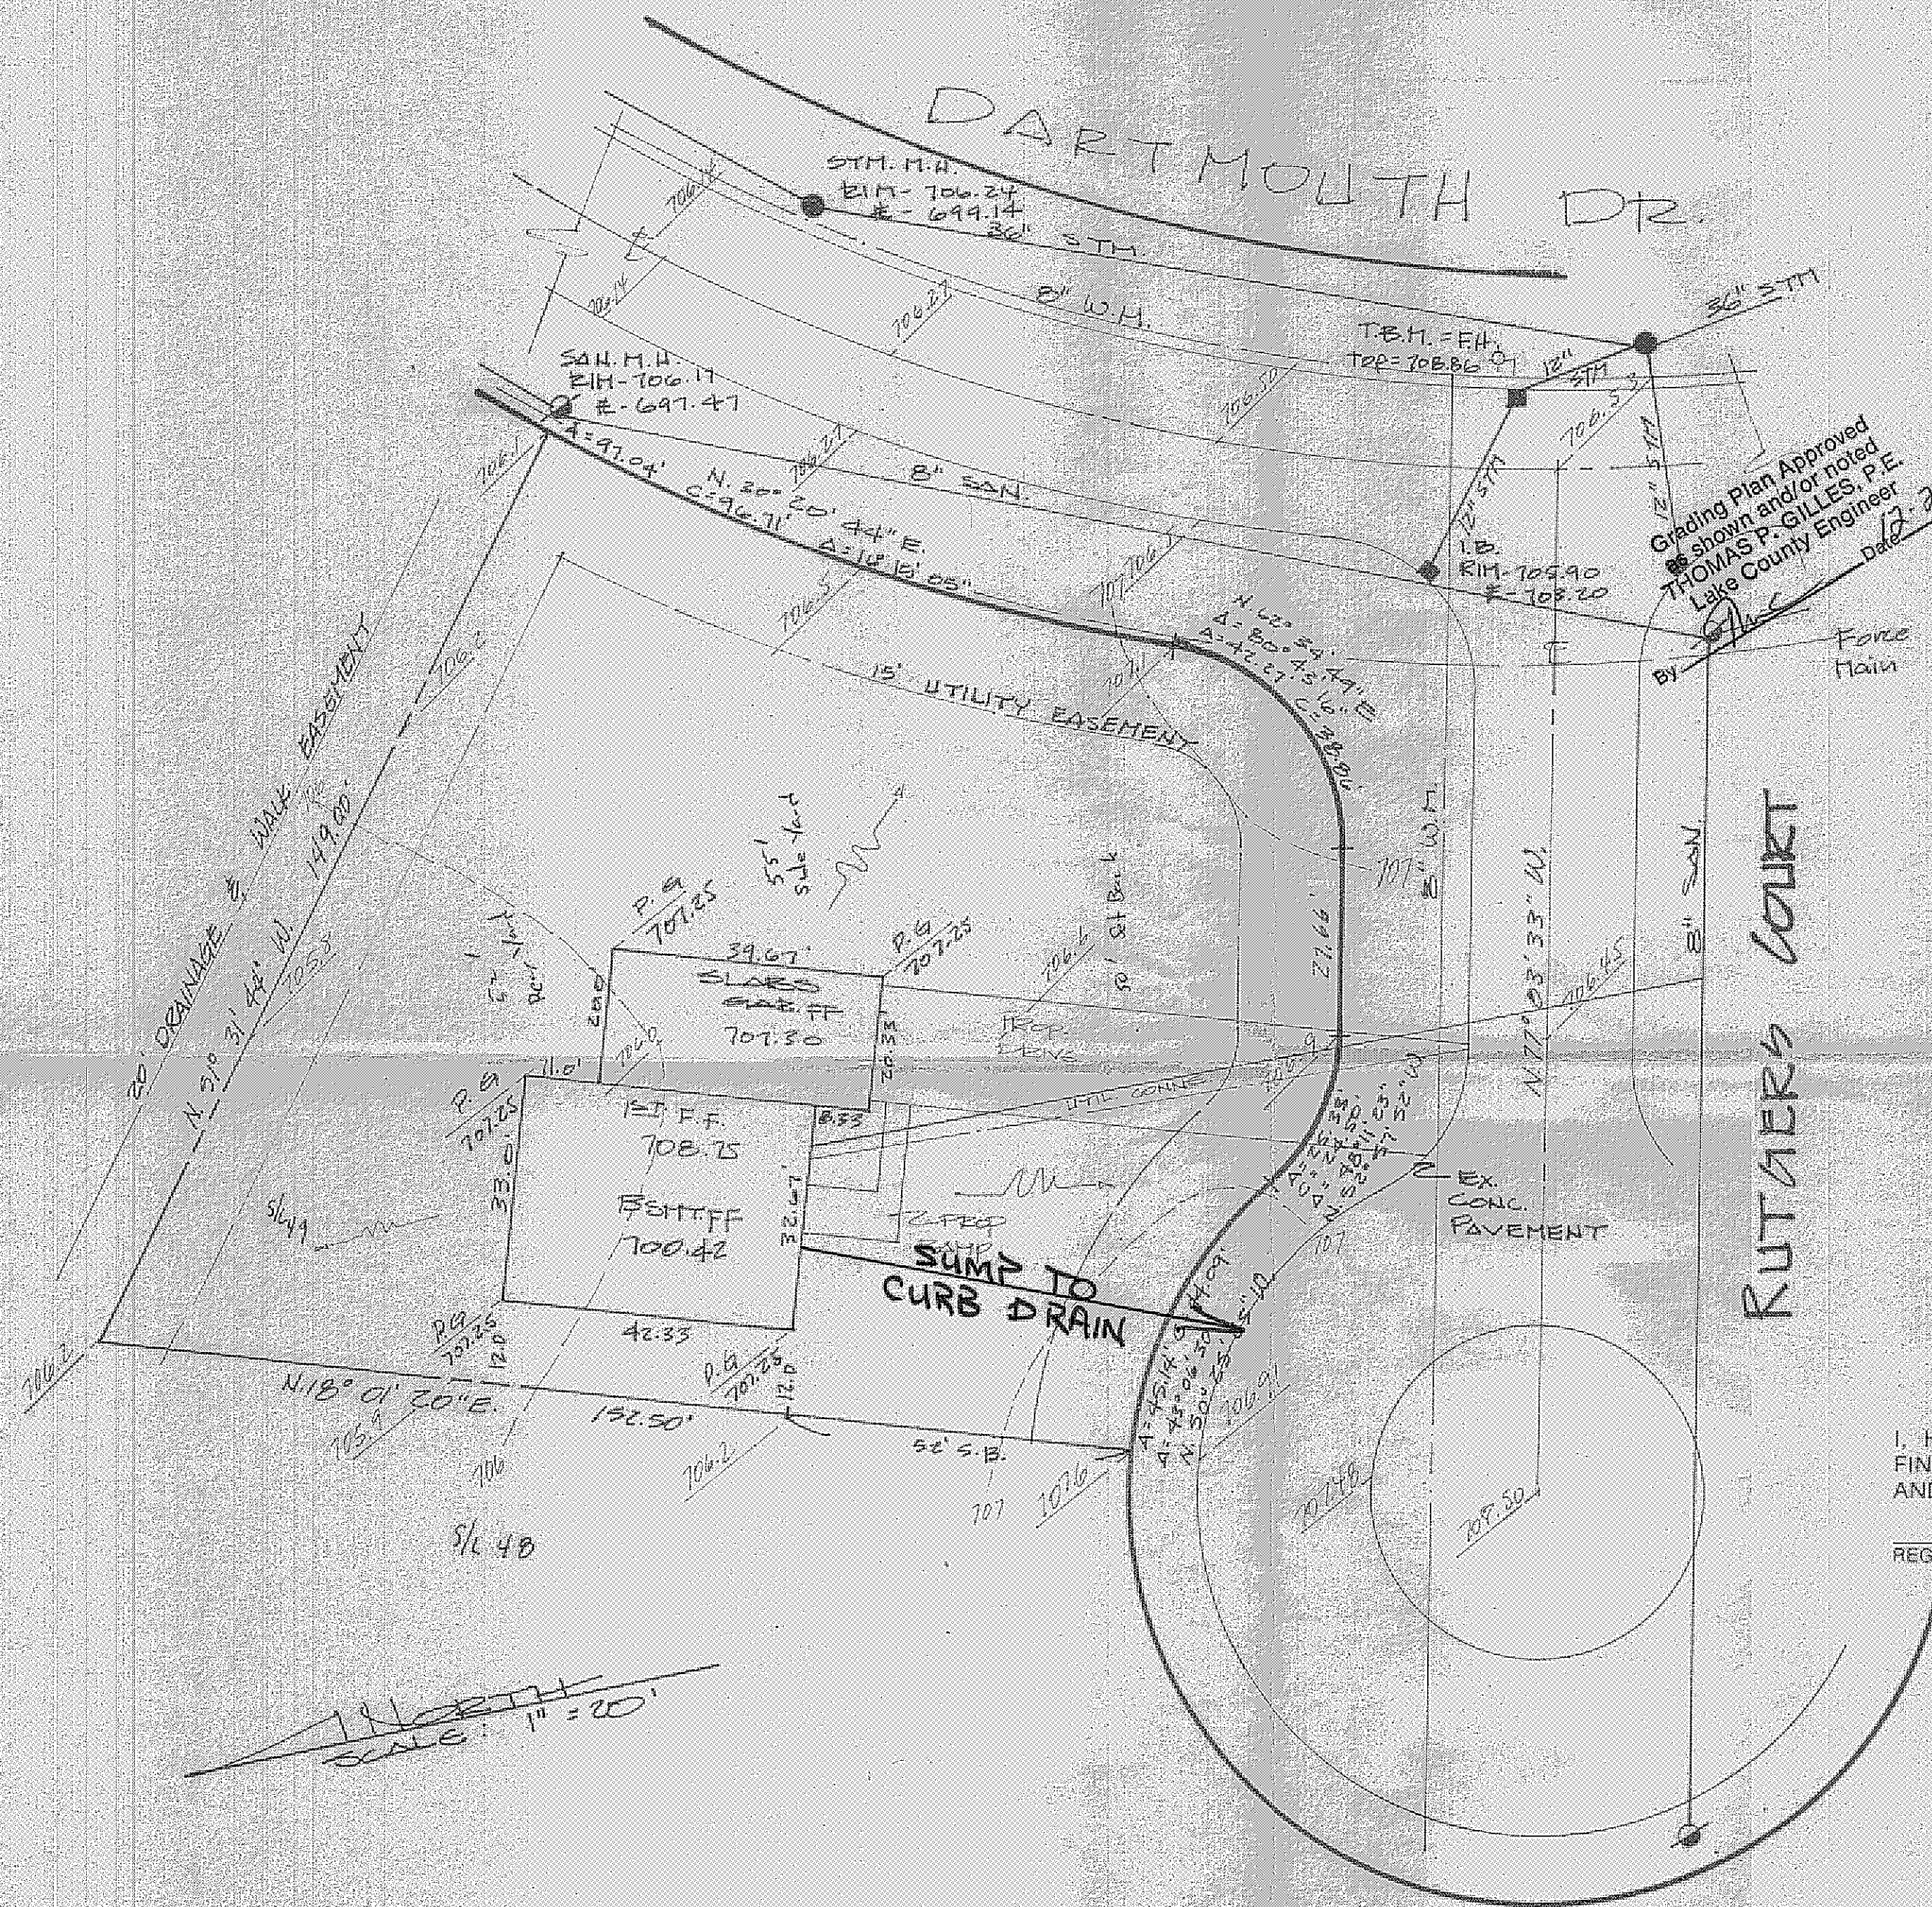

1" = 20'
SCALE

SITE PLAN

PAINESVILLE LAKE COUNTY, OHIO
TOWNSHIP
for: ~~HEATHERSTONE~~ **HEATHERSTONE** LOMES
CLIENT OWNER
1801 CHAMBERLAIN BLVD
ADDRESS STREET CITY ZIP

HEATHERSTONE
SUBDIVISION C-55 NAME
49 VOL. - PG
SUBLOT NO. RUTTERS STREET PERM. PARCEL NO. STREET

LEGEND

SANITARY MANHOLE --- (S) ---
STORM MANHOLE --- (M) ---
INLET OR CATCH BASIN --- (C) ---
HYDRANT --- (H) ---
EXISTING CONTOURS --- (E) ---
PROPOSED CONTOURS --- (P) ---
EXIST. ELEV. --- 100.0 ---
100.0 --- PROP. ELEV.

WATER VALVE (GAS) --- (V) ---
WATER METER (GAS) --- (M) ---
AS BUILT ELEVATION --- (A) ---
INDICATES DIRECTION OF SURFACE DRAINAGE --- (D) ---

REMARKS

ALL BOUNDARY DATA SHOWN WAS OBTAINED FROM (DEEDS, RECORDED SUBDIVISION PLAT OR OTHER PUBLIC RECORDS)
LOCATIONS AS SHOWN OF ADJACENT WELLS AND SEPTIC TANKS OBTAINED FROM LAKE COUNTY HEALTH DEPARTMENT

DESIGN CERTIFICATION

THIS PLAT WAS PREPARED BY ME, AND IS CORRECT TO THE BEST OF MY KNOWLEDGE AND BELIEF.

NAME SURVEYOR REGISTRATION NO.

CHECK LIST

NO. OF BEDROOMS
DIMENSIONS
BEARINGS
TIE TO NEAREST STREET
SUBLOT NO. PARCEL NO.
SURROUNDING OWNERS
BLDG. DIMENSIONS FIN. GR.
BLDG. TIES FL'R. GRADES
APRON TYPE WIDTH THICKNESS
SIDEWALK TYPE WIDTH THICKNESS
CULVERT TYPE DIA., LENGTH
ROCK OUTCROPPINGS

WATER MAIN SIZE, LOCATION
SAN. SEWER SIZE % GR. LOC.
SAN. MH. CAST. ELEV. INV. ELEV.
SAN. CONN. SIZE, LOC. DEPTH
STORM SEWER SIZE % GR. LOC.
STORM MH. CAST. ELEV. INV. ELEV.
PAV'T TYPE GRADE CURBS
GAS LINE LOC. SIZE PRESSURE
SEPTIC TANK LOCATION & DUPLICATION AREA
WELL LOCATION
ISOLATION RADIUS FROM WELL

REVISIONS

NO.	DATE	BY
1		
2		
3		
4		
5		

PLAN PREPARED BY:

BABCOCK • JONES & ASSOCIATES, INC.

270 MAIN ST SUITE #20 PAINESVILLE OHIO

DRAWN BY: SCALE: 1" = 20' PHONE NO. 357-1811

CHK'D. DATE: 12-15-80 DRAWING NO. 80-004

CREW CHIEF APP'D. 3/24

"AS BUILT" CERTIFICATION

I, HEREBY CERTIFY THAT THE CIRCLED GRADES ARE EXISTING FINISH GRADES CHECKED IN THE FIELD ON 19 AND ARE CORRECT TO THE BEST OF MY KNOWLEDGE AND BELIEF.

REGISTERED SURVEYOR

REG. NO.

This Permit Expires

DEC 20 1981

PAINESVILLE TOWNSHIP ZONING APPRO EJ

R. M. Haul Zoning Inspector 12/26/80

NOTICE: BEFORE CONSTRUCTION, Check Painesville Township Office (352-1443) for required Township Road Opening and Driveway Permits.