

Grading Plan Approved
as shown and/or noted
THOMAS P. GILLES, P.E.
Lake County Engineer



By 6/11/97 Date 4/3/97
Scale as shown



GRAPHIC SCALE

(IN FEET)
1 inch = 20 ft

NOTE:
Heatherstone Village Subdivision No. 2, Phase
recorded in Volume 25, Page 1, Lake County Plats

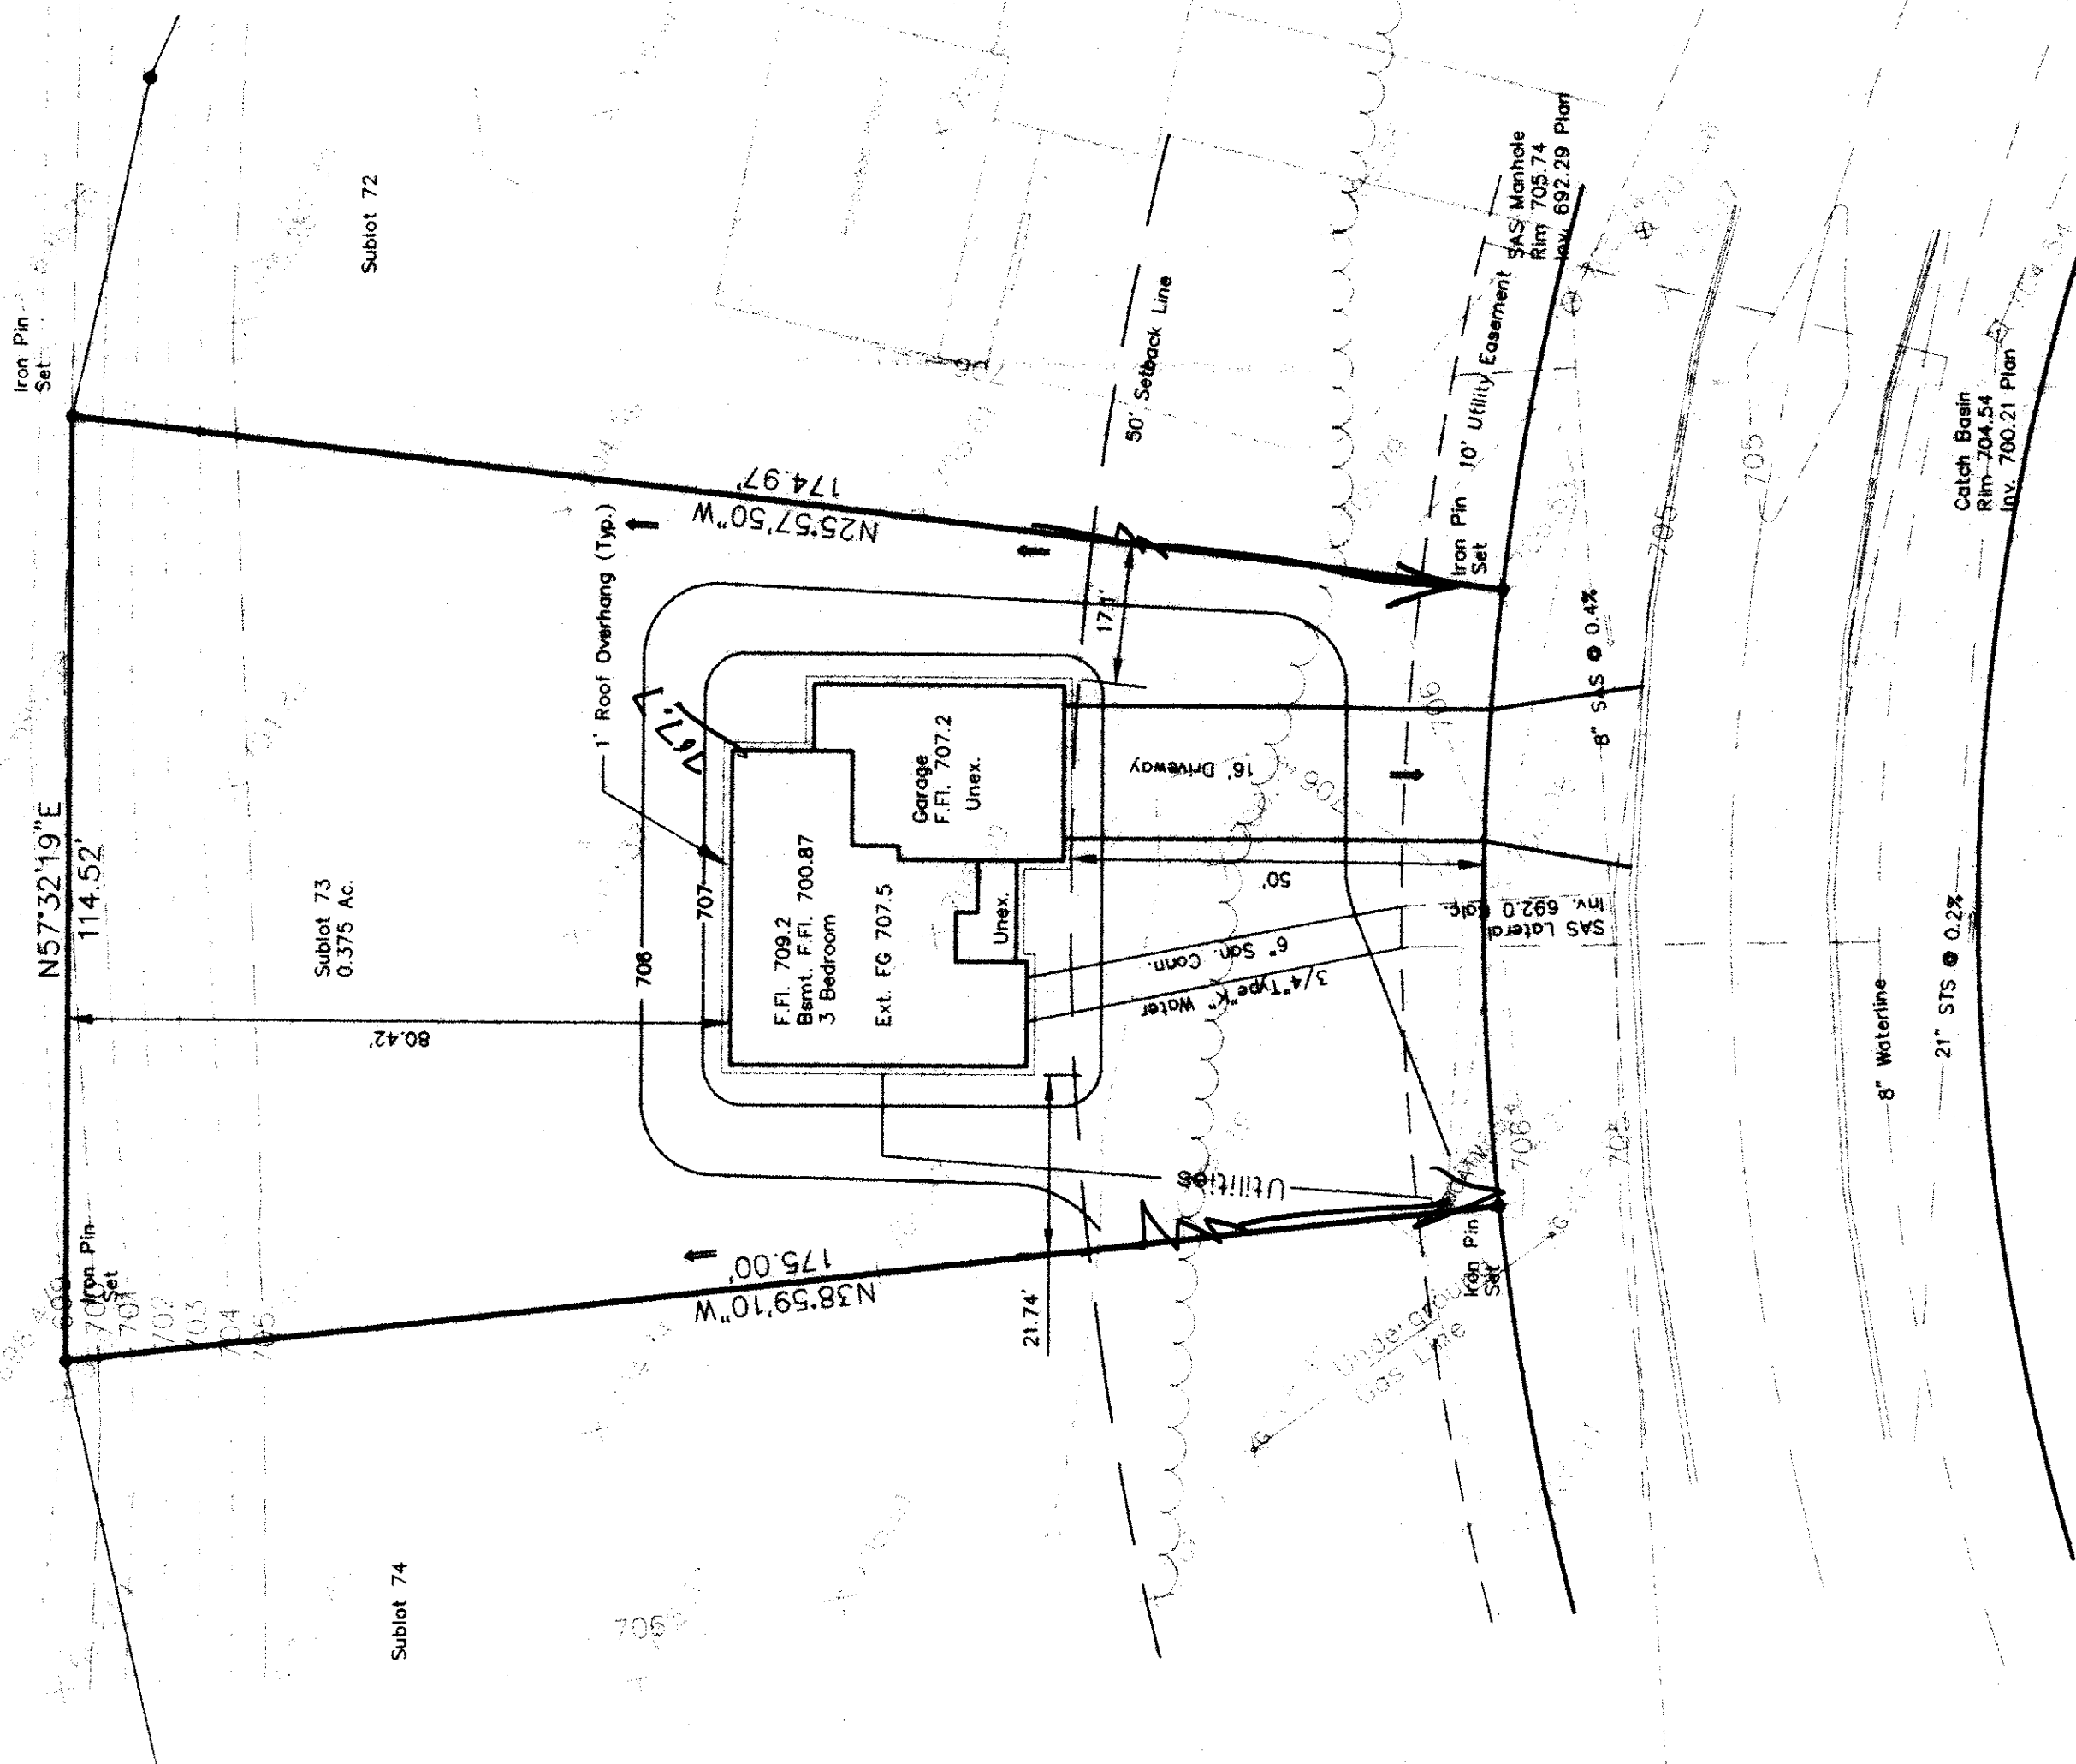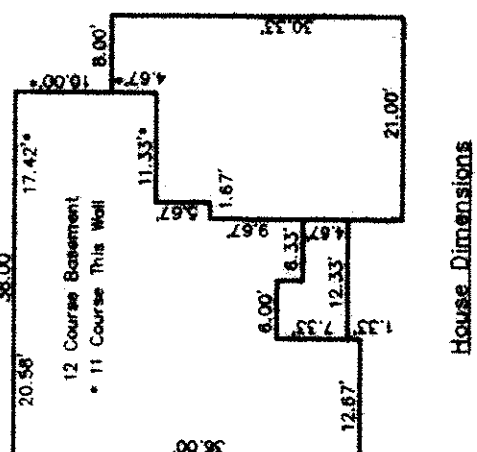

Radley Drive - 60'


$\Delta = 13701.17'$
 $R = 330.00'$
 $T = 37.66'$
 $L = 75.00'$
 $N57.31.30^\circ E$
 $74.84'$

Benchmark - T.S.F.H.
Elev. 707.50

SYMBOL LEGEND	
	Monument Box w/ Pin
	Iron Pin Set
	Cable TV
	Manhole
	Water Shut Off Valve
	Telephone Soc Box
	Electrical box
	Fire Hydrant
	Catch Basin
	Iron Pin Found
	Curb Inlet

The topography, indicated by 1' contours, and elevations shown herein represent an actual field survey conducted by ForeSight Engineering Group, Inc. on October 17, 1996. The elevations were taken at appropriate intervals and as of the above date they existed as indicated herein.

ForeSight Engineering Group, Inc.
3/20/97

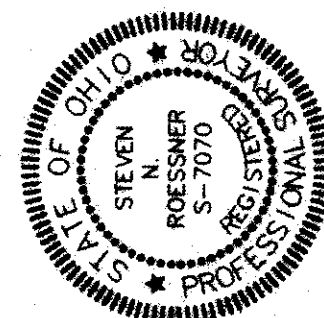

APPROVED
PAINESVILLE TOWNSHIP
ZONING DEPARTMENT

[Signature]