



CURVE	RADIUS	ARC LENGTH	CHORD LEN	CHORD BEARING	DELTA ANGLE	TANGENT
C1	330.00'	77.64'	77.46'	N 51°47'43" W	13°28'49"	39.00'
C2	30.00'	42.10'	38.73'	N 85°15'28" W	80°24'18"	25.35'
C3	274.95'	52.14'	52.07'	S 59°58'22" W	10°51'58"	26.15'

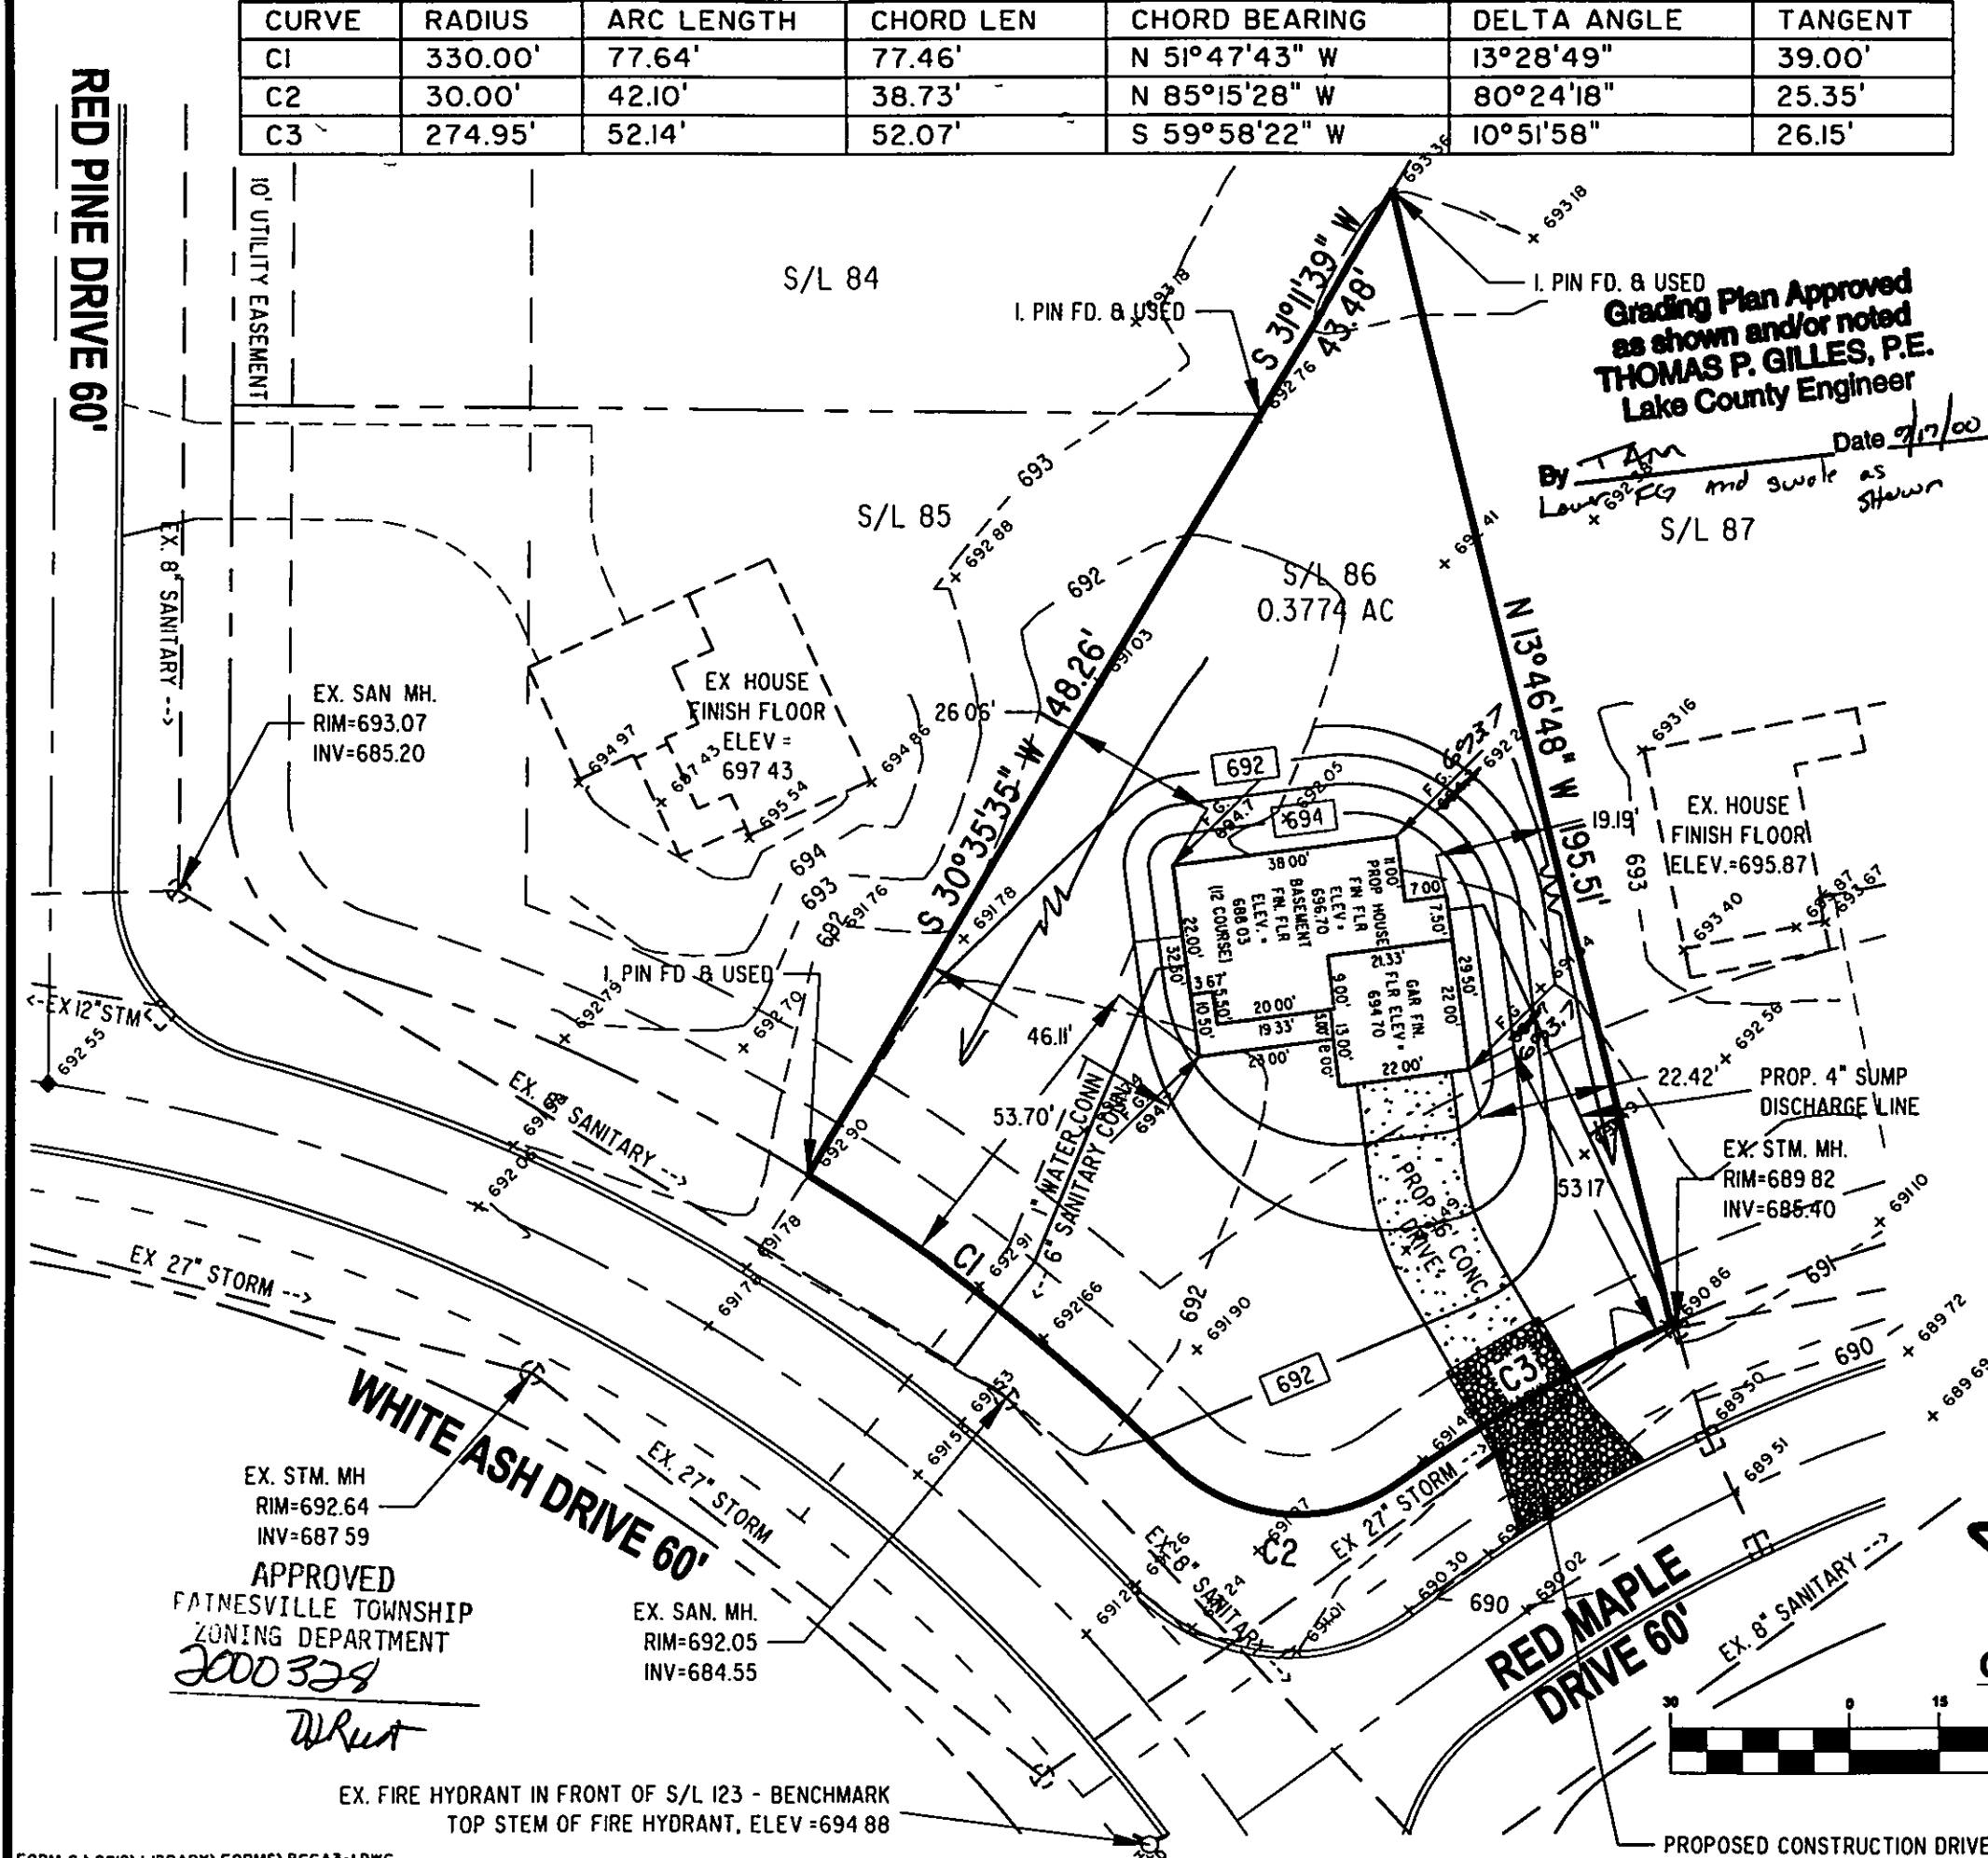

REVISIONS	BY

Barrington
CONSULTING GROUP, INC.
38342 WESTERN PARKWAY, SUITE 10
WILLOUGHBY, OHIO 44094
PHONE 440.946.1761 FAX 440.918.0486

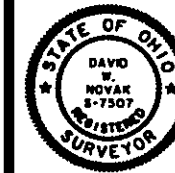

SITE PLAN
SUBLOT 88 CEDAR GLEN
PAINESVILLE TOWNSHIP, OHIO 44077
LITTLE MOUNTAIN HOMES, INC.

DRAWN
D. W. NOVAK
CHECKED
DWN
DATE
SEPT. 8, 2000
SCALE
1" = 30'
JOB NO.
00027
SHEET
111
OF SHEETS