

SITE PLAN FOR BARE BROS. COURT, INC.



OF SUBLOT NO. 98 IN LAKE ERIE SHORES PHASE I IN PAUESVILLE TOWNSHIP, OHIO AS SHOWN BY THE PLAT RECORDED IN VOLUME 42 PAGE 25 OF LAKE COUNTY MAP RECORDS.

NOTES

1. PROPOSED GROUND GRADES
2. EXISTING MEDIAN DRAINAGE FLOW
3. EXISTING MEDIAN TOP AND POINT OF
4. EXISTING 48' ELEV 624.89
5. EXISTING -- EXISTING CULVERTS
6. PROPOSED CULVERTS

THIS SUBDIVISION PREPARED BY
1-A40-639-B512


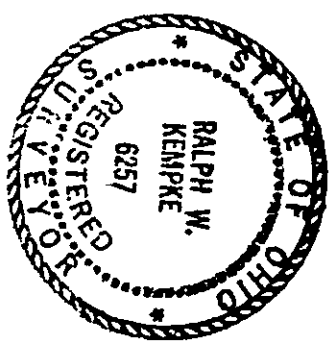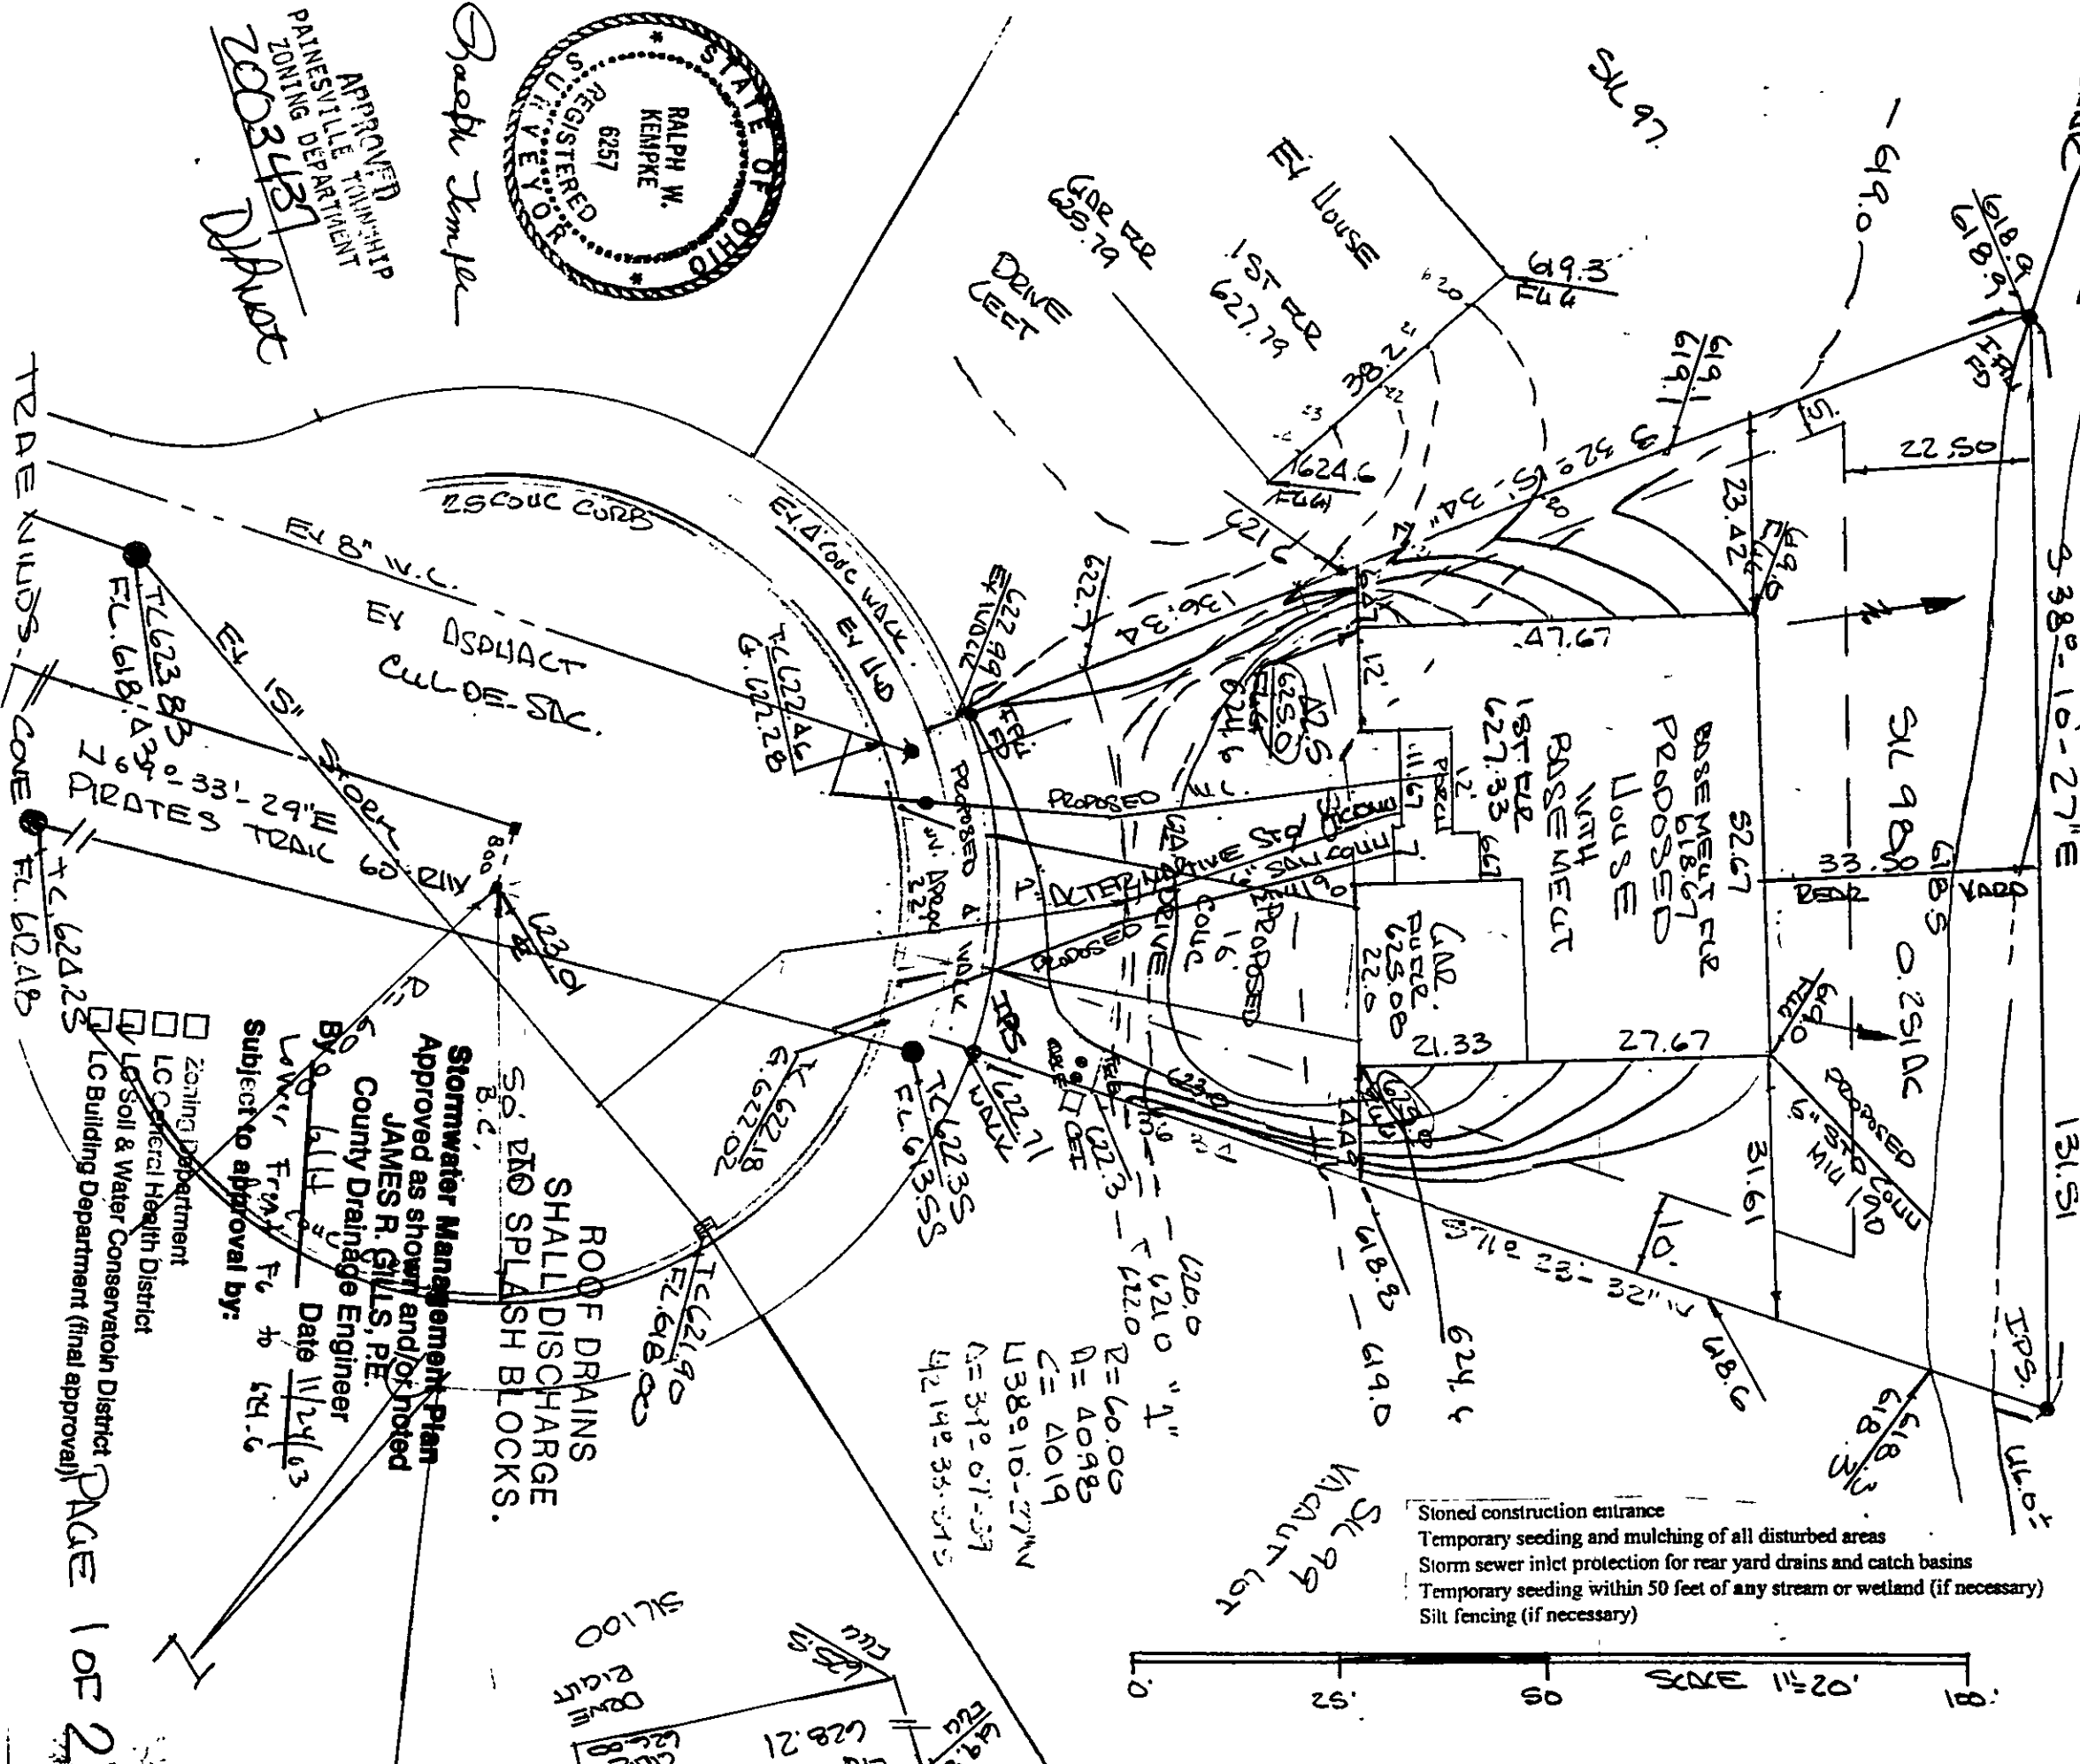

APPROVED
PAINESVILLE TOWNSHIP
ZONING DEPARTMENT
20034231
D. J. JONES

Ralph Kempe

Stormwater Management Plan
Approved as shown and/or noted
JAMES R. GILLIS, P.E.
County Drainage Engineer
Date 11/24/03
Subject to approval by:

- ☐ Zoning Department
- ☐ LC Soil & Water Conservation District
- ☐ LC Building Department (final approval)