



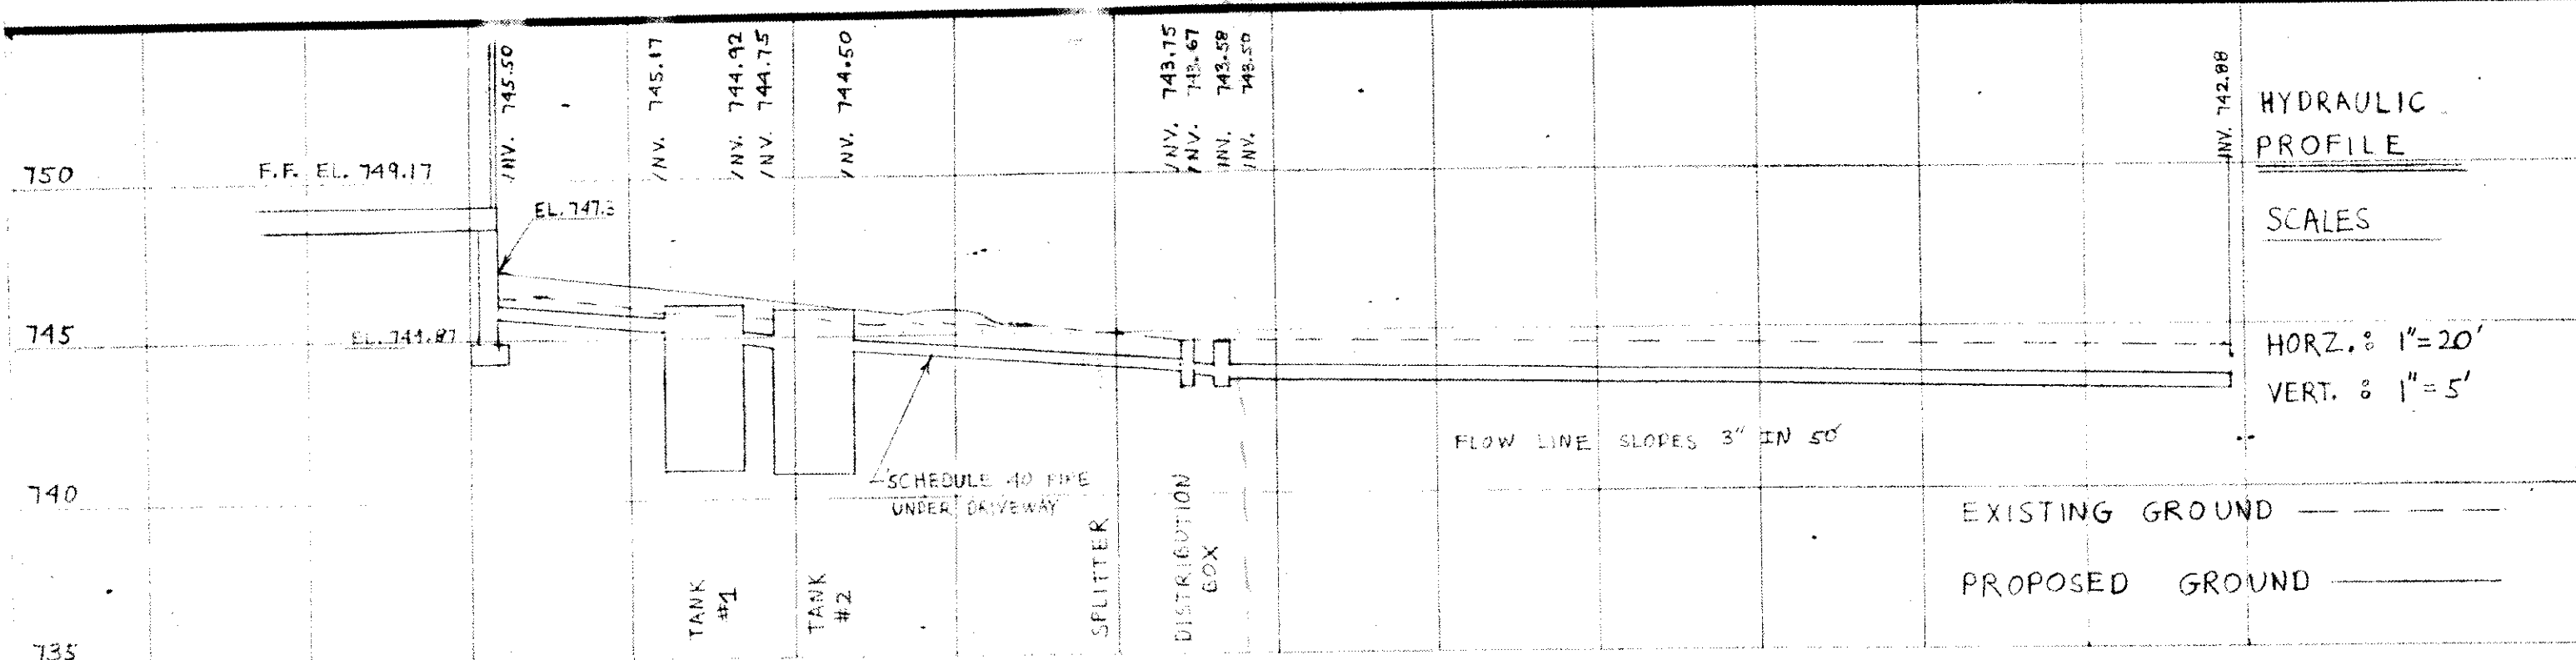

HYDRAULIC
PROFILE

SCALES

HORIZ. : 1"=20'
VERT. : 1"=5'

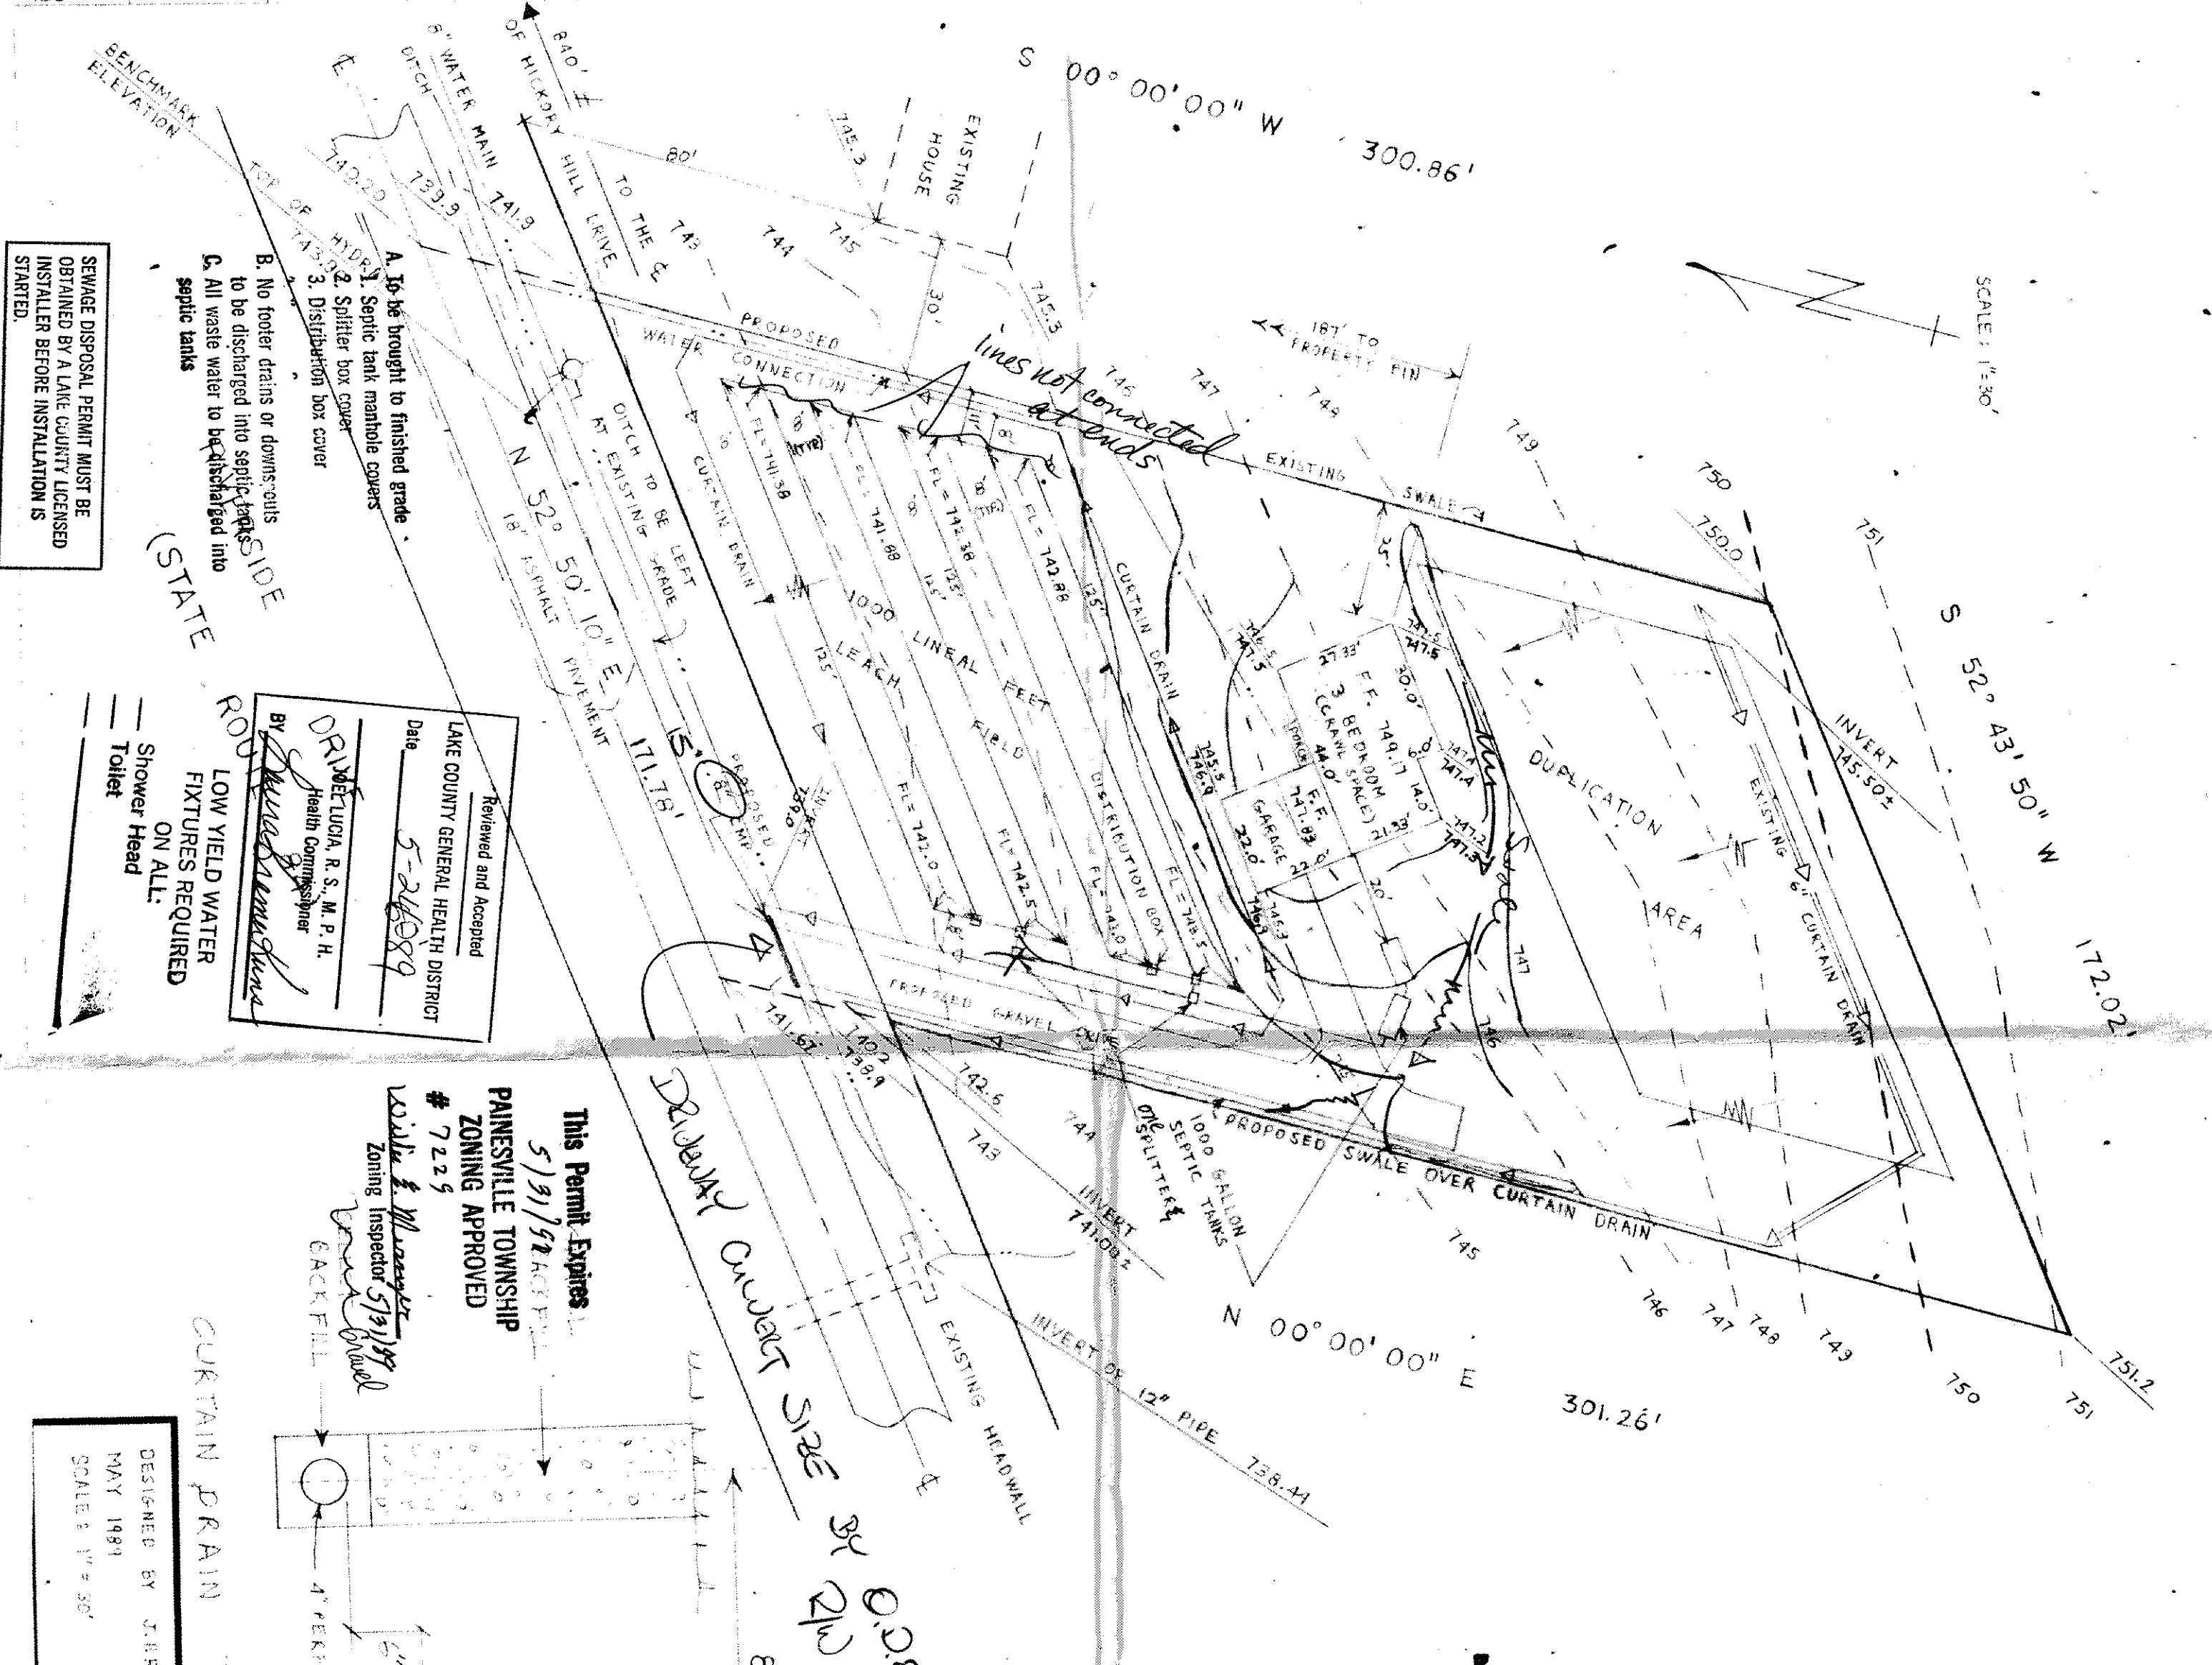

SEWAGE DISPOSAL PERMIT MUST BE
OBTAINED BY A LAKE COUNTY LICENSED
INSTALLER BEFORE INSTALLATION IS
STARTED.


- A. To be brought to finished grade.
- 1. Septic tank manhole covers
- 2. Splitter box cover
- 3. Distribution box cover
- B. No footer drains or down-casts
to be discharged into septic tanks
- C. All waste water to be discharged into
septic tanks

(STATE
SIDE

Reviewed and Accepted
LAKE COUNTY GENERAL HEALTH DISTRICT
Date: 5-24-89
By: [Signature]
Health Commissioner

LOW YIELD WATER
FIXTURES REQUIRED
ON ALL:
Shower Head
Toilet

This Permit Expires
5/31/92
PAINESVILLE TOWNSHIP
ZONING APPROVED
7229
Zoning Inspector 5/31/89
[Signature]

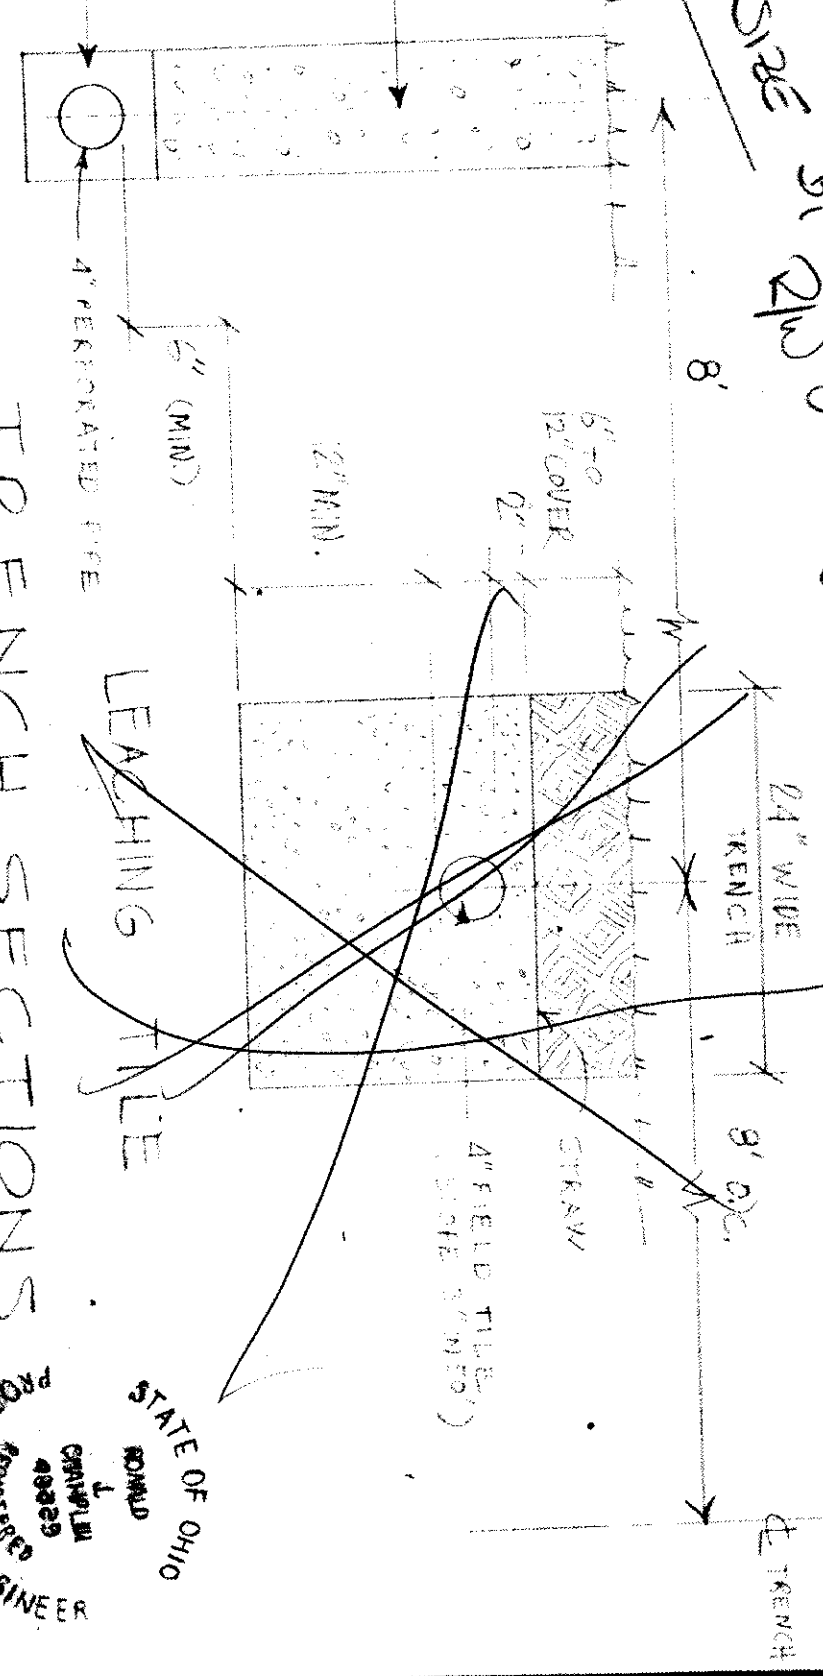

TRENCH SECTIONS
SCALE: 1"=1'

DESIGNED BY J.B.R. PHONE NO. 951-7000
SCALE: 1"=30'

STATE OF OHIO
Professional Engineer
[Signature]

Grading Plan Approved
[Signature]
Date 5-24-89

SITE PLAN PAINESVILLE TWP., LAKE COUNTY, OHIO for: JEFFERY ROSS. 13600 ROUTE 96 PAINESVILLE, OH 44077	
LOT 20 TRACT 1	PERMANENT PARCEL NO. 11A-17-14
1210 RIVERSIDE DRIVE (S.R. 84)	
LEGEND	
HYDRAULIC	INDICATES
EXISTING CONTOURS	DIRECTION OF
PROPOSED CONTOURS	CURVE DRAINAGE
EXIST. ELEV. 1000	PROP. ELEV. 1000