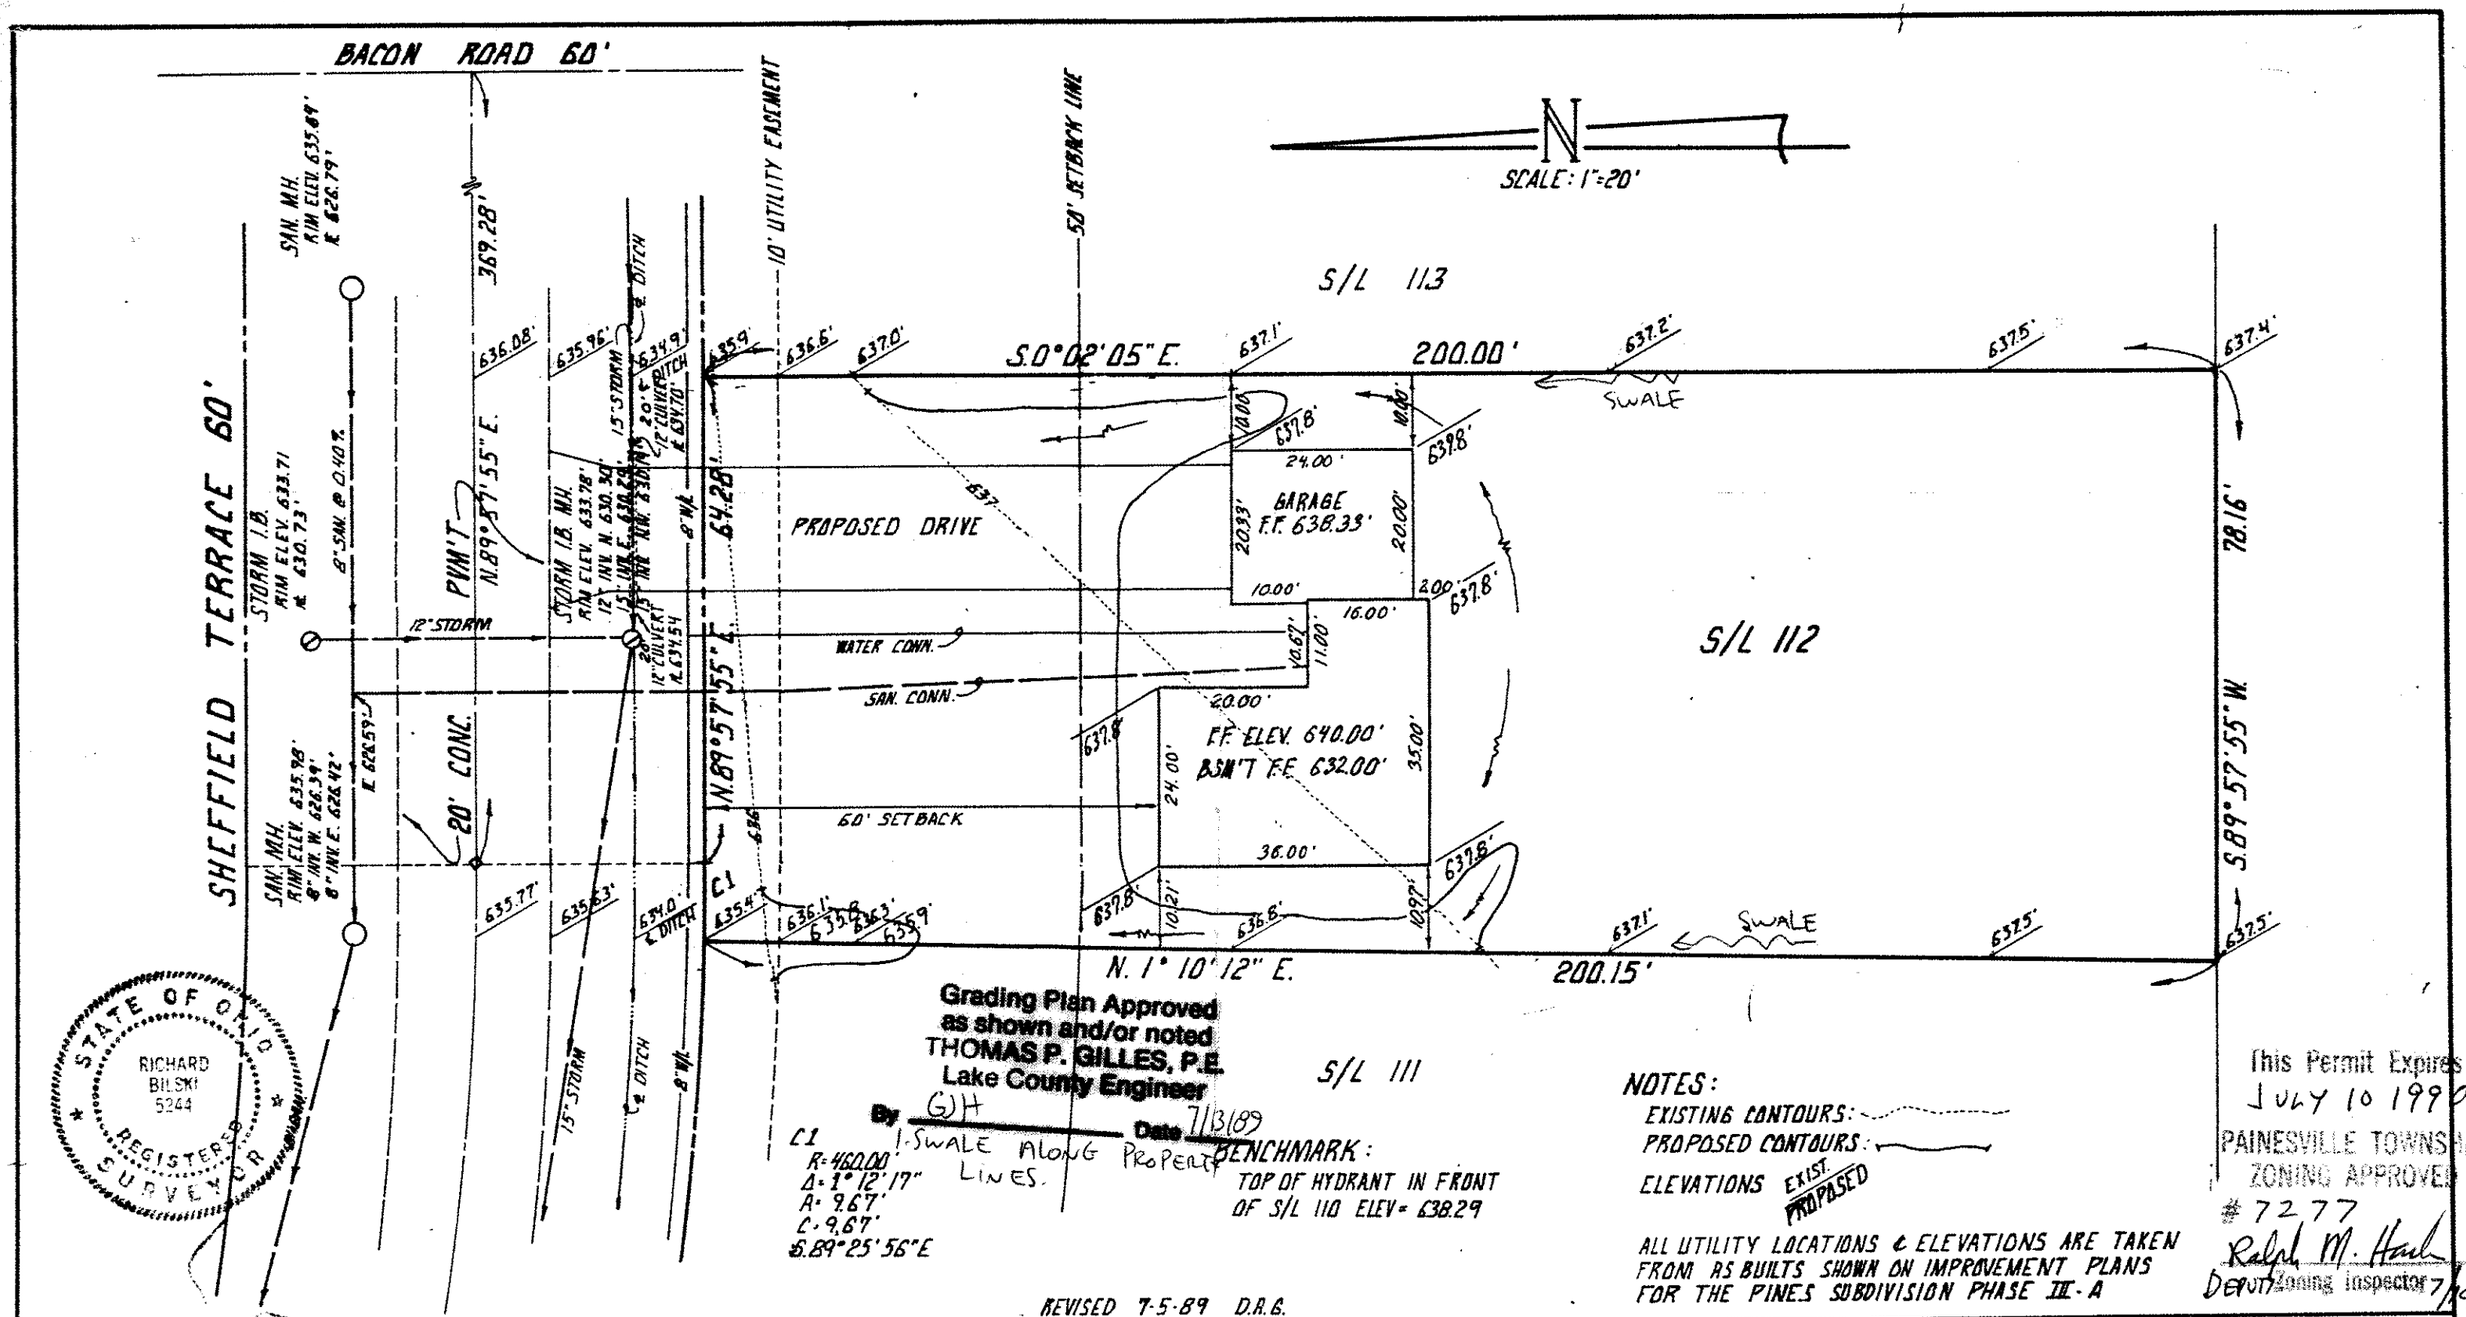

DESIGN CERTIFICATION	AS BUILT CERTIFICATION			SITE PLAN for EDWARD H. TRESGER, INC.
THIS PLAT WAS PREPARED BY ME, AND IS CORRECT TO THE BEST OF MY KNOWLEDGE AND BELIEF.	I HEREBY CERTIFY THAT THE CIRCLED GRADES ARE EXISTING FINISH GRADES CHECKED IN THE FIELD ON _____ AND THAT SURVEY IS CORRECT TO THE BEST OF MY KNOWLEDGE AND BELIEF.	COLPETZER-THOMAS, INC. AN ENGINEERING GROUP WILLOUGHBY • MENTOR • NORTH CANTON • STEUBENVILLE • LORAIN	DATE JUNE 28 1989 SCALE 1"=20' DRWN BY D.R.G. CHKD BY JOB NO 88-592 FB 682 PG 98	BEING SUBLOT # 112 IN THE PINES SUBD. PHASE III-A (VOL. 11 PG. 22) PAINESVILLE TOWNSHIP, LAKE COUNTY, OHIO
REG. SURVEYOR NO. 5244	REG. SURVEYOR NO _____			

010-01-310