
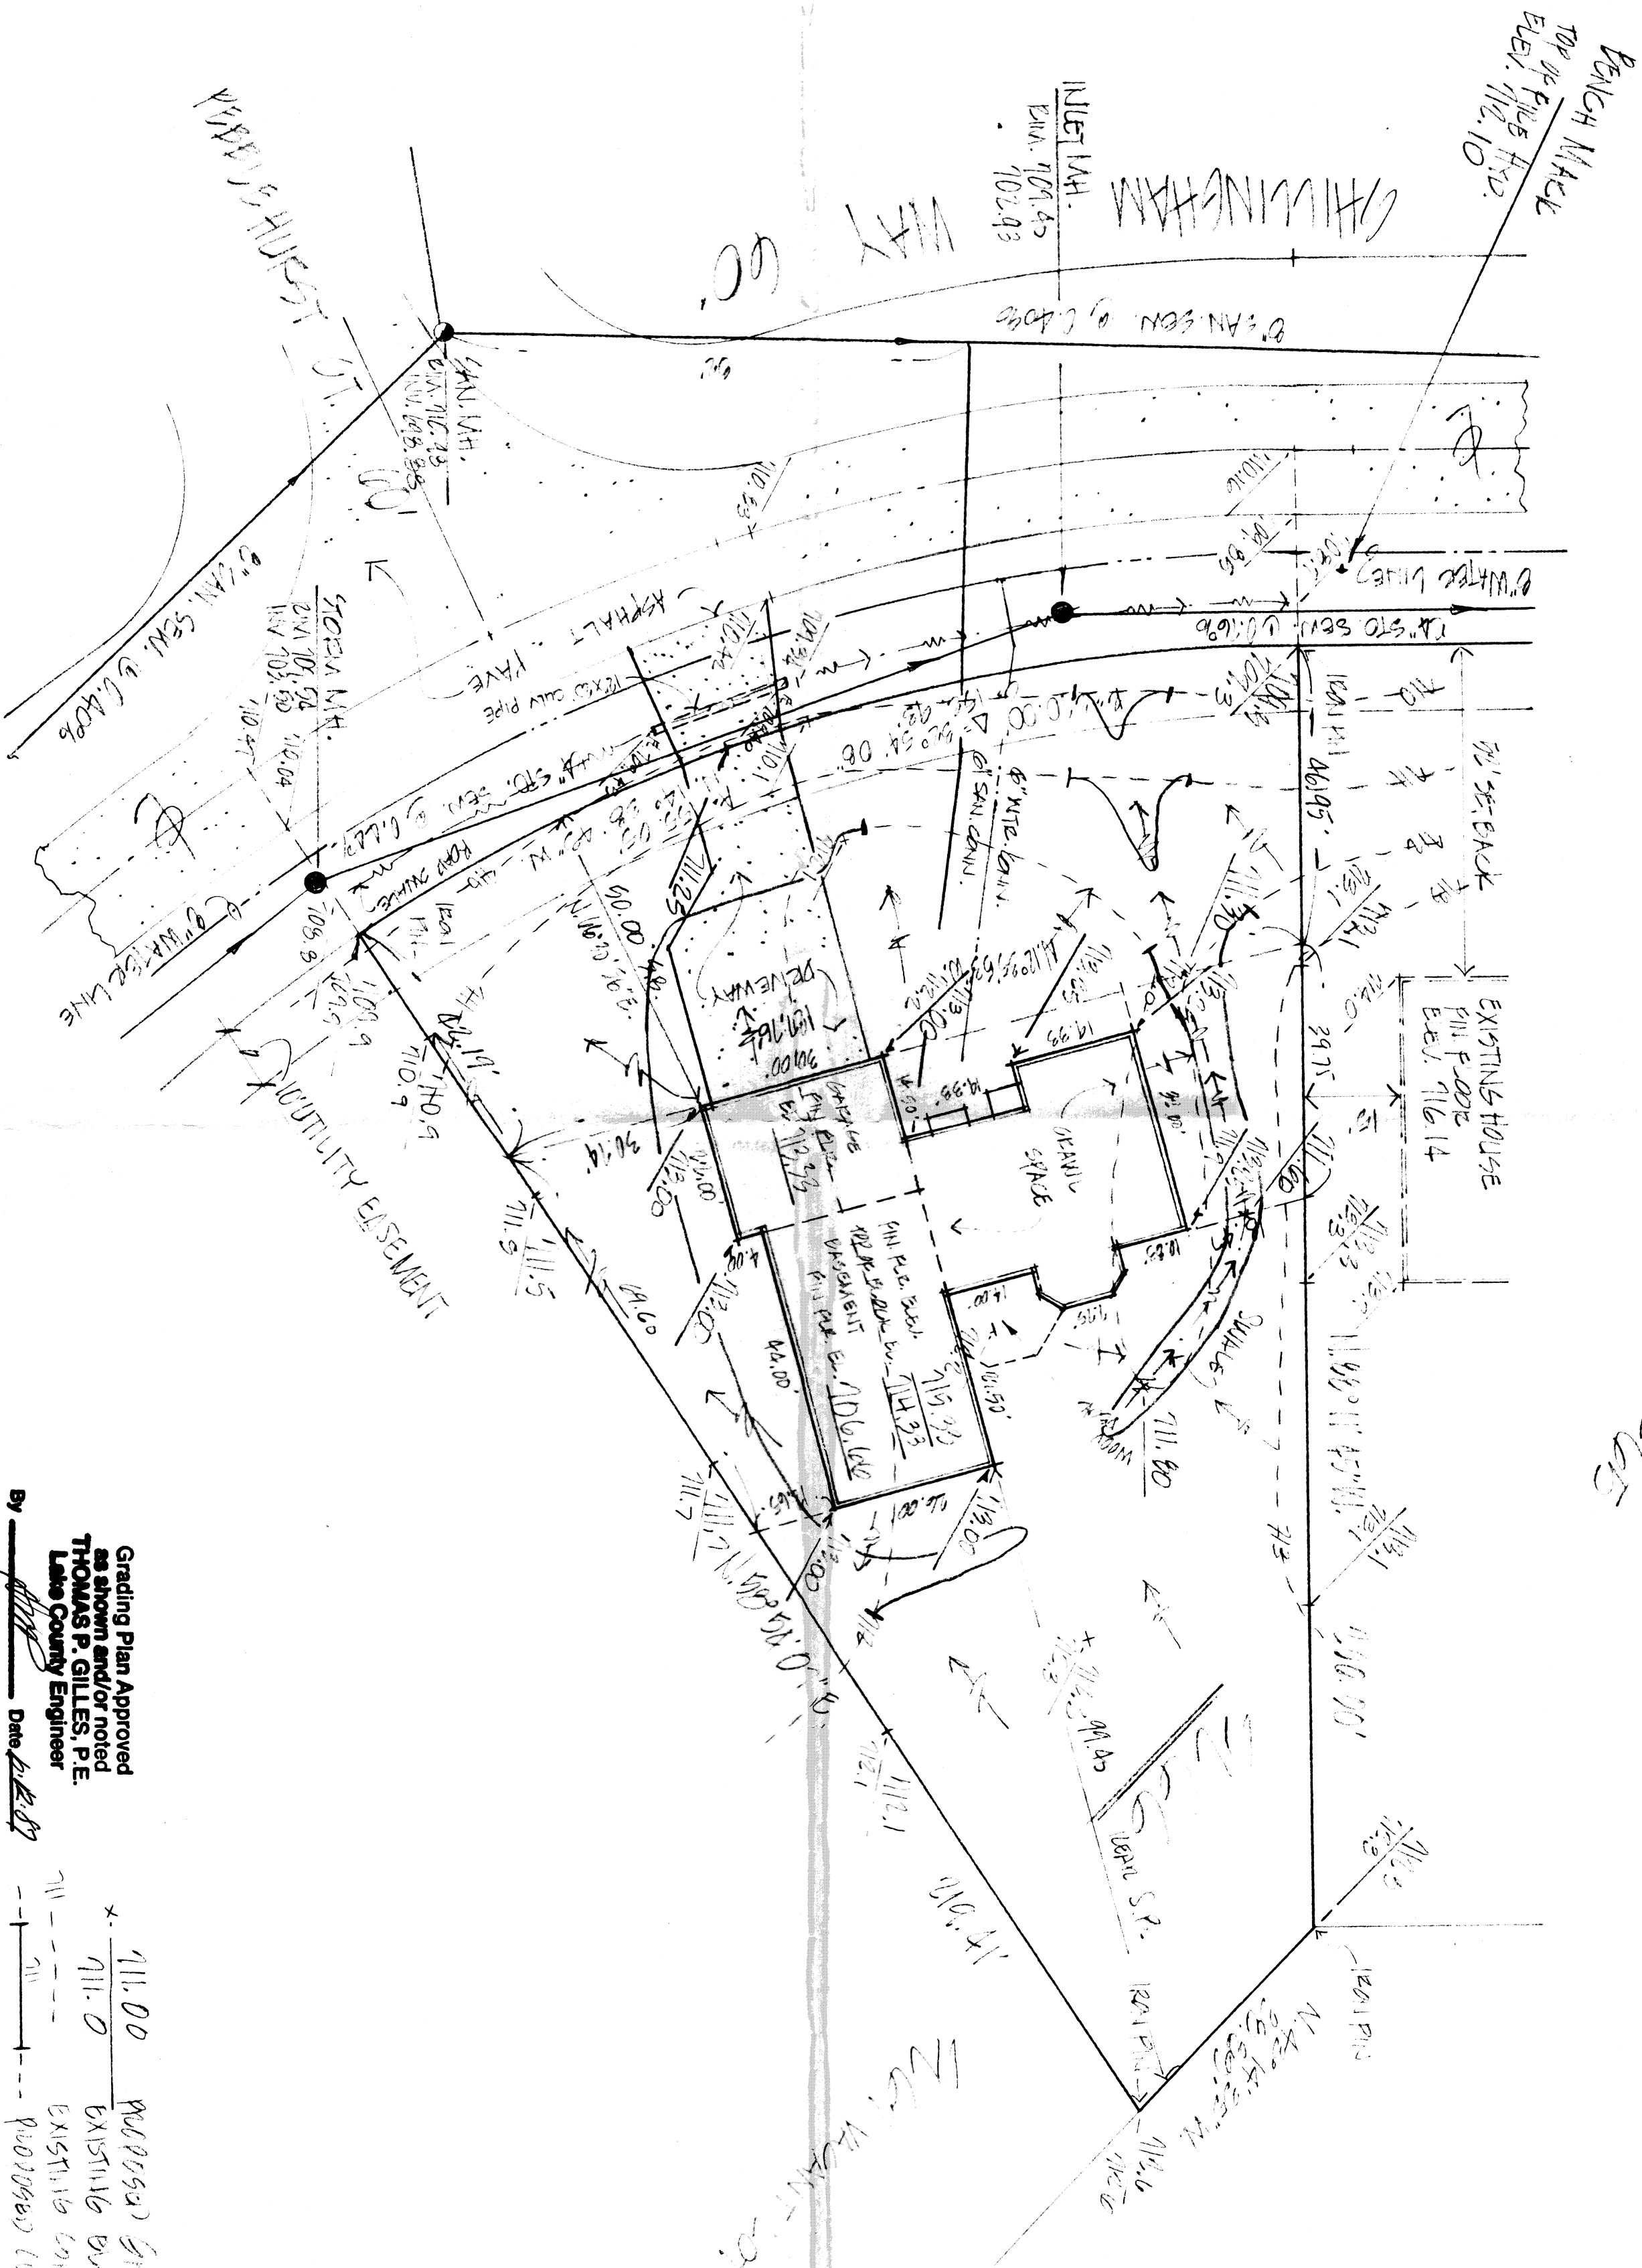


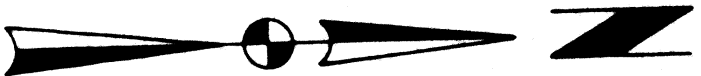

VEHICLE CERTIFICATION:
I HEREBY CERTIFY THAT THIS PLAN IS CORRECT TO THE BEST OF MY KNOWLEDGE AND BELIEF.
BY: *[Signature]*
RICHARD BLASI, P.E., No. 5244

Grading Plan Approved
as shown and/or noted
THOMAS P. GILLES, P.E.
Lakes County Engineer

By: *[Signature]* Date: *6/2/87*
EXISTING ELEVATIONS
PROPOSED CONTOUR LINES

This Permit Expires
6-8-88
PAINEVILLE TOWNSHIP
ZONING APPROVED
6772
W. L. & M. L. [Signature]
Zoning Inspector 6/8/87

SITE PLAN FOR:

A. D. SIDLEY INC.
1501 WASHINGTON AVENUE, PAINEVILLE, OHIO
BEING SUBLOT NO. 66 IN KINGS FORDHAM SUBDIVISION IN PAINEVILLE TOWNSHIP, LAKE COUNTY, OHIO.

DATE: 6/2/87
SCALE: 1"=20'
DRAWN BY: [Signature]
CHECKED BY: [Signature]
F&E: [Signature] No. 57

CT COLPETZER-THOMAS, INC.
AN ENGINEERING GROUP
WILLOUGHBY • MENTOR • NORTH CANTON • STEUBENVILLE • LORAIN

SHEET 1 OF 1
CONTRACT NO. 91-340