

1225

EXIST.
PROP.

EXIST.	PROP.
1	1
2	2
3	3
100	100

- A. To be brought to finished grade
1. Septic tank manhole covers
2. Splitter box cover
3. Distribution box cover
- B. No footer drains or down-roots
- C. To be discharged into septic tanks
- D. All waste water to be discharged into septic tanks

Reviewed and Accepted
LAKE COUNTY GENERAL HEALTH DISTRICT

Date: 7-12-84

JOEL LUCIA, R. S., M. P., H.


Health Commissions

5

**LOW YIELD WATER
FIXTURES REQUIRED
ON ALL:**

Shower Head
Toilet

SEWAGE DISPOSAL PERMIT MUST BE OBTAINED BY A LAKE COUNTY LICENSED INSTALLER BEFORE INSTALLATION IS STARTED.

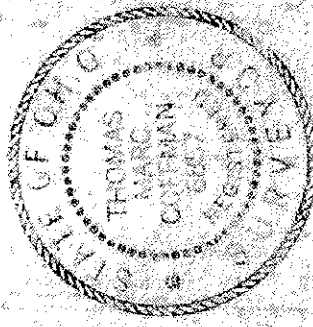

THIS PLAT WAS PREPARED BY ME AND IS ACCURATE TO THE BEST OF MY KNOWLEDGE AND BELIEF.

Howard M. Giffman P-5
D 6857

This Permit Expires
July 14, 1990
PAINESVILLE TOWNSHIP
ZONING APPROVED

#7280 & 7281

R. V. - Frank
22007 Zoning Inspector 7/14/89

VILLAGE SURVEYING CO. Inc.
202 THIRD ST., FAIRPORT HARBOR, OHIO, 44077
(216) 357-1360

**Grading Plan Approved
as shown and/or noted
THOMAS P. GILLES, P.E.
Lake County Engineer**

6514 Date 7/17/89