



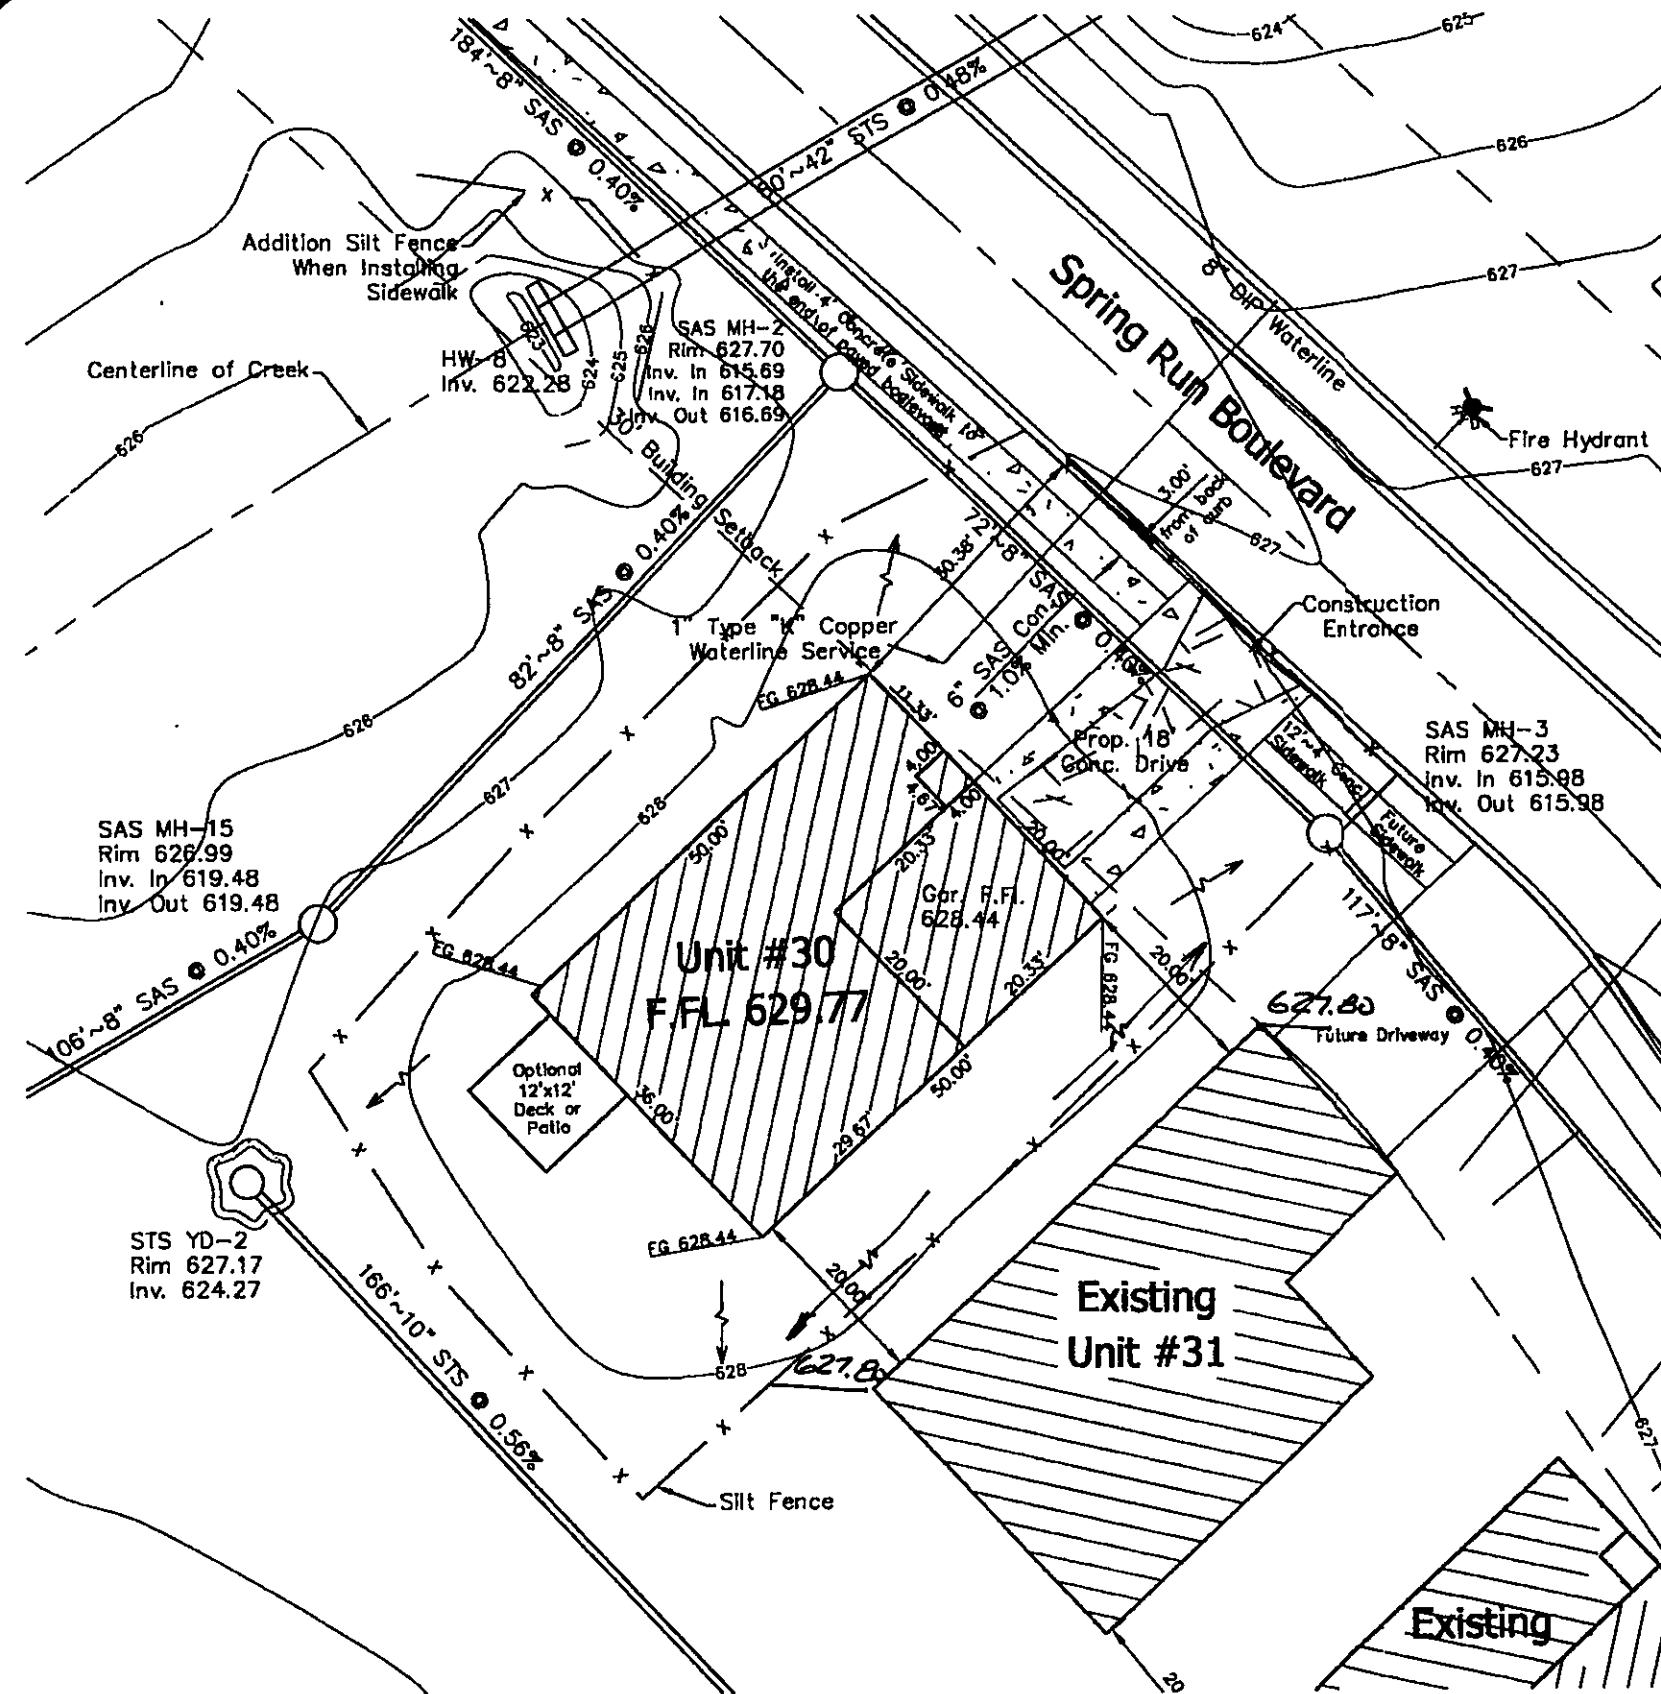

GRAPHIC SCALE

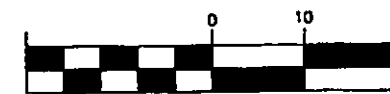


(IN FEET)
1 inch = 20 ft.

LEGEND	
	Gate Valve
	Fire Hydrant
	Curb Inlet
	Filter Fabric
	Manhole

Stormwater Management Plan
Approved as shown and/or noted
JAMES R. GILLS, P.E.
County Drainage Engineer
Date 2/22/08

APPROVED
Painesville Township
Zoning Department
[Signature]
2/14/08

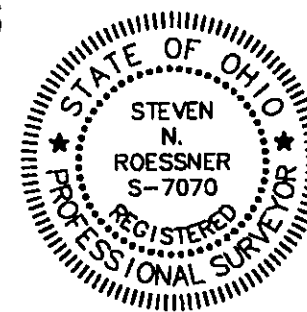

"I, the undersigned hereby certify that this topography, indicated by 1' contours, and the elevations shown hereon represent an actual field survey made by Foresight Engineering Group, Inc. on the 2 day of October, 2004 and that the elevations were taken at appropriate intervals and that as of that date they existed as indicated hereon."
[Signature]
NAME

ENGINEER
Foresight Engineering Group, Inc.
320 Center Street Unit F
Chardon, Ohio 44024
(440) 286-1010
Chad E. Graber, P.E.

DEVELOPER
B.R. Knez Construction, Inc.
3375 Blackmore Road
Perry Township, OH 44081
Phone (440) 259-0087

Foresight Engineering Group
Engineers & Surveyors
440 286-1010
320 Center Street, Unit F
Chardon, OH 44024

SCALE: Horiz. 1" = 20'
VERT. 1" = 20'

FILE NAME: K:\K1\0001\Jalil.plot
DATE: February 20, 2005

REVISIONS:

B.R. KNEZ CONSTRUCTION, INC.
The Brooks-Phase One
Painesville Township - Lake County - Ohio
Site Plan - Unit 30

SHEET NO.
1/1