


BENCHMARK-631.07 N. RIM
SAN. MH. INV.-618.57

EXIST.
PROP.

SCALE: 1" = 20'

Y
R-1300.08'
A-40.00'
C-40.00'
B-S 67°16'04"W

X
CURVE DATA
R=1200.08'
A=36.92'
C=36.92'
B=N 67°16'04"E

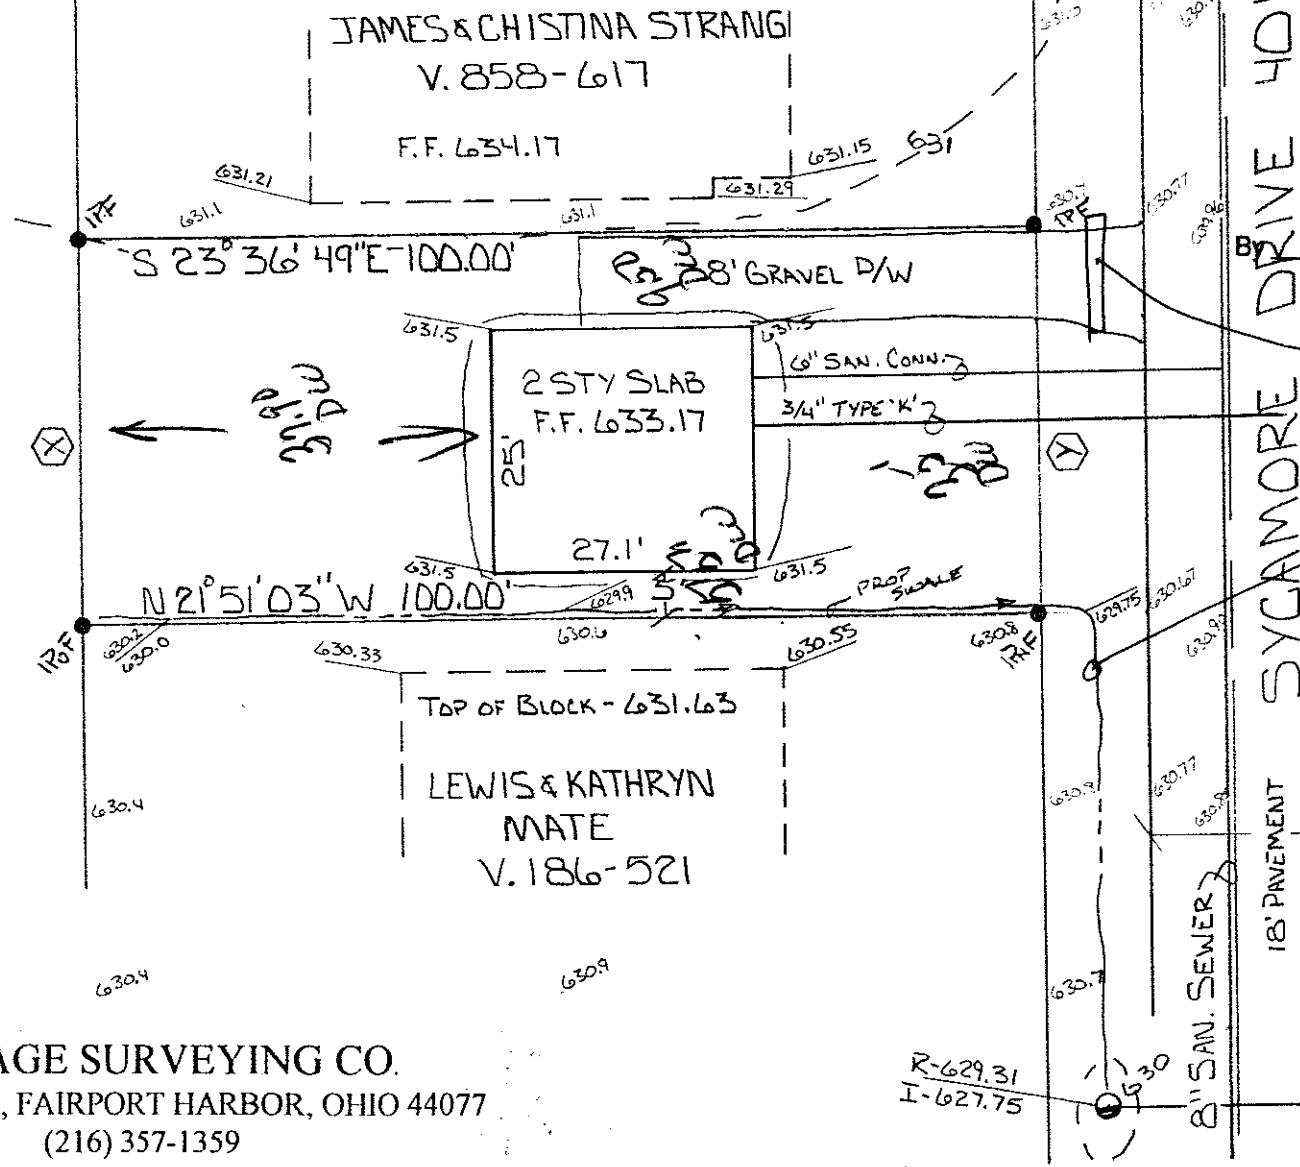

Grading Plan Approved
as shown and/or noted
THOMAS P. GILLES, P.E.
Lake County Engineer


3-14-97
Date

BEING KNOWN AS 5/4 39 PAINESVILLE-ON-THE-LAKE, PAINESVILLE TOWNSHIP, LAKE COUNTY, OHIO.

I, the undersigned hereby certify that
this topography, indicated by 1' contours,
and elevations shown hereon represent an
actual field survey made by me on 02-27-97
and that the elevations were taken at
appropriate intervals and that as of that
date they existed as indicated hereon.

J. M. Coffman P.E.
THOMAS M. COFFMAN P.S. No. 6857

APPROVED
PAINESVILLE TOWNSHIP
ZONING DEPARTMENT
4-7-22
D. Rust

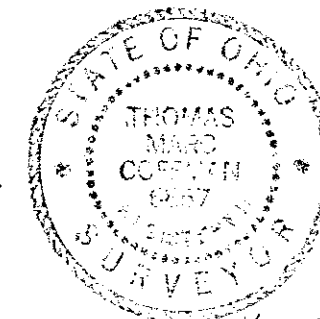

MARCH 7, 1997

VILLAGE SURVEYING CO.
P.O. BOX 1096, FAIRPORT HARBOR, OHIO 44077
(216) 357-1359