



JOB NUMBER:	0600710	DATE:	8-28-06
DRAWN BY:	GRT	CHECKED BY:	F E W
NO.	REVISION	BY	DATE

10 West Erie Street, Suite 201 Painesville, Ohio 44077  
 Phone (440) 362-6556/642-0041 Fax (440) 362-6198  
 oxbowengineering@bcglobe.net  


**RYAN HOMES at TRADEWINDS VILLA CONDOMINIUMS**  
**SITE PLAN**  
 LAKE ERIE SHORES - BLDG No.2  
 PAINESVILLE TOWNSHIP  
 LAKE COUNTY - OHIO

**APPROVE**  
 Painesville T  
 Zoning Dept  
*2006343 DFW*  
*11/3/06*


**LEGEND:**

 FUTURE 12'x12' DECORATIVE CONCRETE PATIO BY OWNER

NOTE: SEE SHEET 2 OF 2 FOR BUILDING DIMENSIONS.

- ① Landscape mound to be finished NORTH of Bldg 2
- ② Landscaping to be installed at driveway entrances (can be charged to both sides of driveway)

**CURVE DATA:**  

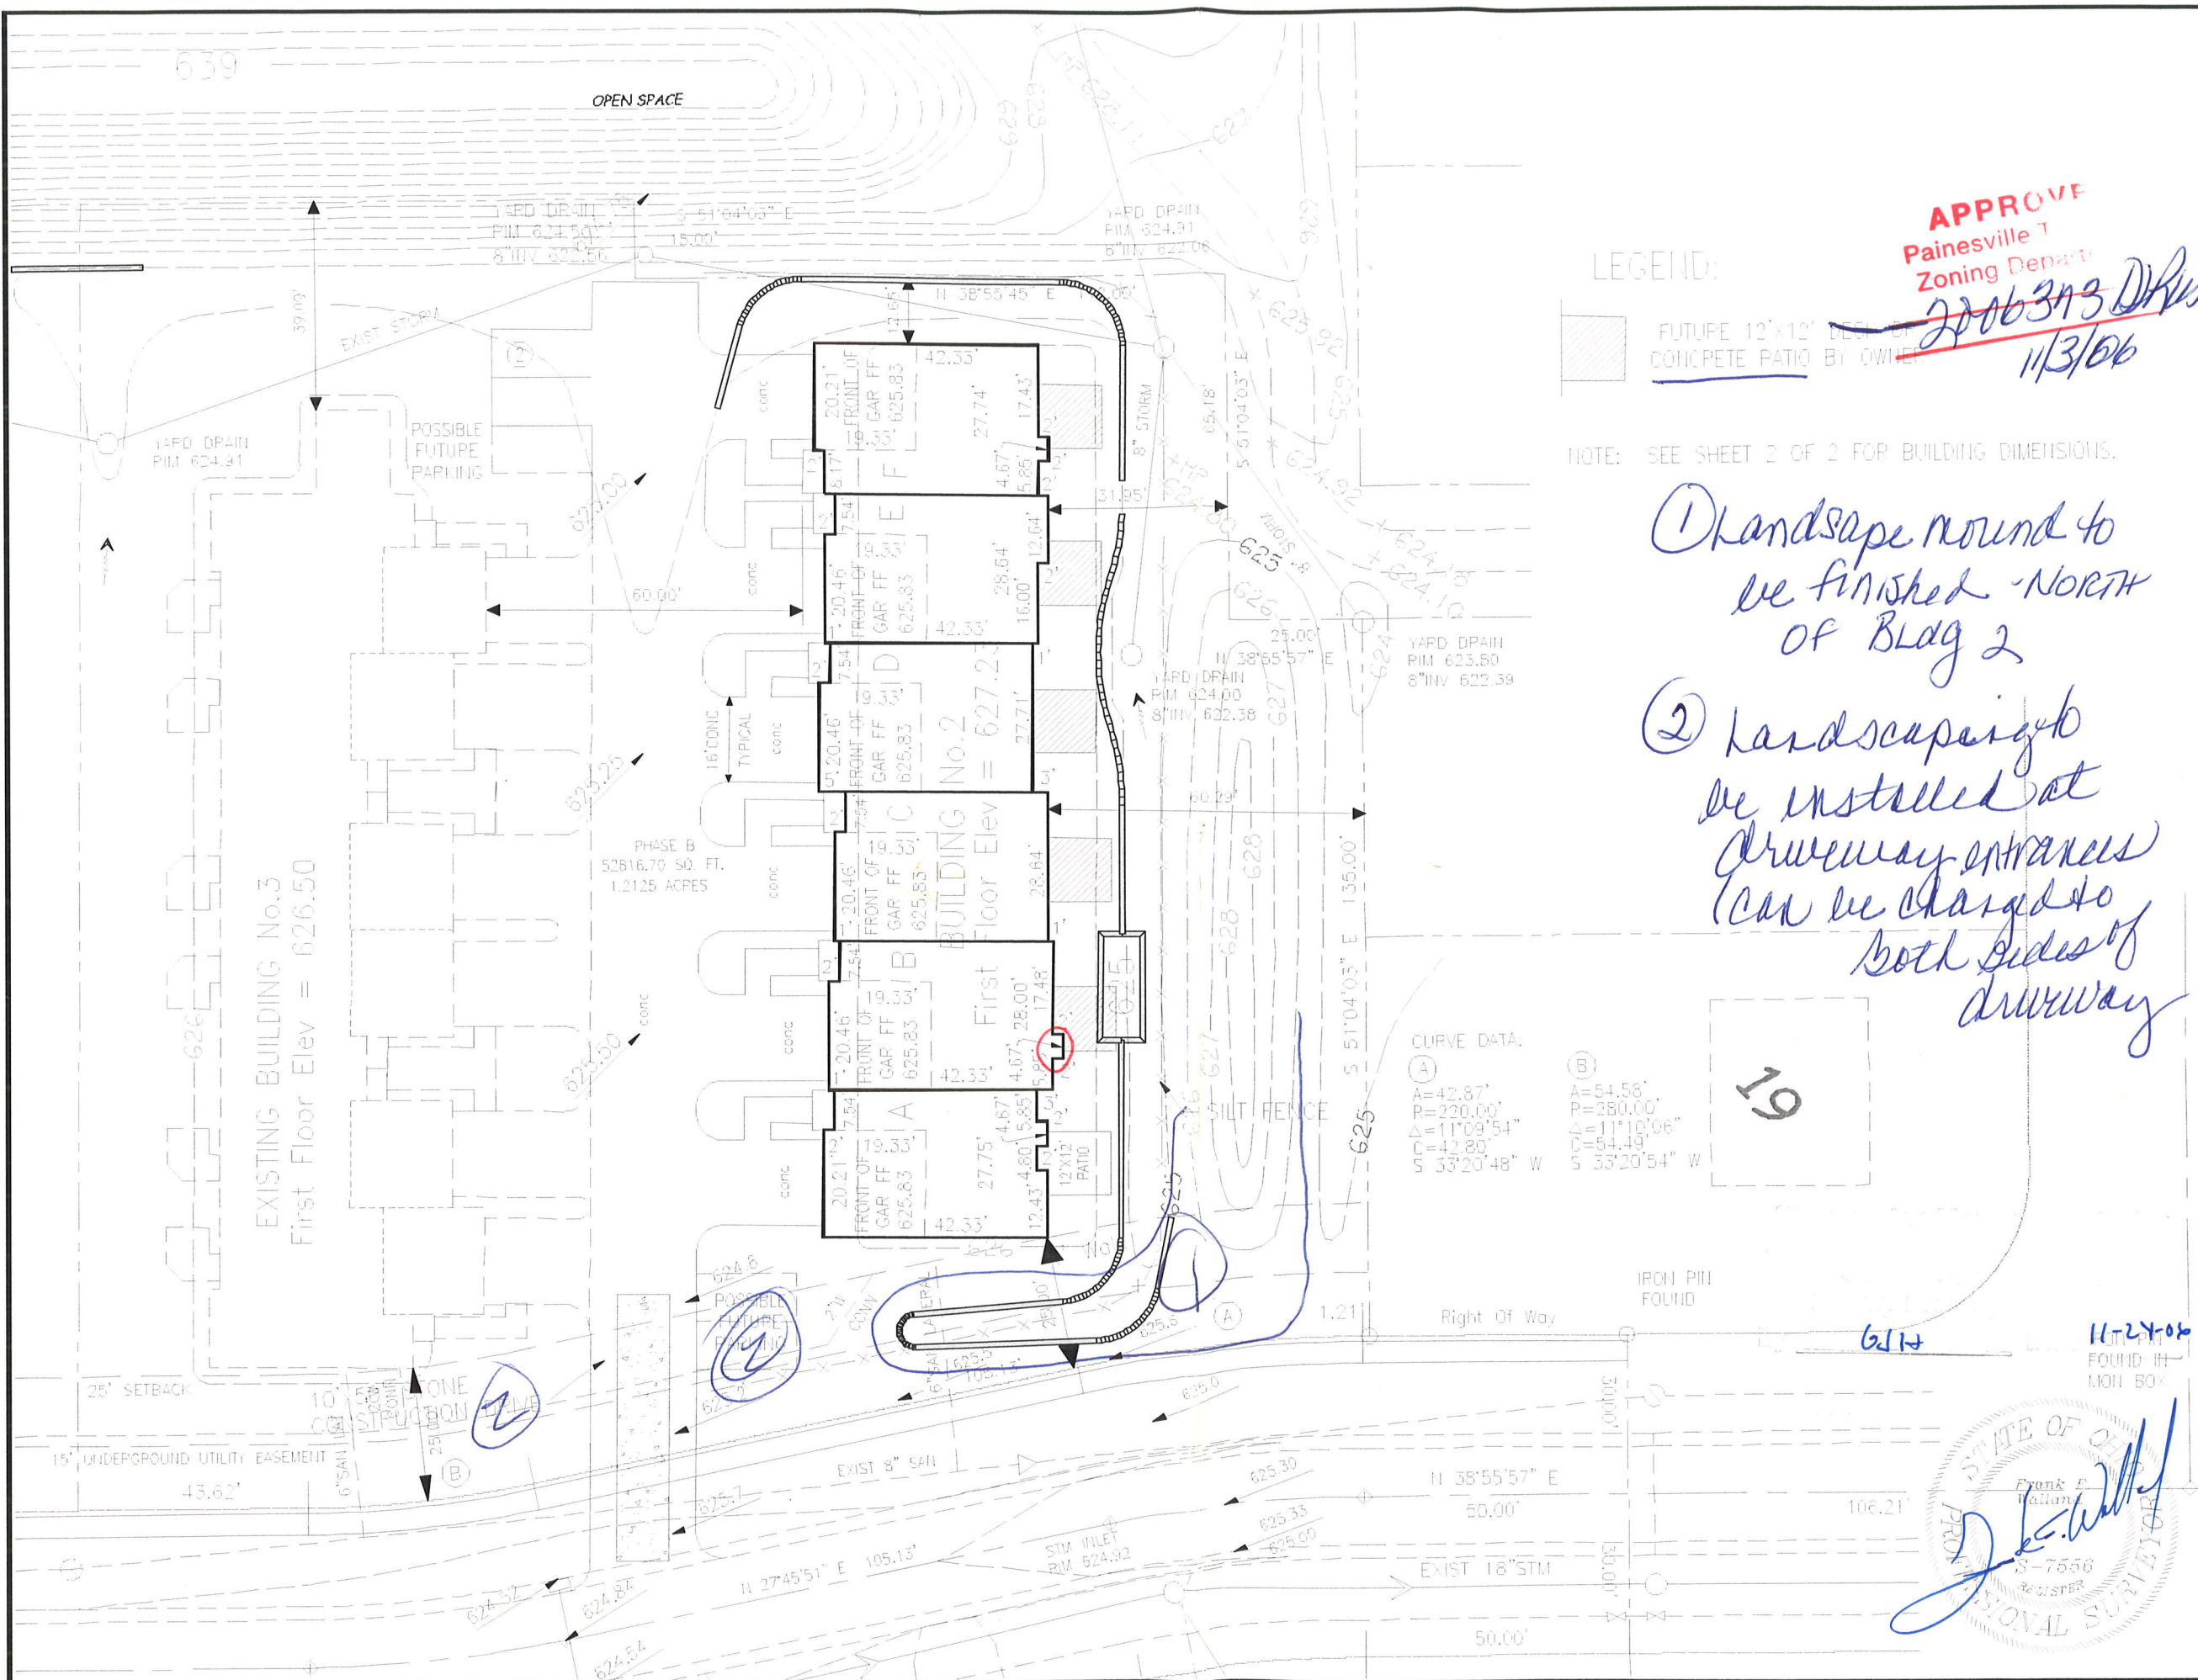

Frank E. Italian  
 PROFESSIONAL SURVEYOR  
 8-7556  
