


LEGEND

- 75 — PROPOSED GRADE
- 75 — EXISTING GRADE
- 1/4" — OVERLAND DRAINAGE

BENCH MARK - TOP OF HYDRANT
BETWEEN SUBLOTS 4 & 5
ASSUMED ELEV. = 100.00

NOTE: CONTRACTOR TO VERIFY DEPTH
OF CONNECTIONS PRIOR TO CONSTRUCTION.

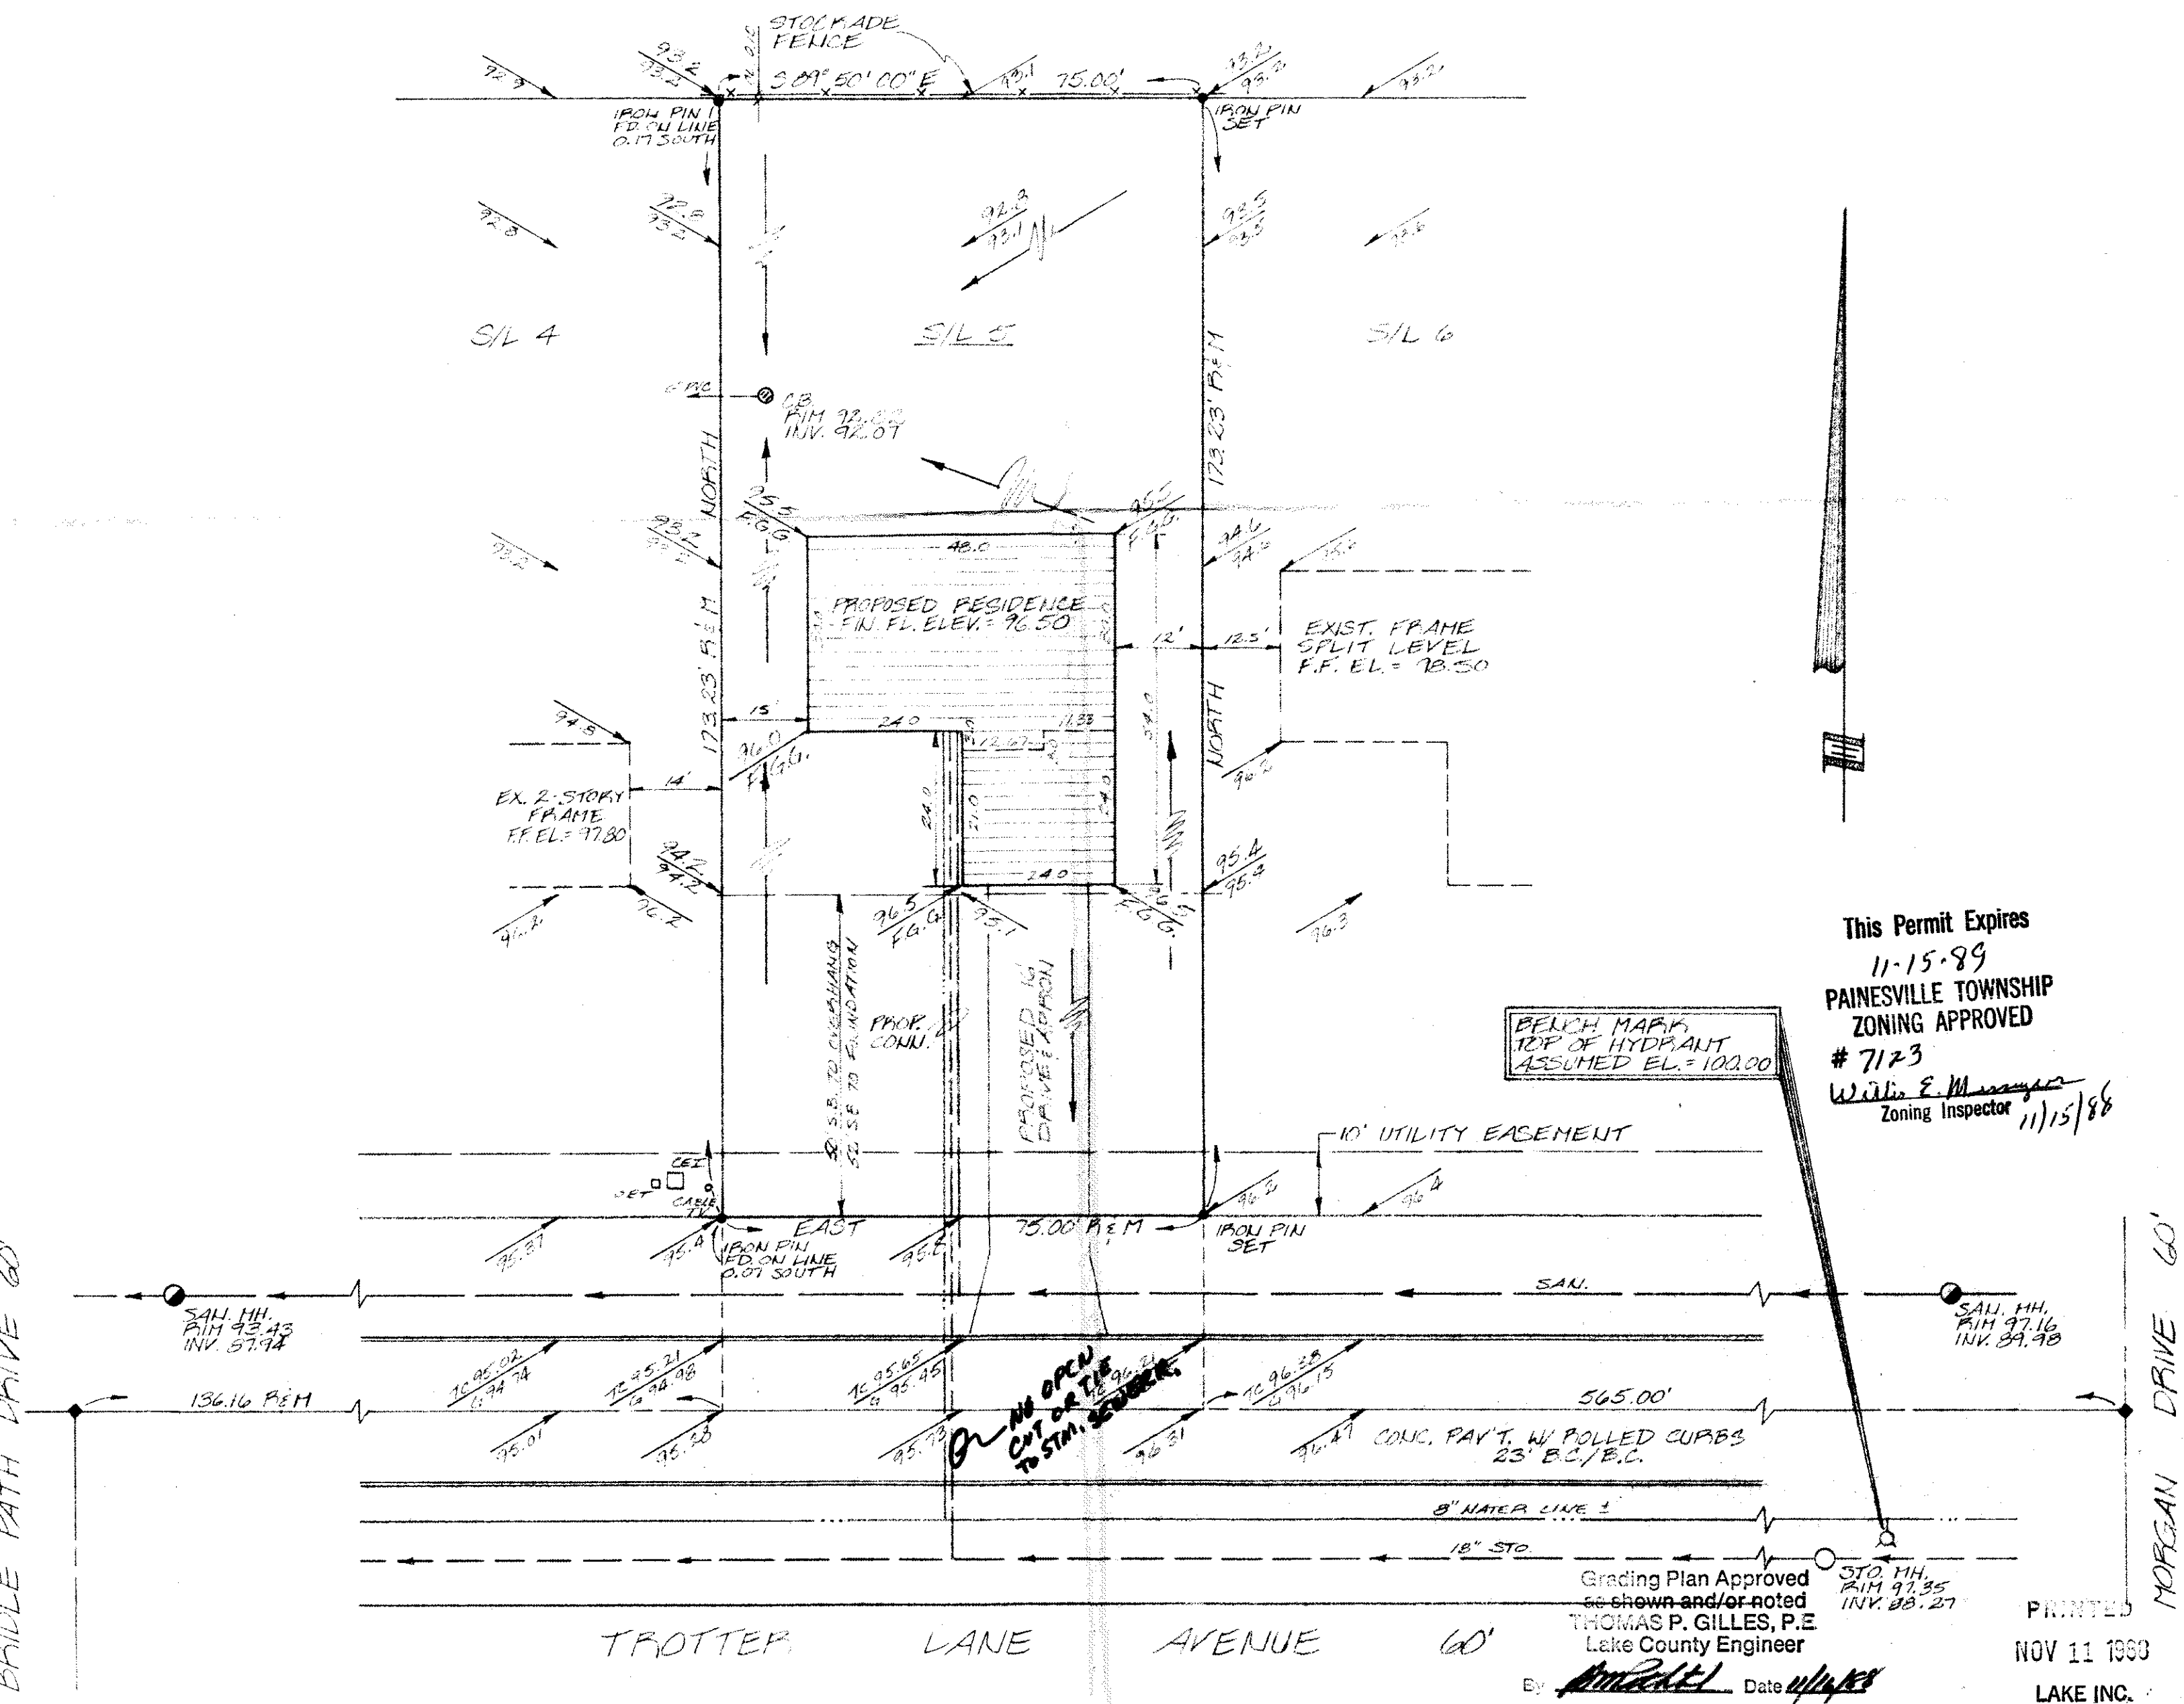


This Permit Expires
11-15-89
PAINESVILLE TOWNSHIP
ZONING APPROVED

7123
William E. Messinger
Zoning Inspector 11/15/88

Grading Plan Approved
as shown and/or noted
THOMAS P. GILLES, P.E.
Lake County Engineer

PRINTED
NOV 11 1988
LAKE INC.

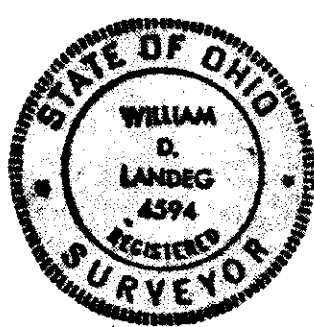

SITE PLAN for NICK PERCIVAL		
SCALE: 1" = 20'	APPROVED BY	DRAWN BY PF
DATE: NOV. 1988		
SUBLOT NO. 5 IN THE SIEPPA SUBDIVISION VOL. Y PG. 40 PAINESVILLE TOWNSHIP - LAKE COUNTY - OHIO		
LAKE INC. ENGINEERS & SURVEYORS 30601 EUCLID WICKLIFFE, OHIO		DRAWING NUMBER 88-183