



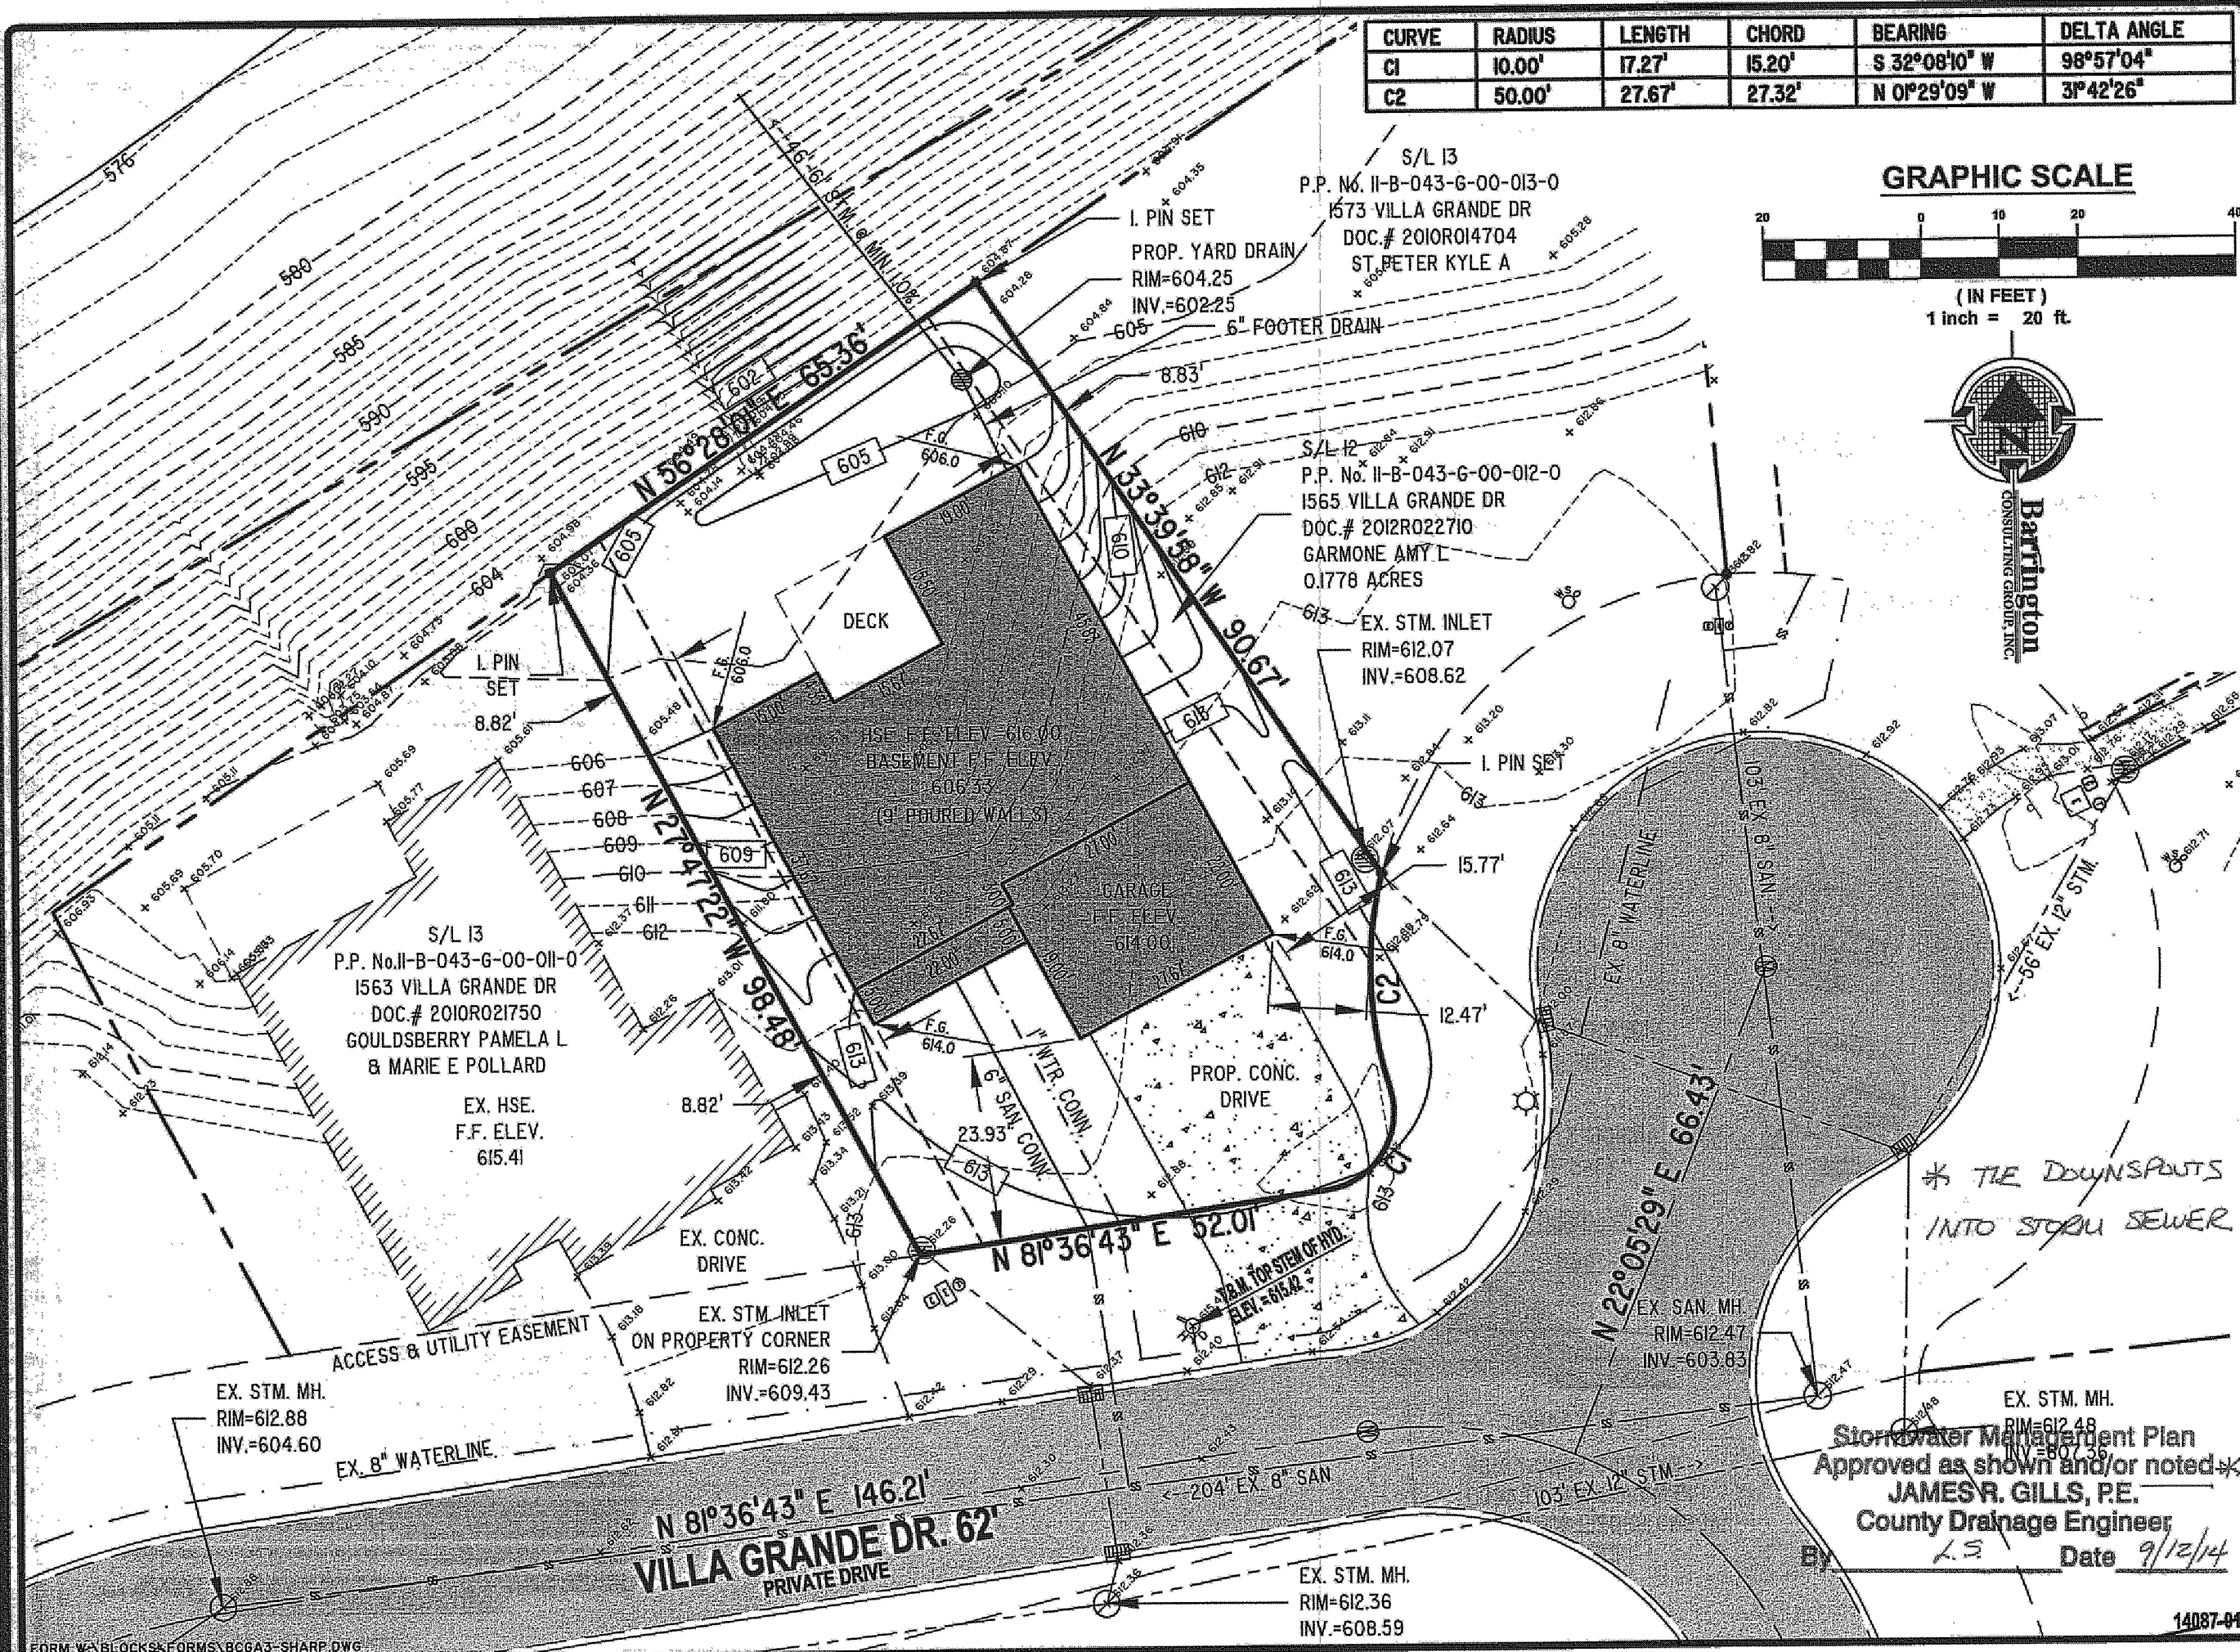

REVISIONS	BY

Barrington
CONSULTING GROUP, INC.
9114 TYLER BLVD., MENTOR, OHIO 44060
PHONE 440.205.1260 FAX 440.205.1262
www.BarringtonCGI.com

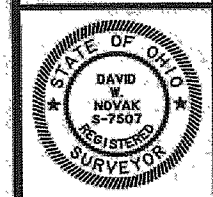

SITE PLAN
1565 VILLA GRANDE DRIVE, PAINESVILLE TWP., OHIO 44077
S/L 12 VILLA GRANDE AT LAKE ERIE SHORES VOL. 54 PG. 4
PROBUILT HOMES, INC.

DRAWN	WSO
CHECKED	DWN
DATE	AUG. 20, 2014
SCALE	1" = 20'
JOB NO.	14087-012
SHEET	3/4