


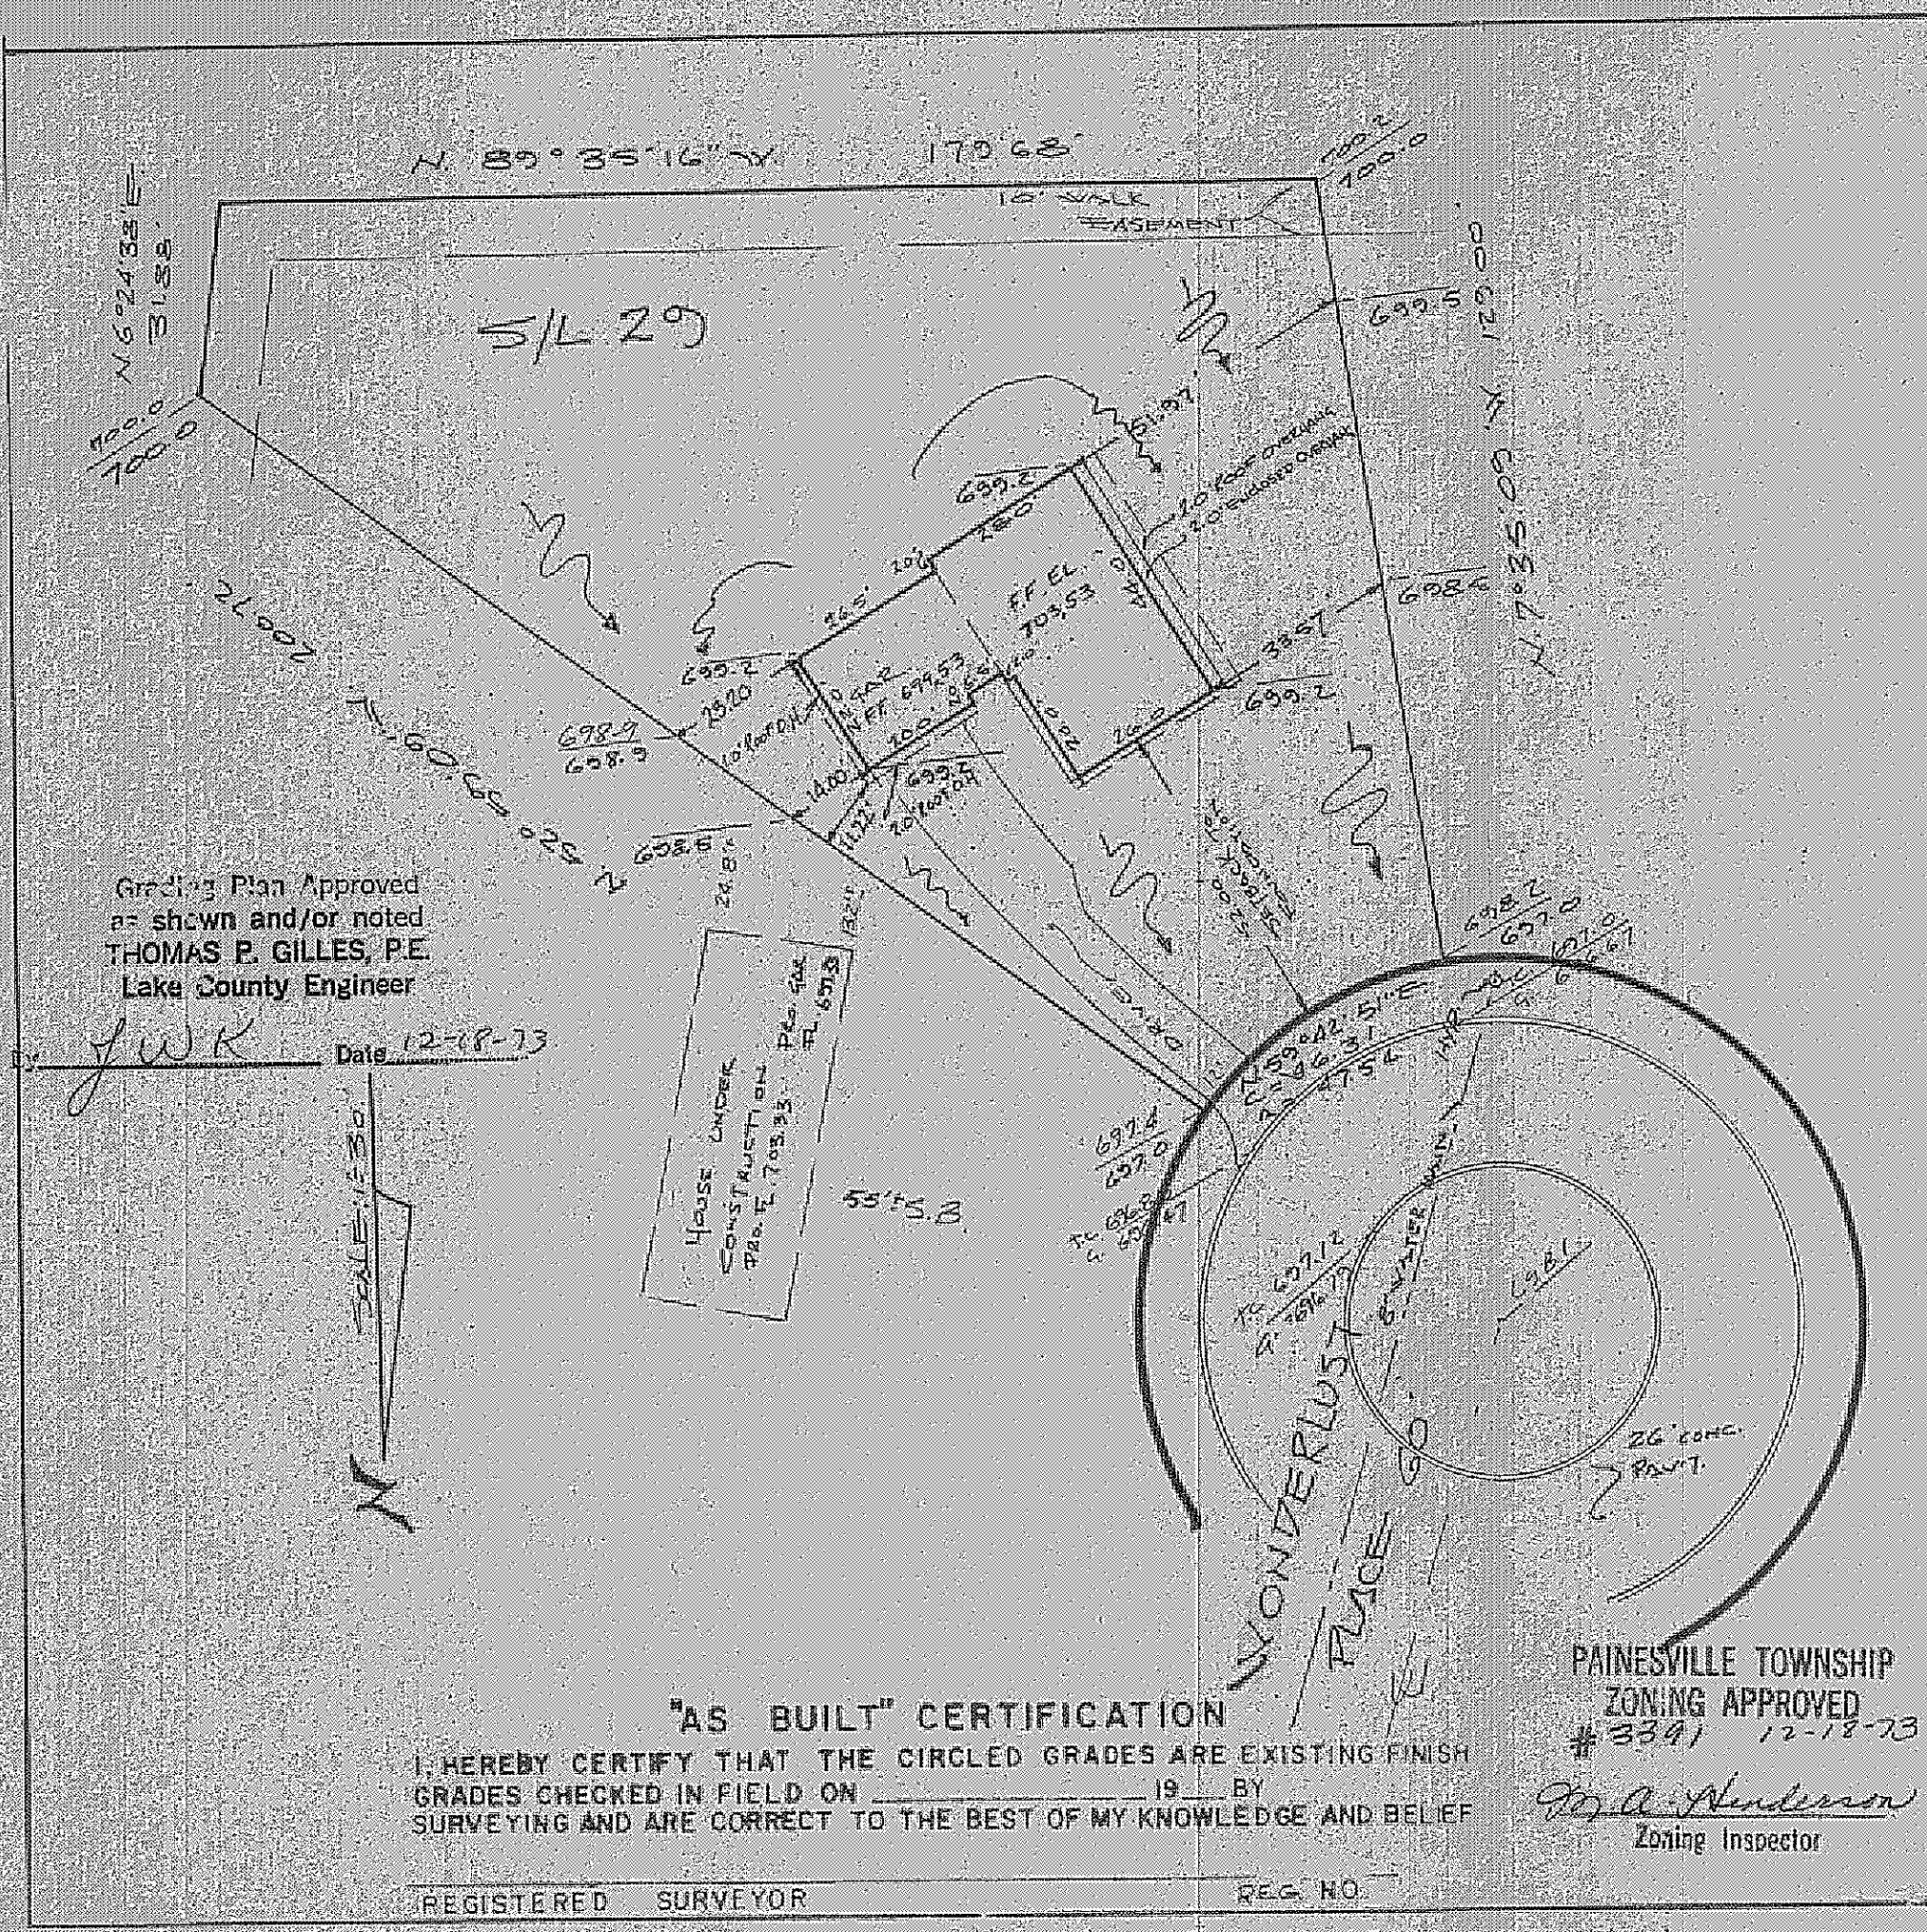

SITE PLAN			
PAINESVILLE TWP. LAKE COUNTY OHIO			
for <u>B.S.M. INC.</u>			
CLIENT		OWNER	
ADDRESS		STREET	
CITY		ZIP	
SUBJECT		STREET	
29 WONDERLUST R.		FORM PAGE	
STREET		STREET	
LEGEND			
SANITARY MANHOLE		WATER VALVE (GAS)	
STORM MANHOLE		WATER METER (GAS)	
INLET OR CATCH BASIN		AS BUILT ELEVATION	
HYDRANT		INDICATES DIRECTION OF SURFACE DRAINAGE	
EXISTING CONTOURS			
PROPOSED CONTOURS			
EXIST. ELEV.		100.02 PROP. ELEV.	
REMARKS			
ALL BOUNDARY DATA SHOWN WAS OBTAINED FROM (DEEDS RECORDED SUBDIVISION PLAT, OR OTHER PUBLIC RECORDS)			
DESIGN CERTIFICATION			
THIS PLAT WAS PREPARED BY ME, AND IS CORRECT TO THE BEST OF MY KNOWLEDGE AND BELIEF.			
NAME		SURVEYOR REGISTRATION NO.	
Richard J. Salo		PS # 5244	
CHECK LIST			
DIMENSIONS		WATER MAIN SIZE LOCATION	
BEARINGS		SAN SEWER SIZE % GR LOC	
TIE TO NEAREST STREET		SAN MH CAST ELEV INV ELEV	
SUBLOT NO. PARCEL NO		SAN CONN SIZE LOC DEPTH	
SURROUNDING OWNERS		STORM SEWER SIZE % GR LOC	
BLOG DIMENSIONS FIN GR		STORM MH CAST ELEV INV ELEV	
BLOG TIES FLA GRADES		PAVT TYPE GRADE CURBS	
APRON TYPE WIDTH THICKNESS		GAS LINE LOC SIZE PRESSURE	
SIDEWALK TYPE WIDTH THICKNESS		SEPTIC TANK SIZE LOC	
CULVERT TYPE DIA LENGTH		WELL LOCATION	
PLAN PREPARED BY:			
DEBEVEC-SALO & ASSOC, INC.			
NAME			
130 EAST JACKSON ST, PAINESVILLE			
ADDRESS			
REVISIONS		DRAWN BY	
NO DATE BY		SCALE	
1		1"=30'	
2		DATE	
3		11/NOV/73	
4		PHONE	
5		NO	
DRAWN BY		DRAFTER	
CHKD		DATE	
CREW		APPRO	
CHIEF		4073-29	
PAINESVILLE TOWNSHIP ZONING APPROVED			
#3341 12-18-73			
Zoning Inspector			
REGISTERED SURVEYOR			
REG. NO.			